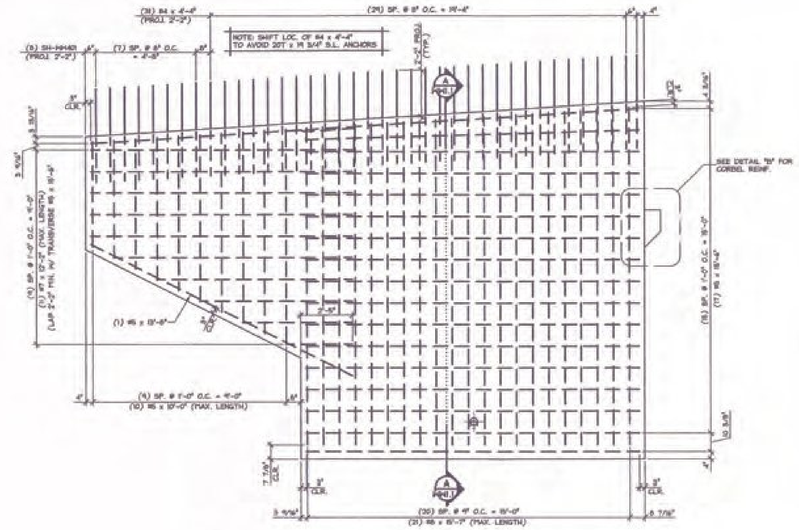

1 REINFORCING PLAN VIEW IN FORM (TOP MAT)
3/8" = 1'-0"

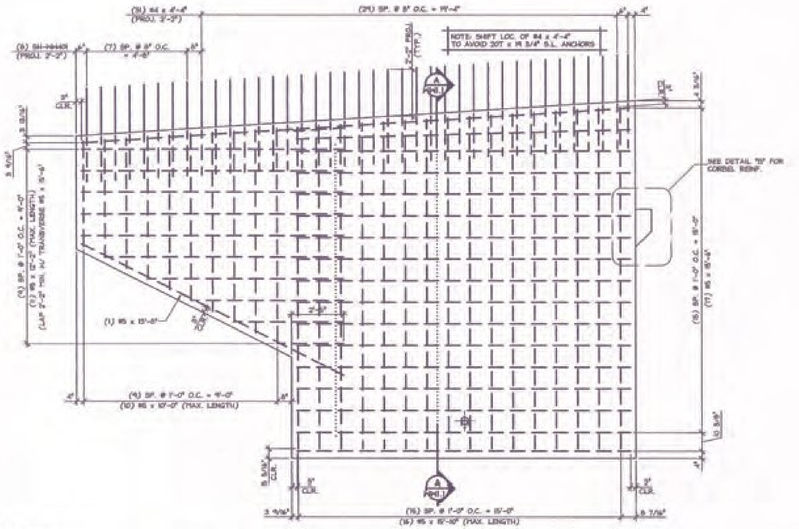

2 REINFORCING PLAN VIEW IN FORM (BOT. MAT)
3/8" = 1'-0"

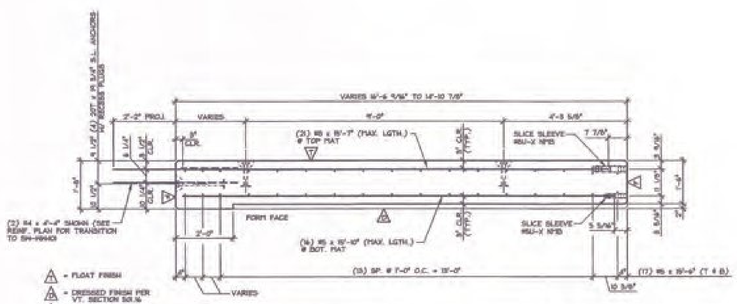

A DIMENSIONAL REINFORCING SECTION A-A
1/2" = 1'-0"

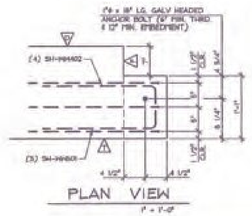

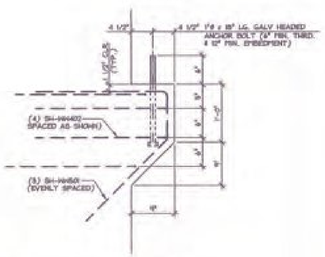

B CORBEL REINF. DETAIL
1" = 1'-0"

Vermont Agency of Transportation
RECEIVED
ON: January 28, 2014
and Checked for
CONFORMANCE
BY: Jennifer Fitch DATE: 02/04/2014

SHOP DRAWING REVIEW
X
VHB Job Number: 57438
Reviewed By: M.S. Mazar
Date: 1-31-2014

SUBMITTED
JAN 27 2014
J.P. Carrara & Sons, Inc.
Middlebury, VT 05753

MARK: SH-HW1	QTY.: 1	WT.: 39.5 T	VOL.: 19.51 cy

MATERIAL LIST / WINGWALL

ITEM	MARK	DESCRIPTION	QTY.
1		#4 x 4'-4" (LEVEL II, DUAL-COATED)	62
2		#5 x 12'-3" (LEVEL II, DUAL-COATED)	9
3		#5 x 11'-10" (LEVEL II, DUAL-COATED)	18
4		#5 x 15'-4" (LEVEL II, DUAL-COATED)	34
5		#5 x 10'-0" (LEVEL II, DUAL-COATED)	20
6		#5 x 13'-6" (LEVEL II, DUAL-COATED)	2
7		#7 x 12'-2" (LEVEL II, DUAL-COATED)	9
8		#5 x 15'-7" (LEVEL II, DUAL-COATED)	21
9			
10			
11	HW401	#4 BENT BAR (LEVEL II, DUAL-COATED)	5
12	HW402	#4 BENT BAR (LEVEL II, DUAL-COATED)	4
13	HW501	#5 BENT BAR (LEVEL II, DUAL-COATED)	3
14			
15		1"ø x 18" LG. GALV. HEADED ANCHOR BOLT	1

APPROVAL STAMP:

J.P. CARRARA & SONS INC.
Precast & Prestress Manufacturer
T. BUCK CONSTRUCTION
CONTRACTOR
AUBURN, MAINE

STATE OF VERMONT AGENCY OF TRANSPORTATION
COUNTY OF ADDISON

TOWN OF MIDDLEBURY
ROUTE NO. VT 125, EAST MIDDLEBURY GORGE
BRIDGE NO.: 13 PROJECT NO.: RS 0174(8)

P/C WINGWALL REINF. DETAILS

DATE: OCT. 9, 2013
SCALE: NOTED
CHKD: DFTM: T.P.
JOB NO: 2541I-013
DWG. NO: WW1.1

⚠ 1/27/14 GENERAL REVISION T.P.

P:\VT-Bridges\East Middlebury Gorge\25411-013 WW1.1.dwg 1/26/2014 2:13:40 PM