
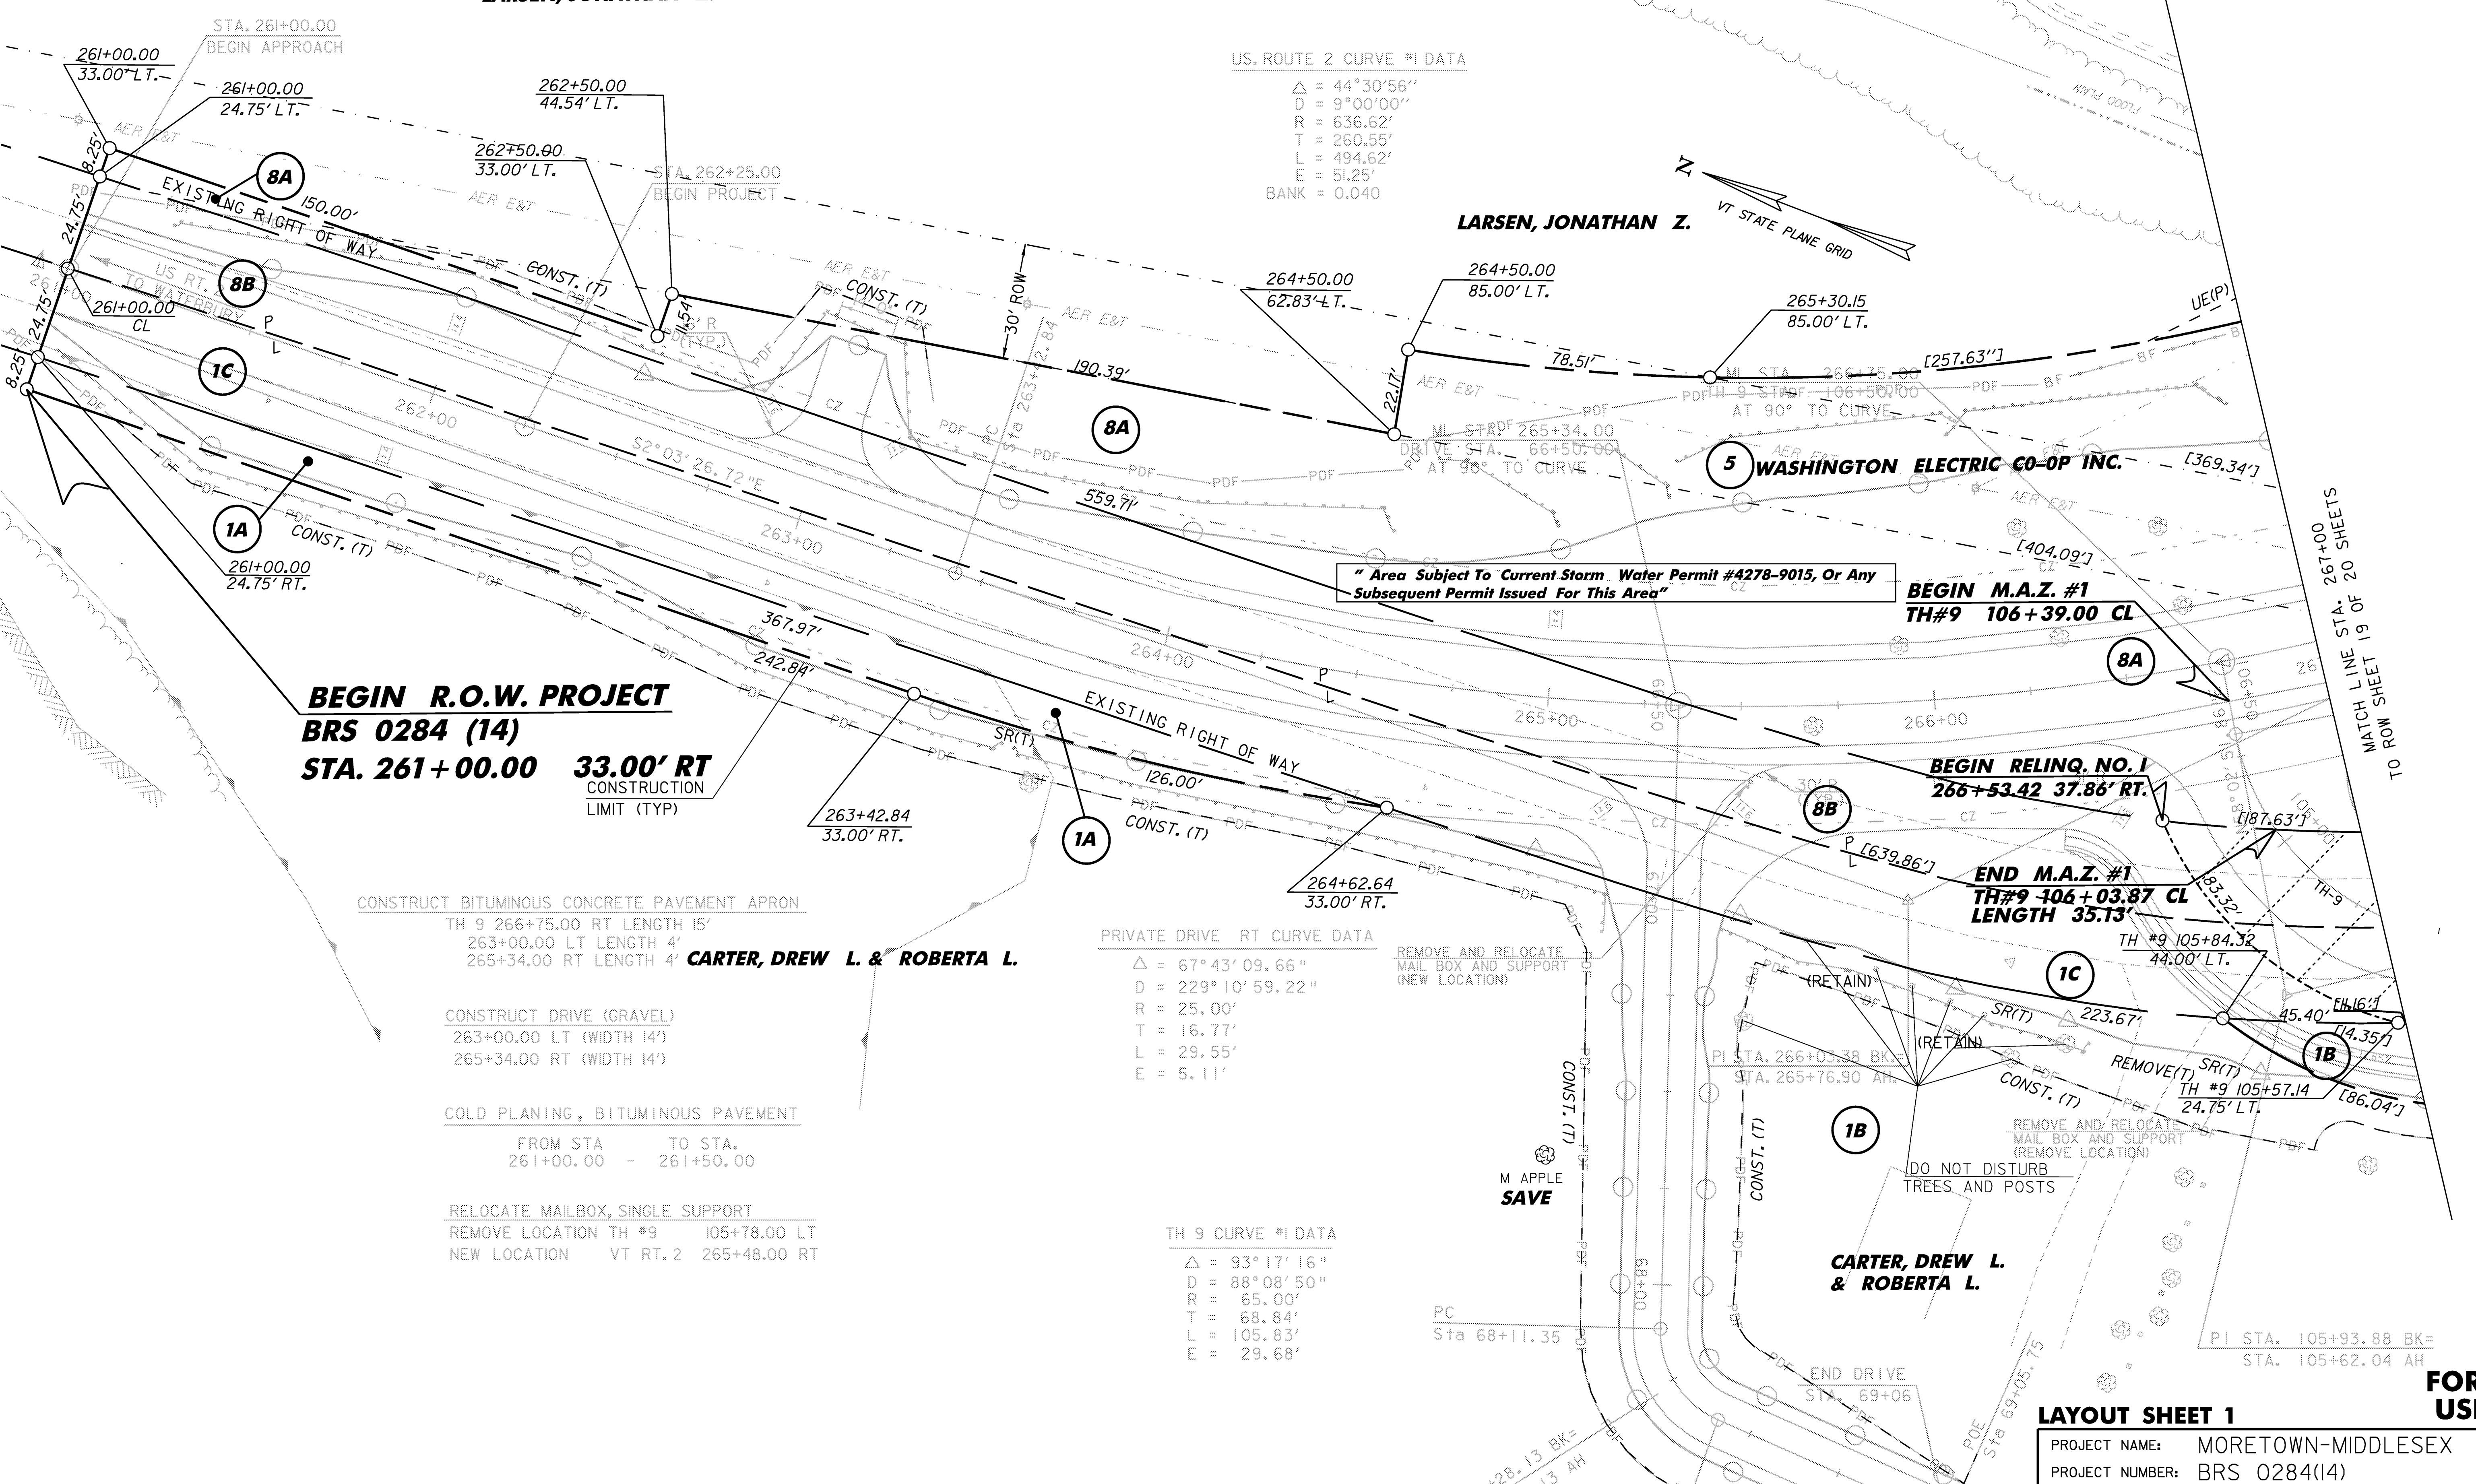


LARSEN, JOHATHAN Z.

US. ROUTE 2 CURVE #1 DATA

Δ = 44°30'56"
D = 9°00'00"
R = 636.62'
T = 260.55'
L = 494.62'
E = 51.25'
BANK = 0.040

LARSEN, JONATHAN Z.

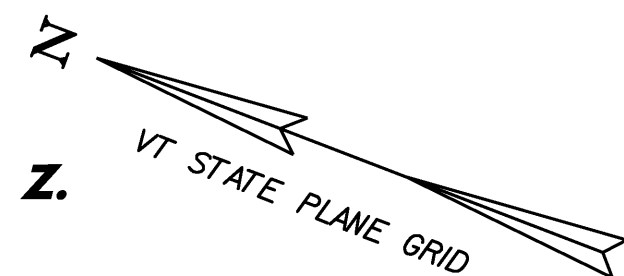

BEGIN R.O.W. PROJECT

BRS 0284 (14)

STA. 261+00.00

33.00' RT
CONSTRUCTION
LIMIT (TYP)

CONSTRUCT BITUMINOUS CONCRETE PAVEMENT APRON

TH 9 266+75.00 RT LENGTH 15'
263+00.00 LT LENGTH 4'
265+34.00 RT LENGTH 4'

CARTER, DREW L. & ROBERTA L.

CONSTRUCT DRIVE (GRAVEL)

263+00.00 LT (WIDTH 14')
265+34.00 RT (WIDTH 14')

COLD PLANING, BITUMINOUS PAVEMENT

FROM STA TO STA.
261+00.00 - 261+50.00

RELOCATE MAILBOX, SINGLE SUPPORT

REMOVE LOCATION TH #9 105+78.00 LT
NEW LOCATION VT RT.2 265+48.00 RT

PRIVATE DRIVE RT CURVE DATA

Δ = 67°43'09.66"
D = 229°10'59.22"
R = 25.00'
T = 16.77'
L = 29.55'
E = 5.11'

REMOVE AND RELOCATE
MAIL BOX AND SUPPORT
(NEW LOCATION)

TH 9 CURVE #1 DATA

Δ = 93°17'16"
D = 88°08'50"
R = 65.00'
T = 68.84'
L = 105.83'
E = 29.68'

BEGIN M.A.Z. #1
TH#9 106+39.00 CL

BEGIN RELINQ. NO. 1
266+53.42 37.86' RT.

END M.A.Z. #1
TH#9 106+03.87 CL
LENGTH 35.13'

TH #9 105+84.32
44.00' LT.

TH #9 105+57.14
24.75' LT.

MATCH LINE STA. 267+00
TO ROW SHEET 19 OF 20 SHEETS

"Area Subject To Current Storm Water Permit #4278-9015, Or Any
Subsequent Permit Issued For This Area"

CARTER, DREW L.
& ROBERTA L.

M APPLE
SAVE

DO NOT DISTURB
TREES AND POSTS

FOR R.O.W.
USE ONLY

LAYOUT SHEET 1

PROJECT NAME: MORETOWN-MIDDLESEX

PROJECT NUMBER: BRS 0284(14)

FILE NAME: 78f219\structures\78f219bdr.dgn PLOT DATE: 15-JUN-2009

PROJECT LEADER: M. Evans-Mongeeon

DRAWN BY: L. DUQUETTE

DESIGNED BY: S.SCRIBNER

CHECKED BY: S. SCRIBNER

R.O.W. SHEET 18 OF 20 SHEETS

SHEET 77 OF 103

