1. NEW CPEPES/CAAPES/PCCSPES
DIAMETER = 18"

2. NEW CPEP/CAAP/PCCSP
DIAMETER = 18"
LENGTH = 56'-0"

3. NEW CPEPES/CAAPES/PCCSPES
DIAMETER = 18"

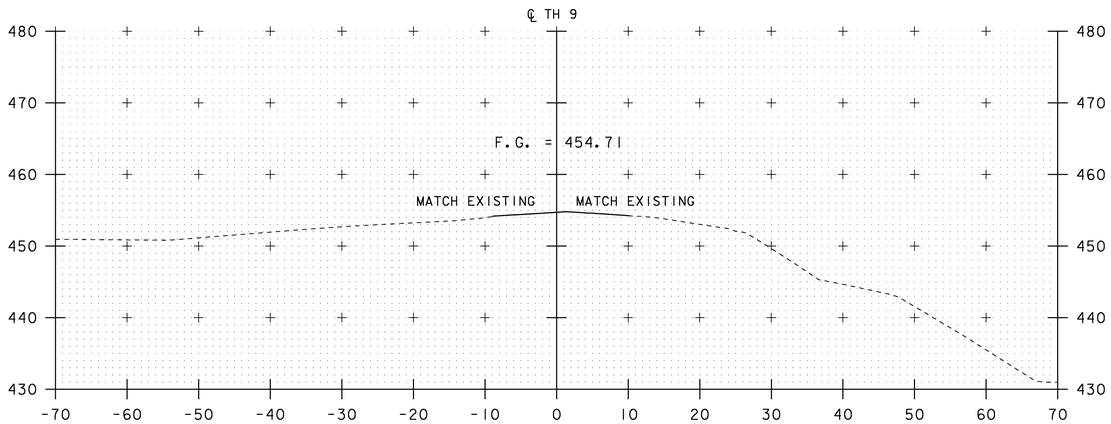

103+17

BEGIN TH#9 CONSTRUCTION STA. 103+16.75

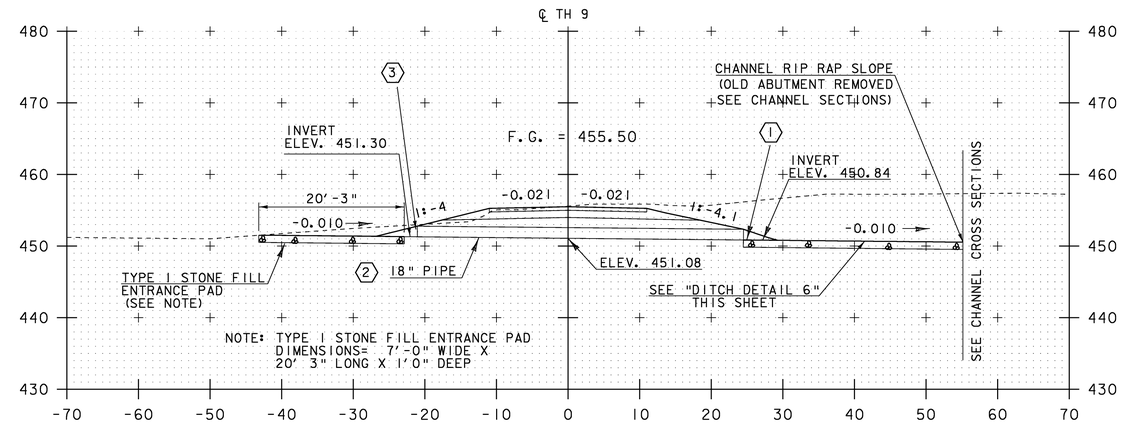

103+50

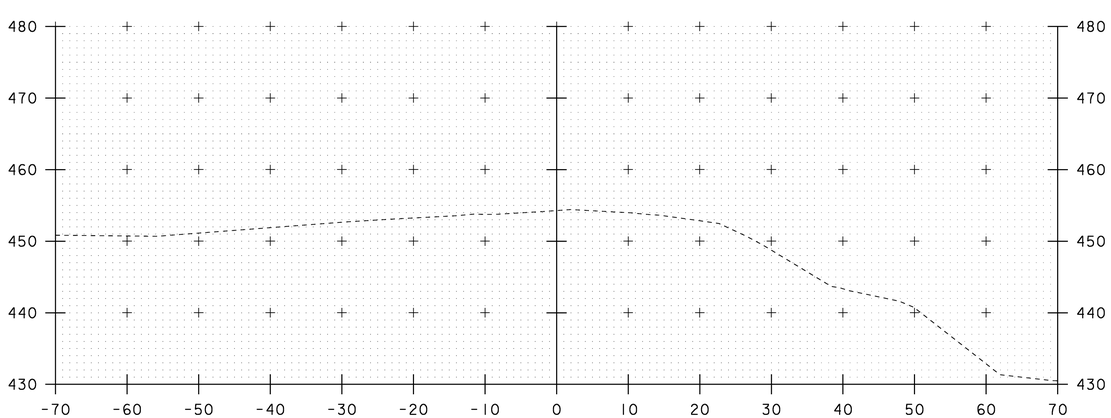

103+00

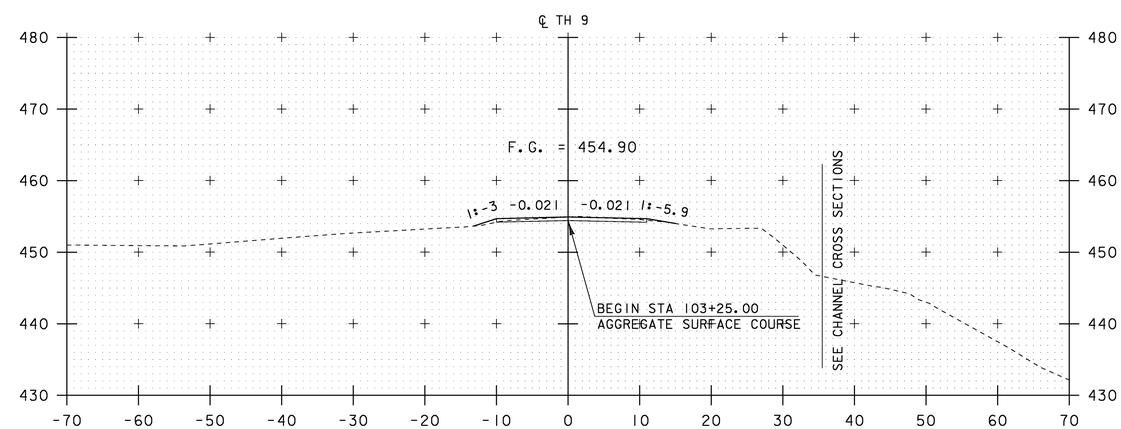

103+25

NOTE: DITCH OFFSET IS MEASURED FROM THE CENTERLINE OF TH 9 TO CENTER OF DITCH

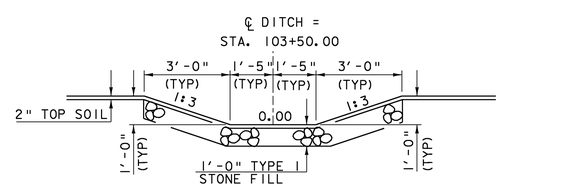

DITCH DETAIL 6

STA. 103+50.00 ~ 29.22'RT
TO STA. 103+50.00 ~ 55.10' RT

NTS

SCALE 1" = 10'-0
10 0 10

STA. 103+17 TO STA. 103+50

TH 9 CROSS SECTION SHEET #1

PROJECT NAME: MORETOWN-MIDDLESEX	
PROJECT NUMBER: BRS 0284(14)	
FILE NAME: 78f219/str/s78f219xs3.dgn	PLOT DATE: 15-JUN-2009
PROJECT LEADER: M. Evans-Mongeon	DRAWN BY: G. ROKES
DESIGNED BY: G. ROKES	CHECKED BY: S. SCRIBNER
IPARM: s78f2191xsl.1	SHEET 99 OF 103