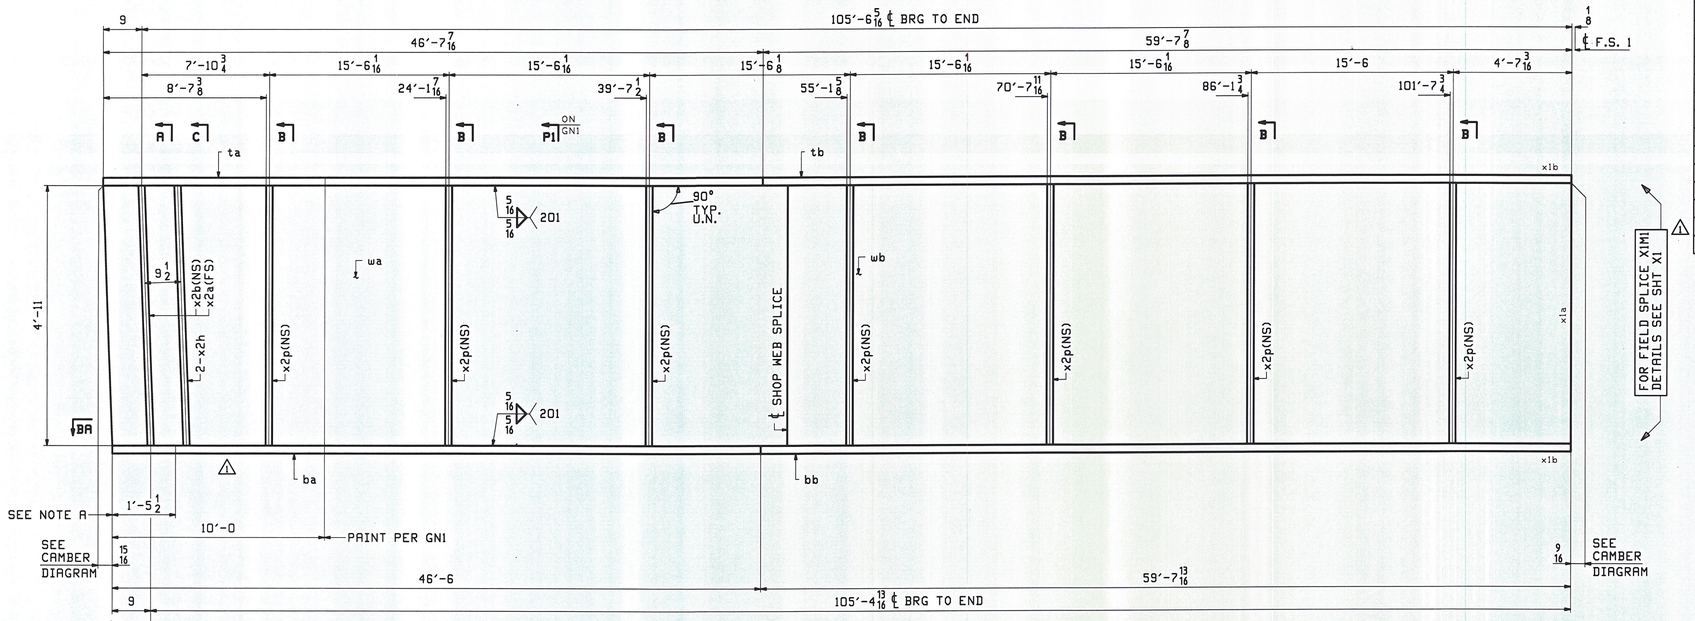

ABM INFO		SHIP	BILL OF MATERIAL					JOB NO.	DRAWING NO.	REV.
									1	
PAGE	LINE	MARK	QTY	MARK	MATERIAL	LENGTH FT	LENGTH INCHES	REMARKS	WT	PROCUREMENT NOTES
		1G1A	1		GIRDER				27126	
1	N		1	wa	PL 3/4×59	47	8 7/16	M270-50WT2 (H2-3)		
1	L		1	wb	PL 3/4×59	58	8 7/8	M270-50WT2 (H2-3)		
1	G		1	ta	PL 7/8×16	46	7 7/16	M270-50WT2 (H2-3)		
1	E		1	tb	PL 7/8×16	59	7 7/8	M270-50WT2 (H2-3)		
1	G		1	ba	PL 7/8×16	46	6	M270-50WT2 (H2-3)		
1	E		1	bb	PL 7/8×16	59	7 13/16	M270-50WT2 (H2-3)		
2	H		1	x2a	PL 3/4×8 1/2	4	11	MIE BEV		
2	H		1	x2b	PL 3/4×8 1/2	4	11	MIE BEV		
2	J		2	x2h	PL 3/4×7	4	11	MIE		
2	M		7	x2p	PL 3/4×7	4	11			

ONE - GIRDER - 1G1A

FOR FIELD SPLICE & STANDARD DETAILS SEE X SHEETS
FOR CAMBER & FLANGE DIAGRAM SEE SHEET C1
FOR GENERAL NOTES SEE SHEET GN1

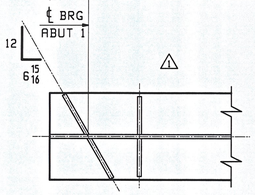

SECTION BA

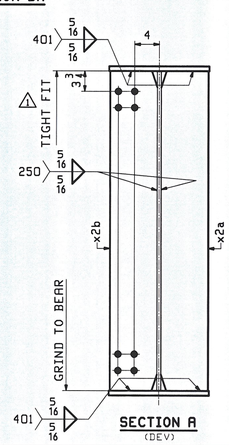

SECTION A
(DEV)

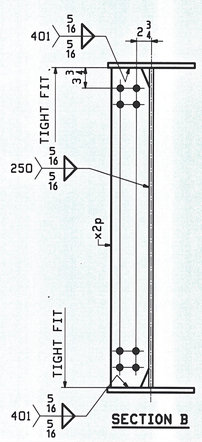

SECTION B

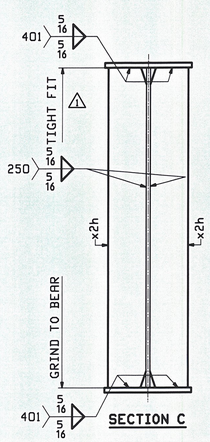

SECTION C

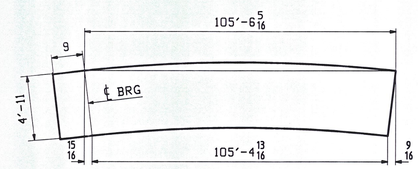

ORIENTATION DIAGRAM

NOTE A:
NO PAINT BOTTOM AND EDGES OF BOTTOM FLANGE.

REV.	DATE	REMARKS	DWN	CHK	APVL	SHOP
1	10/19	REVISED PER APPROVAL	WJF	PCP	NOV 02 2009	
0					AUG 27 2009	

MATERIAL:	SURFACE PREP. & PAINT:	HOLES:	SHOP BOLTS:
M270-50W (UN)	SEE GN1	15/16"Ø U.N.	NONE

DESCRIPTION: GIRDER - 1G1A

CASCO BAY STEEL STRUCTURES, INC.
75 SPRING HILL ROAD SACO, MAINE 04072
PHONE (207) 282-7360 FAX. (207) 282-1179
TENSOR 2005

STRUCTURE: US RTE 2 OVER WINOOSKI RIVER WASHINGTON COUNTY, VT	DRAWN: WJF	DATE: 08/12	
	CHKD: PCP	DATE: 08/17	
LOCATION: TOWNS OF MORETOWN ~ MIDDLESEX, VT	JOB NO.	DWG NO.	
PROJ NO. BRS 0284(14)	421-1	1	
CUSTOMER: WINTERSET INC.		REV. 1	

RECEIVED NOV 05 2009 SSS ORD BY
11/5/09

PCP Mon, Oct 19, 2009 09:26 AM /users/pbar/2006/1 Rev1