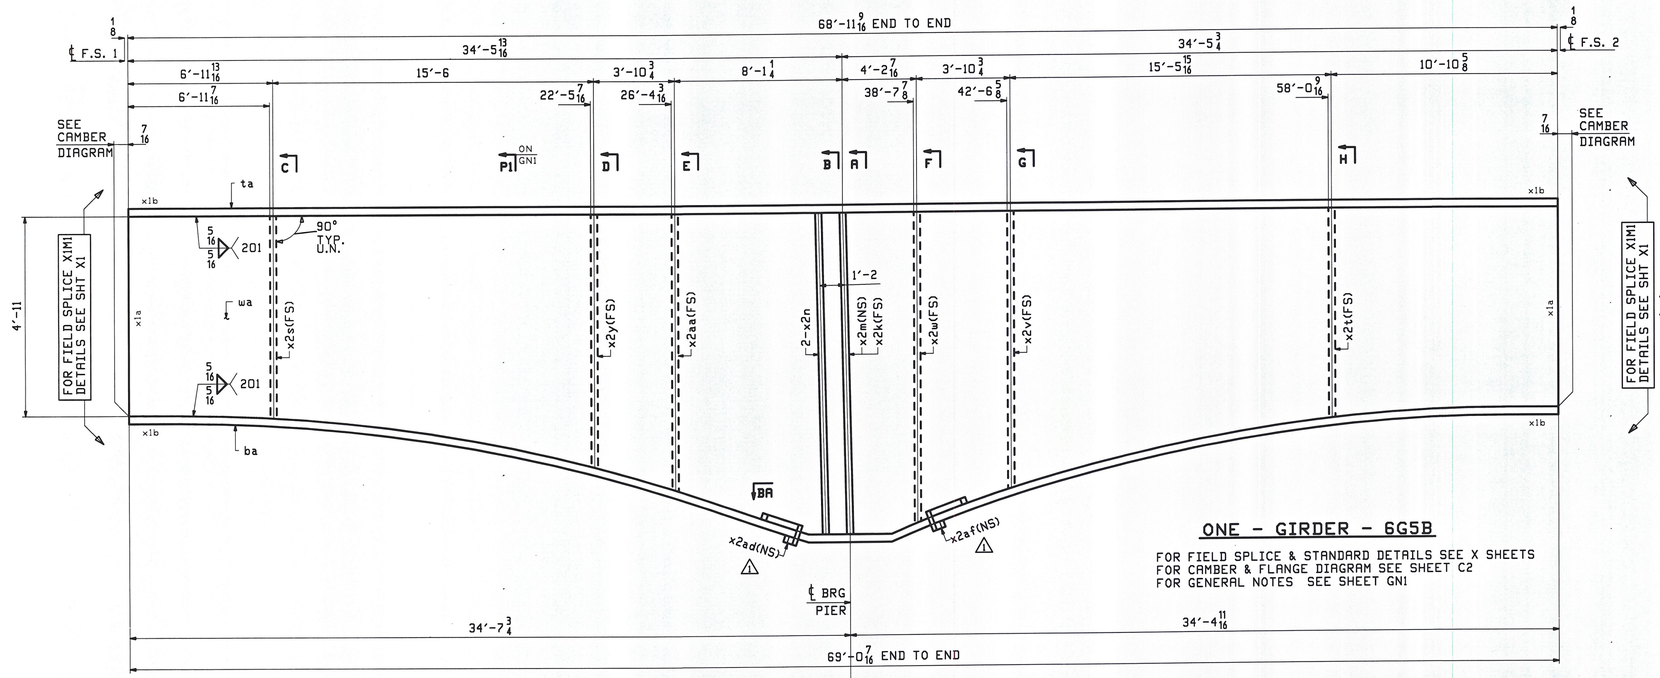

ONE - GIRDER - 6G5B

FOR FIELD SPLICE & STANDARD DETAILS SEE X SHEETS
FOR CAMBER & FLANGE DIAGRAM SEE SHEET C2
FOR GENERAL NOTES SEE SHEET GN1

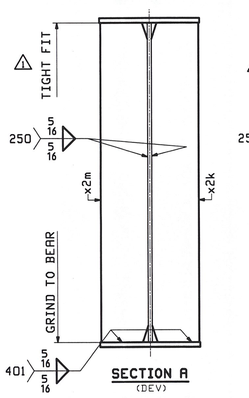

SECTION A
(DEV)

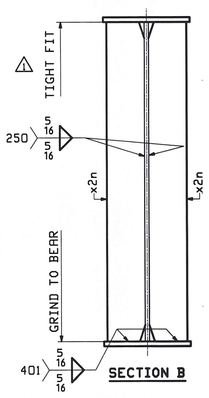

SECTION B

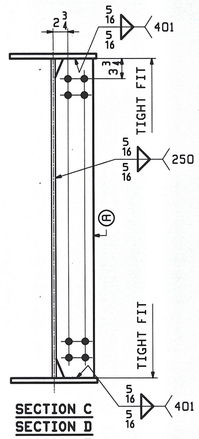

SECTION C
SECTION D
SECTION E
SECTION F
SECTION G
SECTION H

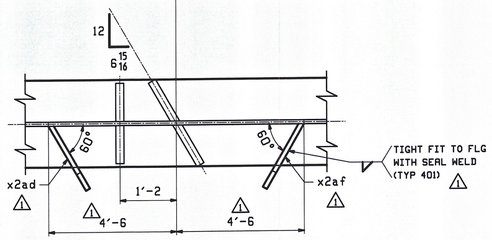

SECTION BA

SECTION	Ⓐ
C	x2s
D	x2y
E	x2aa
F	x2w
G	x2v
H	x2t

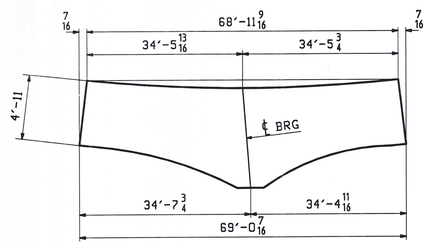

ORIENTATION DIAGRAM

ABM INFO		SHIP	BILL OF MATERIAL						JOB NO.	DRAWING NO.	REV.
										6	
PAGE	LINE	MARK	QTY	MARK	MATERIAL	LENGTH FT	LENGTH INCHES	REMARKS	WT	PROCUREMENT NOTES	
		6G5B	1		GIRDER				26203		
1	J		1	wa	PL 3/4 x 95	69	0 7/16	M270-50WT2 (H2-3)			
1	C		1	ta	PL 1x16	68	11 9/16	M270-50WT2 (H2-3)			
1	A		1	ba	PL 1x16	69	9 1/4	M270-50WT2 (H2-3)			
2	K		1	x2k	PL 1 1/2 x 8 1/2	7	11 1/16	MIE BEV			
2	K		1	x2m	PL 1 1/2 x 8 1/2	7	11 1/16	MIE BEV			
2	L		2	x2n	PL 1 1/2 x 7	7	11	MIC			
2	N		1	x2s	PL 3/4 x 7	4	11 13/16				
2	N		1	x2t	PL 3/4 x 7	5	1 13/16				
2	Q		1	x2v	PL 3/4 x 7	6	9 13/16				
2	R		1	x2w	PL 3/4 x 7	7	5 7/8				
2	P		1	x2y	PL 3/4 x 7	6	3				
2	Q		1	x2aa	PL 3/4 x 7	6	9 13/16				
2	V		1	x2ad	PL 1/4 x 3	0	11				
2	V		1	x2af	PL 1/4 x 3	0	11				

REV.	DATE	REMARKS	DWN	CHK	APVL	SHOP
1	10/19	REVISED PER APPROVAL	WJF	PCP	AUG 0 2 2009	
0					AUG 2 7 2009	

RECEIVED
OK'D BY SSS OK'D BY
NOV 05 2009
11/5/09

MATERIAL:	SURFACE PREP. & PAINT:	HOLES:	SHOP BOLTS:
M270-50W (UN)	SEE GN1	15/16"Ø U.N.	NONE

DESCRIPTION: GIRDER - 6G5B

CASCO BAY STEEL STRUCTURES, INC.
75 SPRING HILL ROAD SACO, MAINE 04072
PHONE (207) 282-7360 FAX. (207) 282-1179
TENSOR 2906

STRUCTURE: US RTE 2 OVER WINOOSKI RIVER WASHINGTON COUNTY, VT	DRAWN: WJF	DATE: 08/13
	CHKD: PCP	DATE: 08/17
LOCATION: TOWNS OF MORETOWN ~ MIDDLESEX, VT	JOB NO.	DWG NO.
PROJ NO. BRS 0284(14)	421-1	6
CUSTOMER: WINTERSET INC.		REV. 1

PCP Mon, Oct 19, 2009 08:46:54 AM /casco/jobs/2906/6 (.dwg)