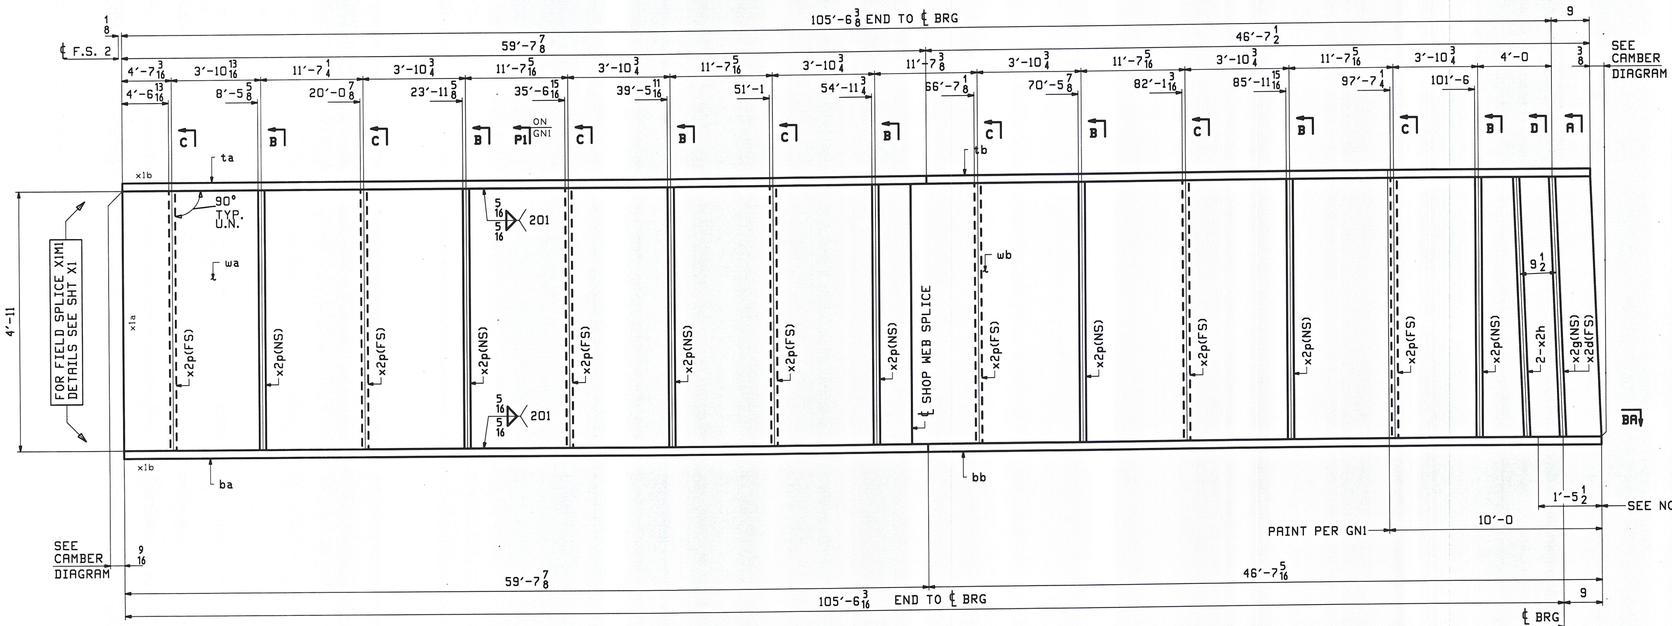

ABM INFO		SHIP	BILL OF MATERIAL					JOB NO.	DRAWING NO.	REV.
									8	
PAGE	LINE	MARK	QTY	MARK	MATERIAL	LENGTH FT	LENGTH INCHES	REMARKS	WT	PROCUREMENT NOTES
		8G2C	1		GIRDER				27757	
		8G3C	1		GIRDER				27757	
		8G4C	1		GIRDER				27757	
1	L		3	wa	PL 3/4 x59	58	6 7/8	M270-50WT2 (H2-3)		
1	N		3	wb	PL 3/4 x59	47	9 1/4	M270-50WT2 (H2-3)		
1	E		3	ta	PL 7/8 x16	59	7 7/8	M270-50WT2 (H2-3)		
1	G		3	tb	PL 7/8 x16	46	7 1/2	M270-50WT2 (H2-3)		
1	E		3	ba	PL 7/8 x16	59	7 7/8	M270-50WT2 (H2-3)		
1	G		3	bb	PL 7/8 x16	46	7 5/16	M270-50WT2 (H2-3)		
2	H		3	x2d	PL 3/4 x8 1/2	4	11 1/16	MIC BEV		
2	H		3	x2g	PL 3/4 x8 1/2	4	11 1/16	MIC BEV		
2	J		6	x2h	PL 3/4 x7	4	11	MIC		
2	M		42	x2p	PL 3/4 x7	4	11			

ONE - GIRDER - 8G2C
ONE - GIRDER - 8G3C
ONE - GIRDER - 8G4C
} ALIKE EXCEPT FOR MARKS

FOR FIELD SPLICE & STANDARD DETAILS SEE X SHEETS
FOR CAMBER & FLANGE DIAGRAM SEE SHEET C3
FOR GENERAL NOTES SEE SHEET GN1

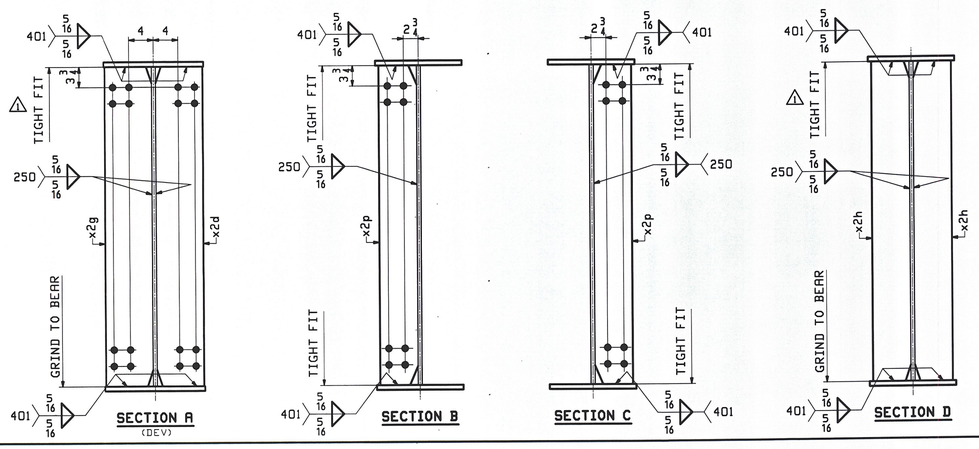

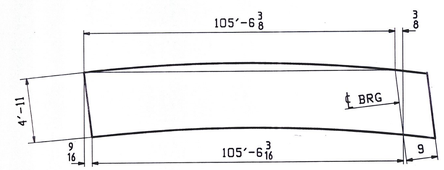

ORIENTATION DIAGRAM

NOTE A:
NO PAINT BOTTOM AND EDGES OF BOTTOM FLANGE.

RECEIVED NOV 15 2009 11/5/09

REV.	DATE	REMARKS	DWN	CHK	APVL	SHOP
1	10/19	REVISED PER APPROVAL	WJF	PCP	NOV 02 2009	
0					AUG 27 2009	

MATERIAL:	SURFACE PREP. & PAINT:	HOLES:	SHOP BOLTS:
M270-50W (UN)	SEE GN1	15/16 ø U.N.	NONE

DESCRIPTION: GIRDERS - 8G3C, 8G3C, 8G4C

CASCO BAY STEEL STRUCTURES, INC.
75 SPRING HILL ROAD SACO, MAINE 04072
PHONE (207) 282-7360 FAX. (207) 282-1179
TENSOR 2906

STRUCTURE: US RTE 2 OVER WINOOSKI RIVER WASHINGTON COUNTY, VT	DRAWN: WJF	DATE: 08/13
	CHKD: PCP	DATE: 08/17
LOCATION: TOWNS OF MORETOWN ~ MIDDLESEX, VT	JOB NO.	DWG NO.
PROJ NO. BRS 0284(14)	421-1	8
CUSTOMER: WINTERSET INC.		REV. 1