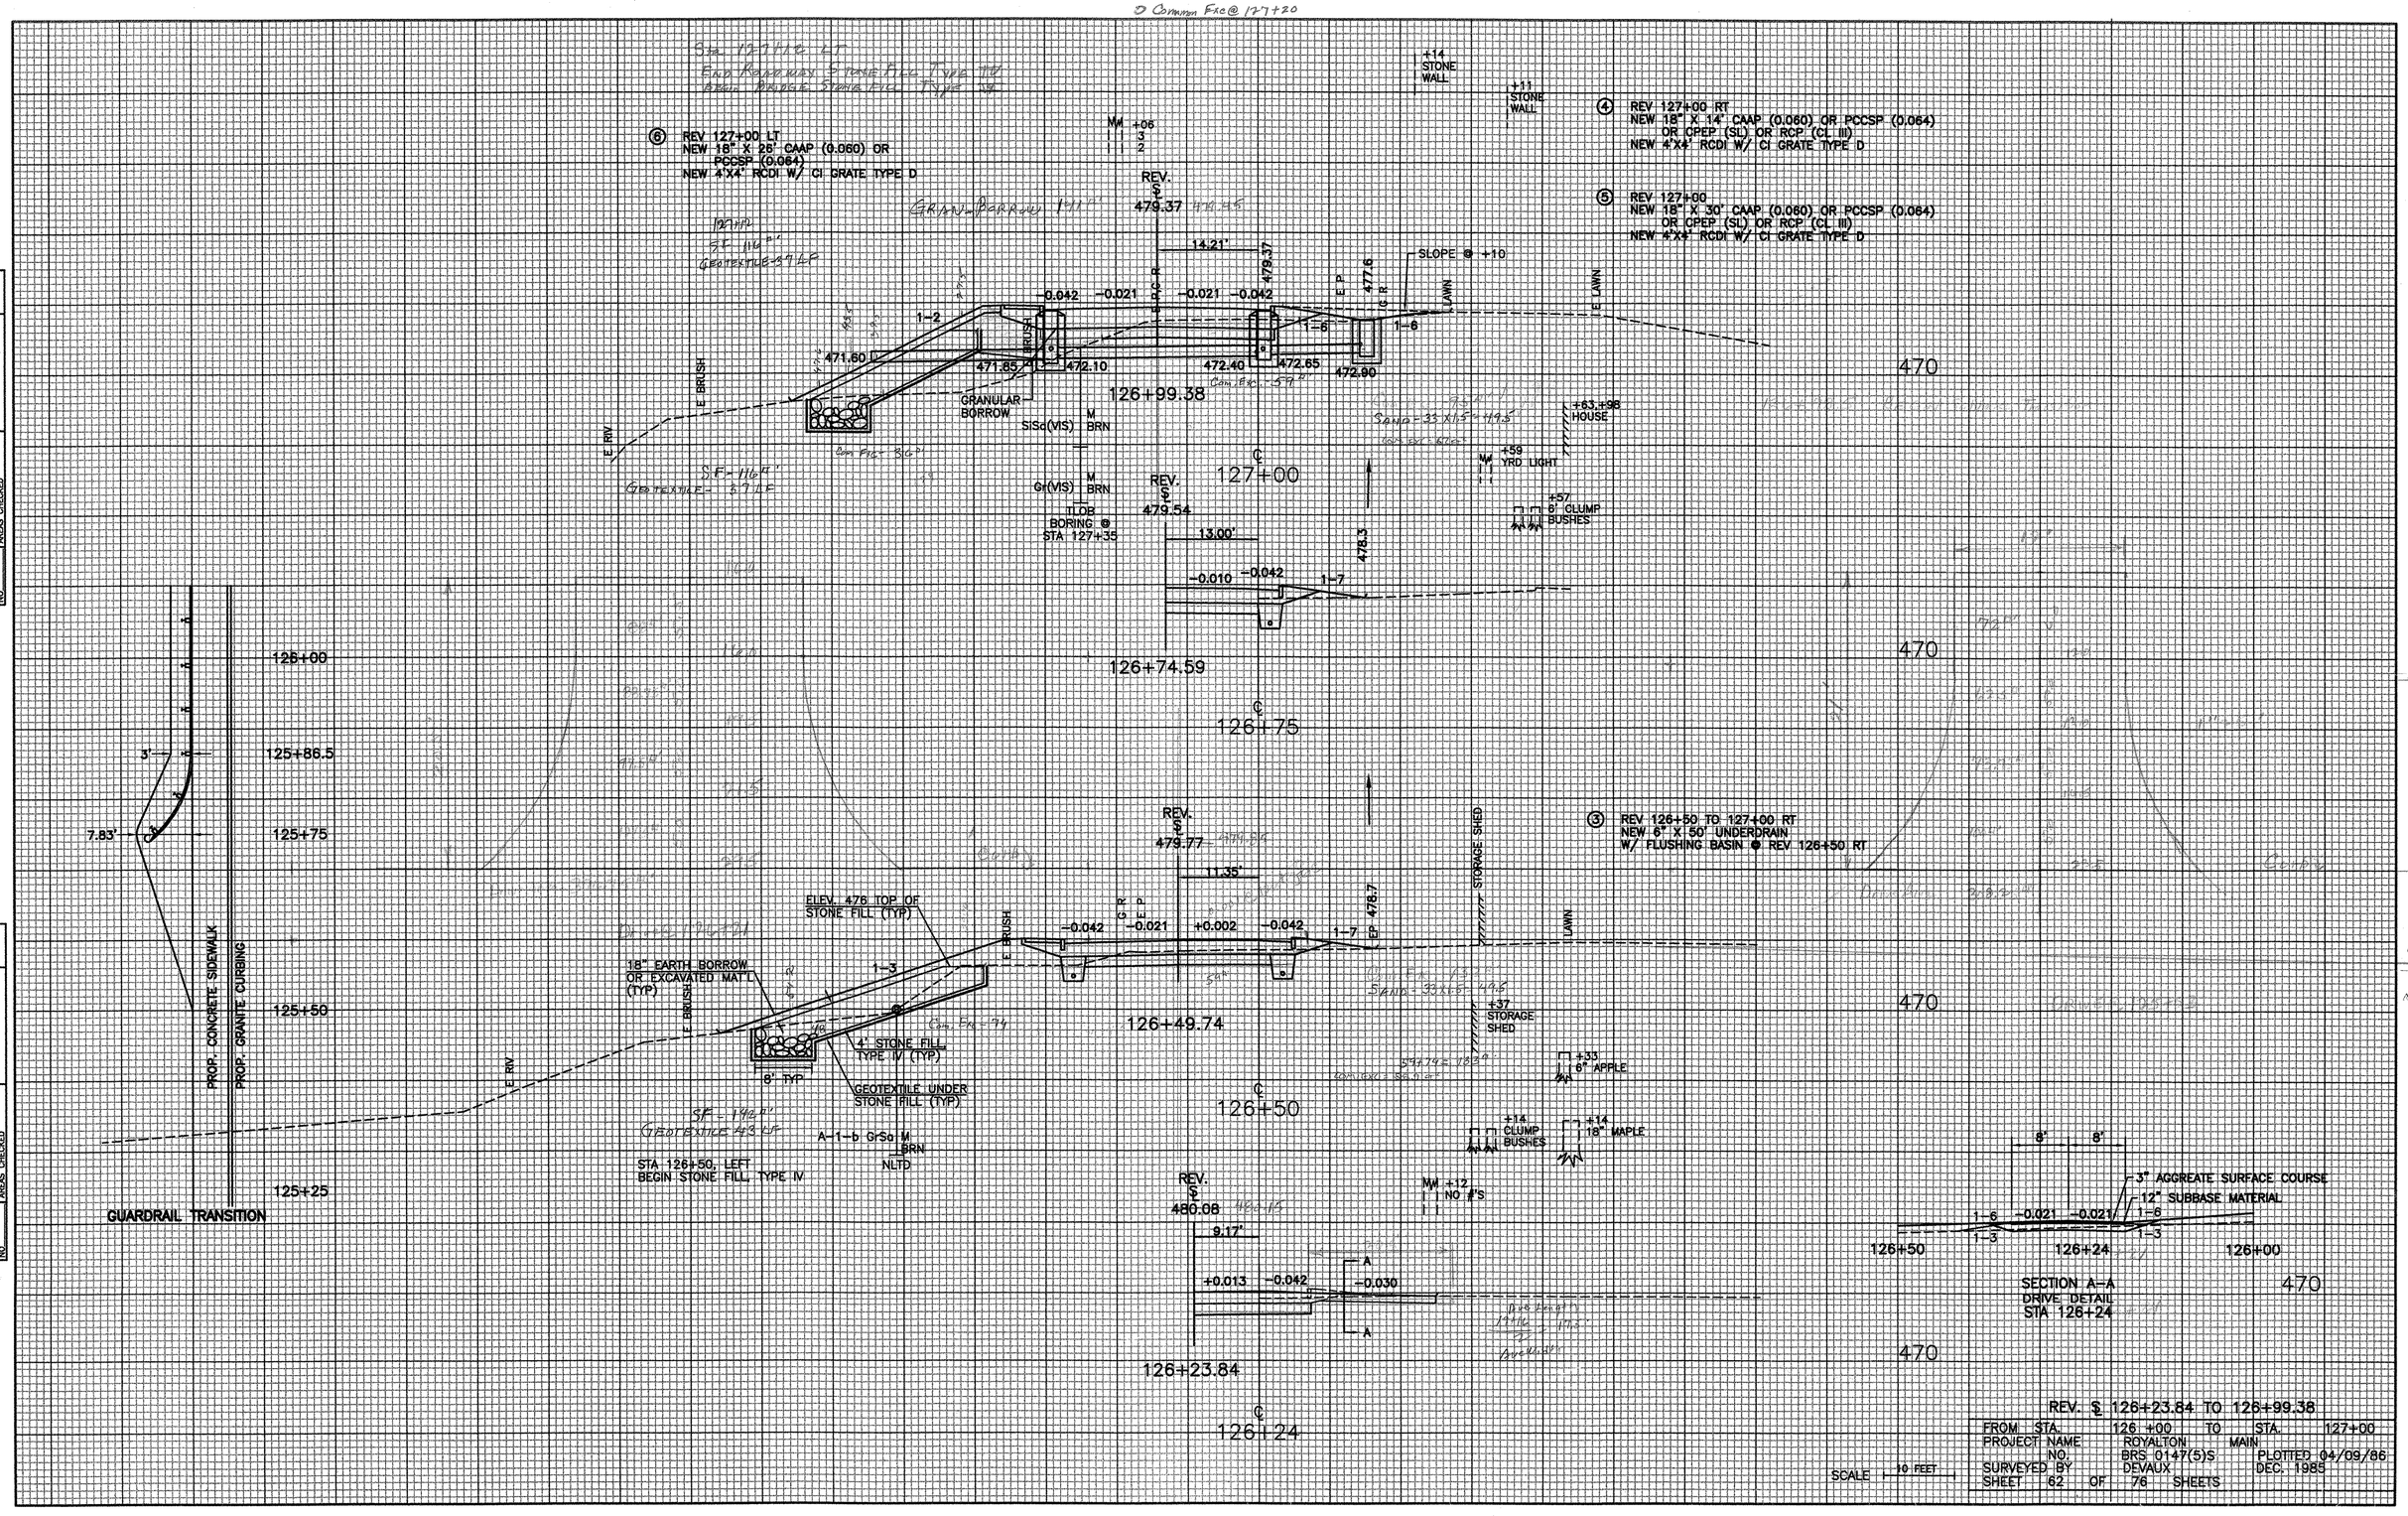

REV. ℄ 126+23.84 TO 126+99.38

FROM STA.	126 +00	TO STA.	127+00
PROJECT NAME	ROYALTON	MAIN	
NO.	BRS 0147(5)S		PLOTTED 04/09/86
SURVEYED BY	DEVAUX		DEC. 1985
SHEET 62 OF 76 SHEETS			

FINAL SURVEY				
NO.	NOTEBOOK	SURVEYED	BY	DATE
		PLOTTED		
		TRACE		
		AREAS		
		AREAS CHECKED		

ORIGINAL SURVEY				
NO.	NOTEBOOK	SURVEYED	BY	DATE
		PLOTTED		
		TRACE		
		AREAS		
		AREAS CHECKED		