128+64.25 End Bridge Begin App. Slab

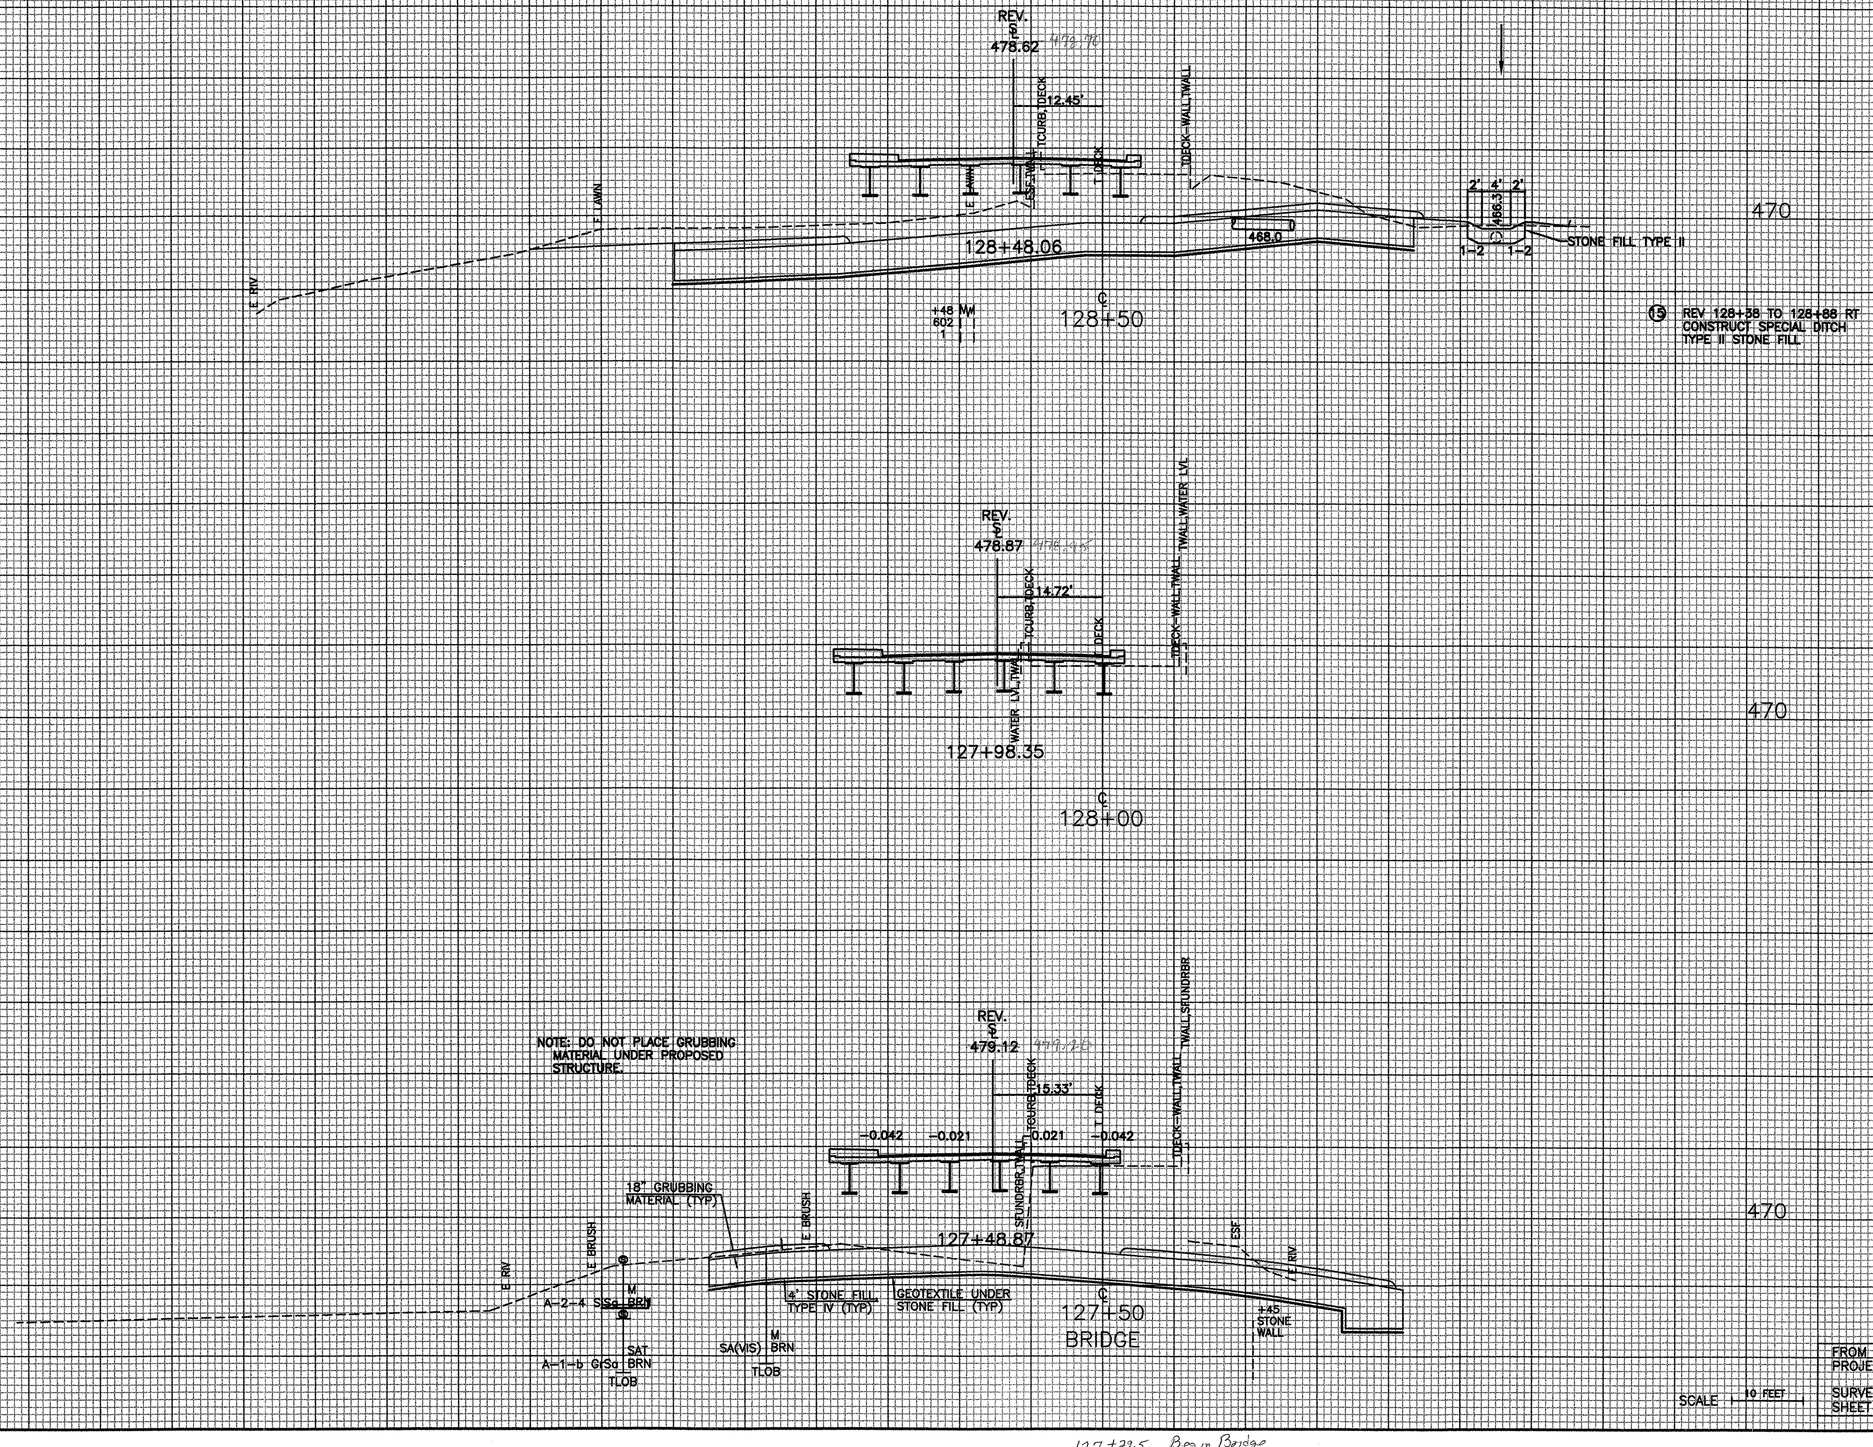

(15) REV 128+38 TO 128+88 RT
CONSTRUCT SPECIAL DITCH
TYPE II STONE FILL

REV. $ 127+48.87 TO 128+48.06

FROM STA.	127 +50	TO STA.	128+50		
PROJECT NAME	ROYALTON	MAIN			
NO.	BRS 0147(5)S		PLOTTED 04/09/86		
SURVEYED BY	DEVAUX		DEC. 1985		
SHEET 63	OF 76	SHEETS			

SCALE 10 FEET

FINAL SURVEY		BY	DATE
NOTEBOOK	SURVEYED		
	PLOTTED		
	TRIPLICATE		
	AREAS		
NO.	AREAS CHECKED		

ORIGINAL SURVEY		BY	DATE
NOTEBOOK	SURVEYED		
	PLOTTED		
	TRIPLICATE		
	AREAS		
NO.	AREAS CHECKED		

127+29.5 Begin Bridge
End Approach Slab