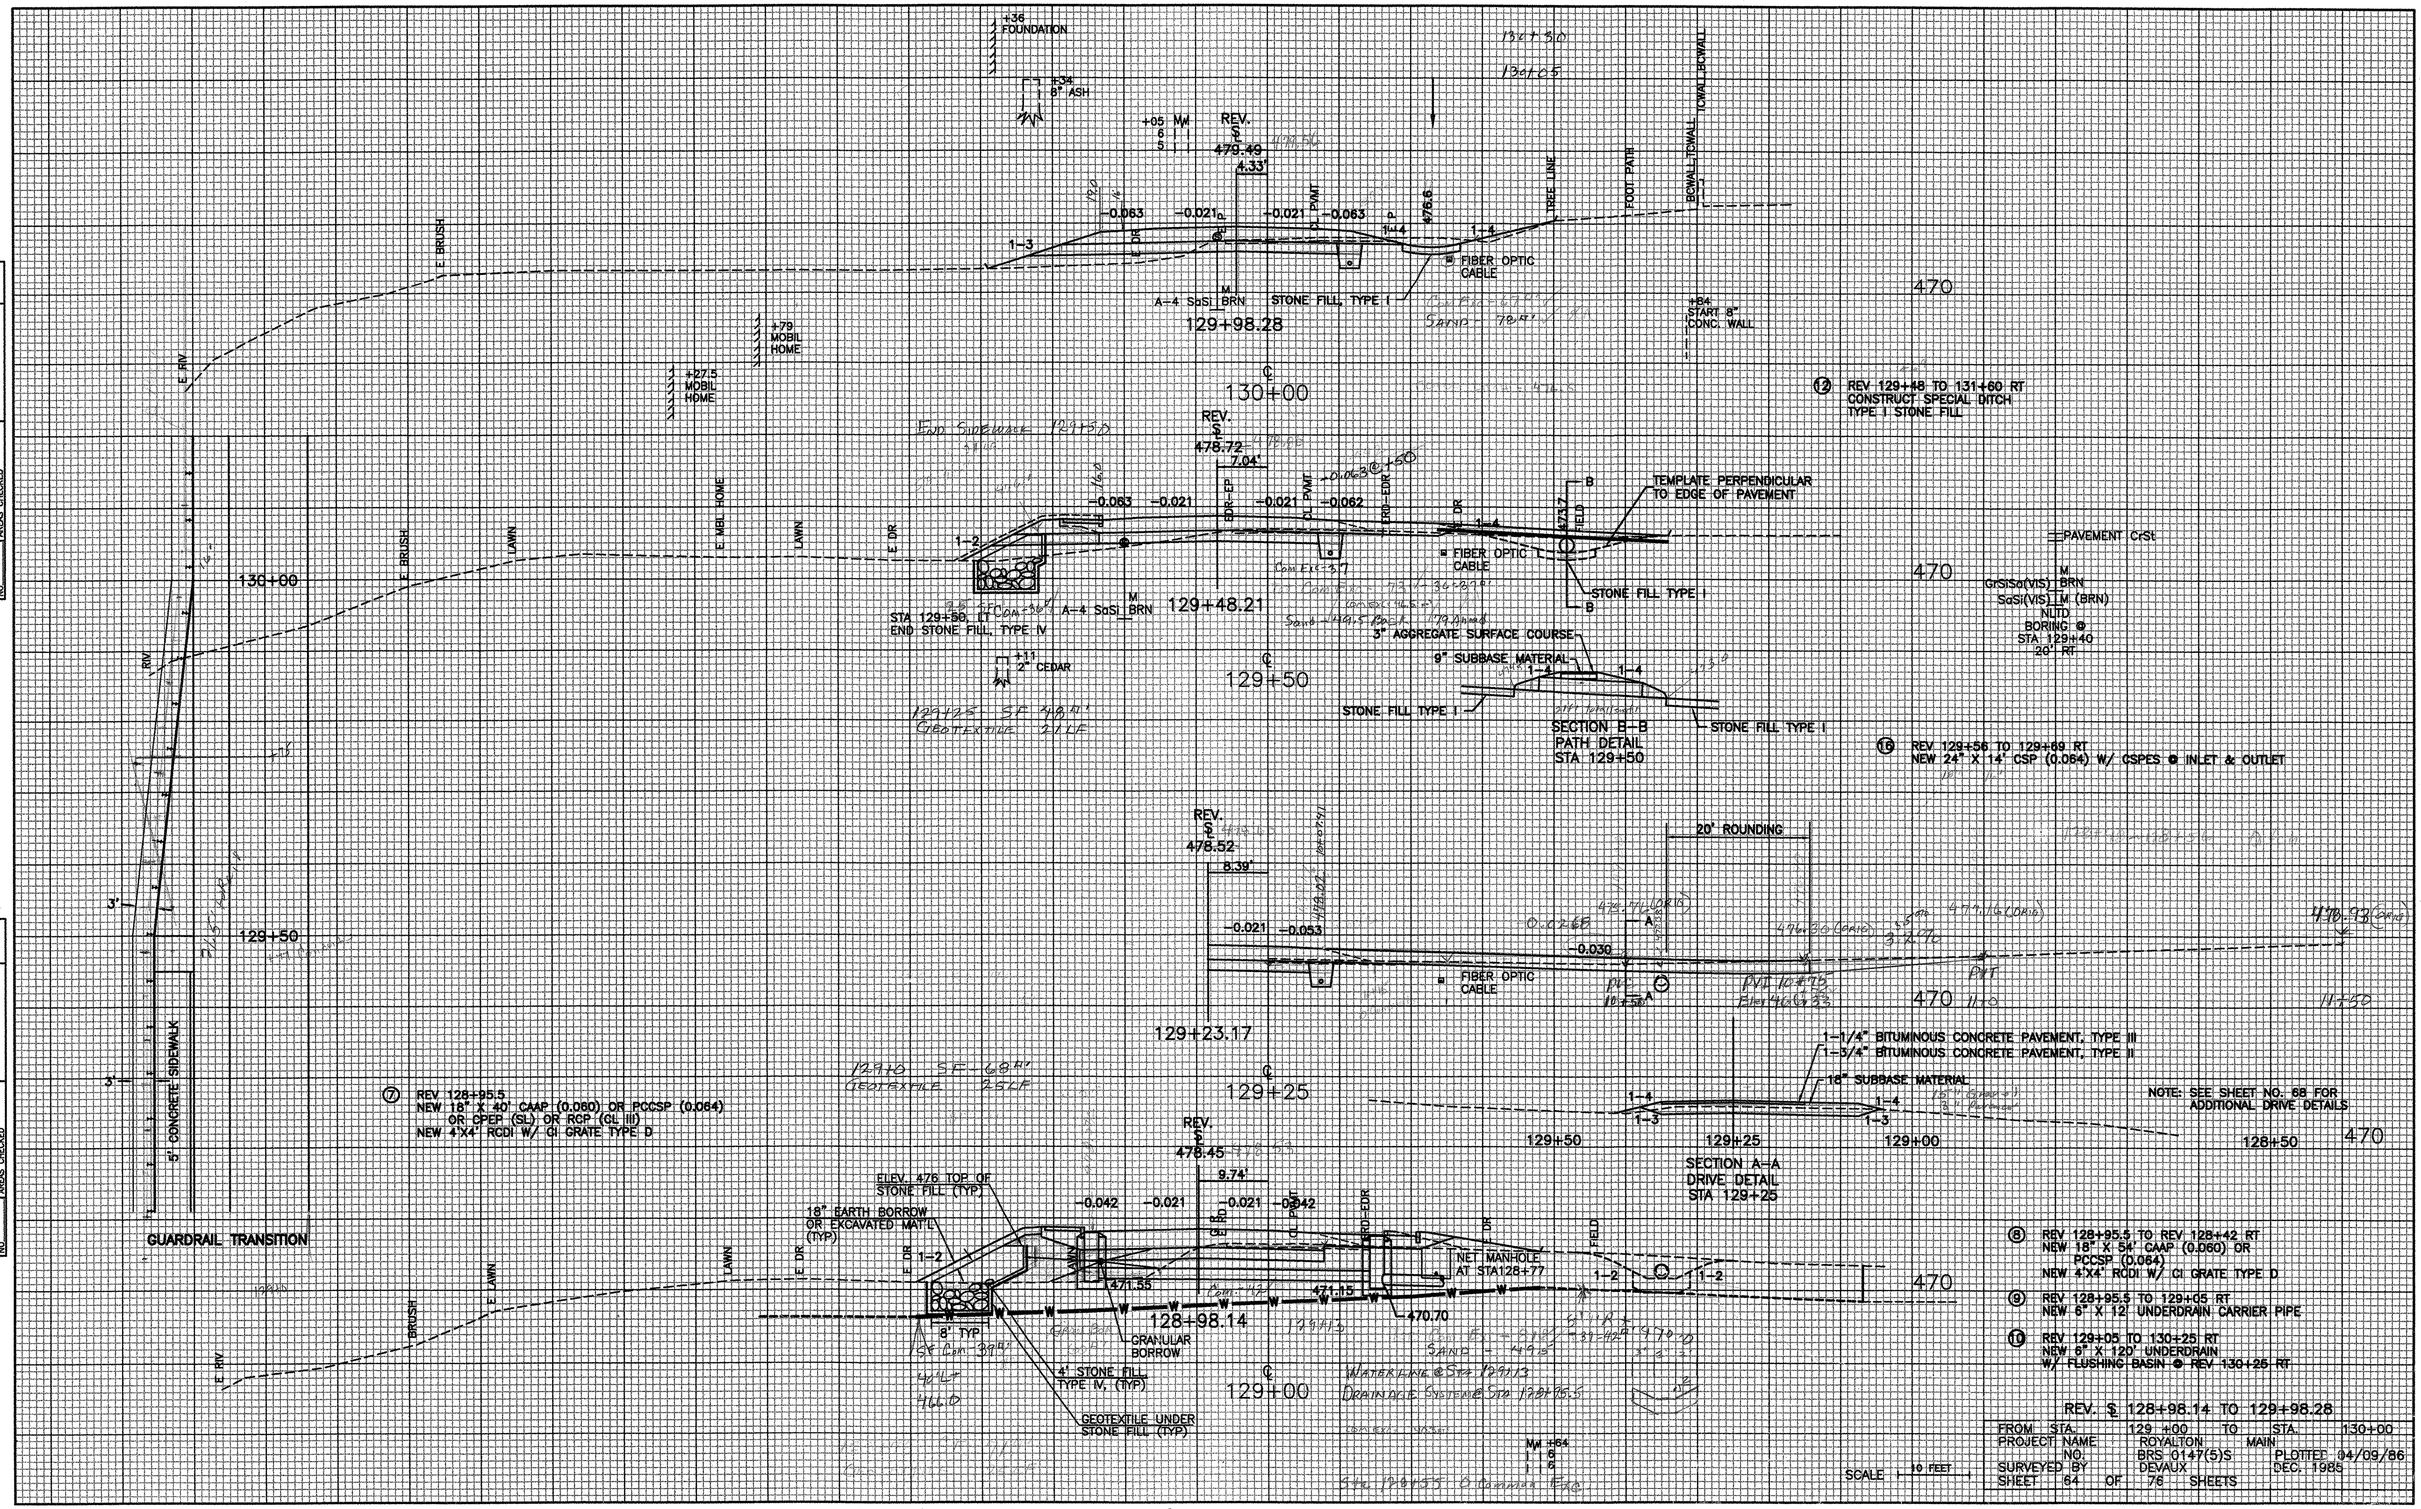


128+78 End Bridge Quantities (SF & Geotextile)
Begin Roadway Quantities