


FINAL SURVEY	BY	DATE
SURVEYED		
PLOTTED		
TEMPLATE		
NOTED		
NO.		

ORIGINAL SURVEY	BY	DATE
SURVEYED		
PLOTTED		
TEMPLATE		
NOTED		
NO.		

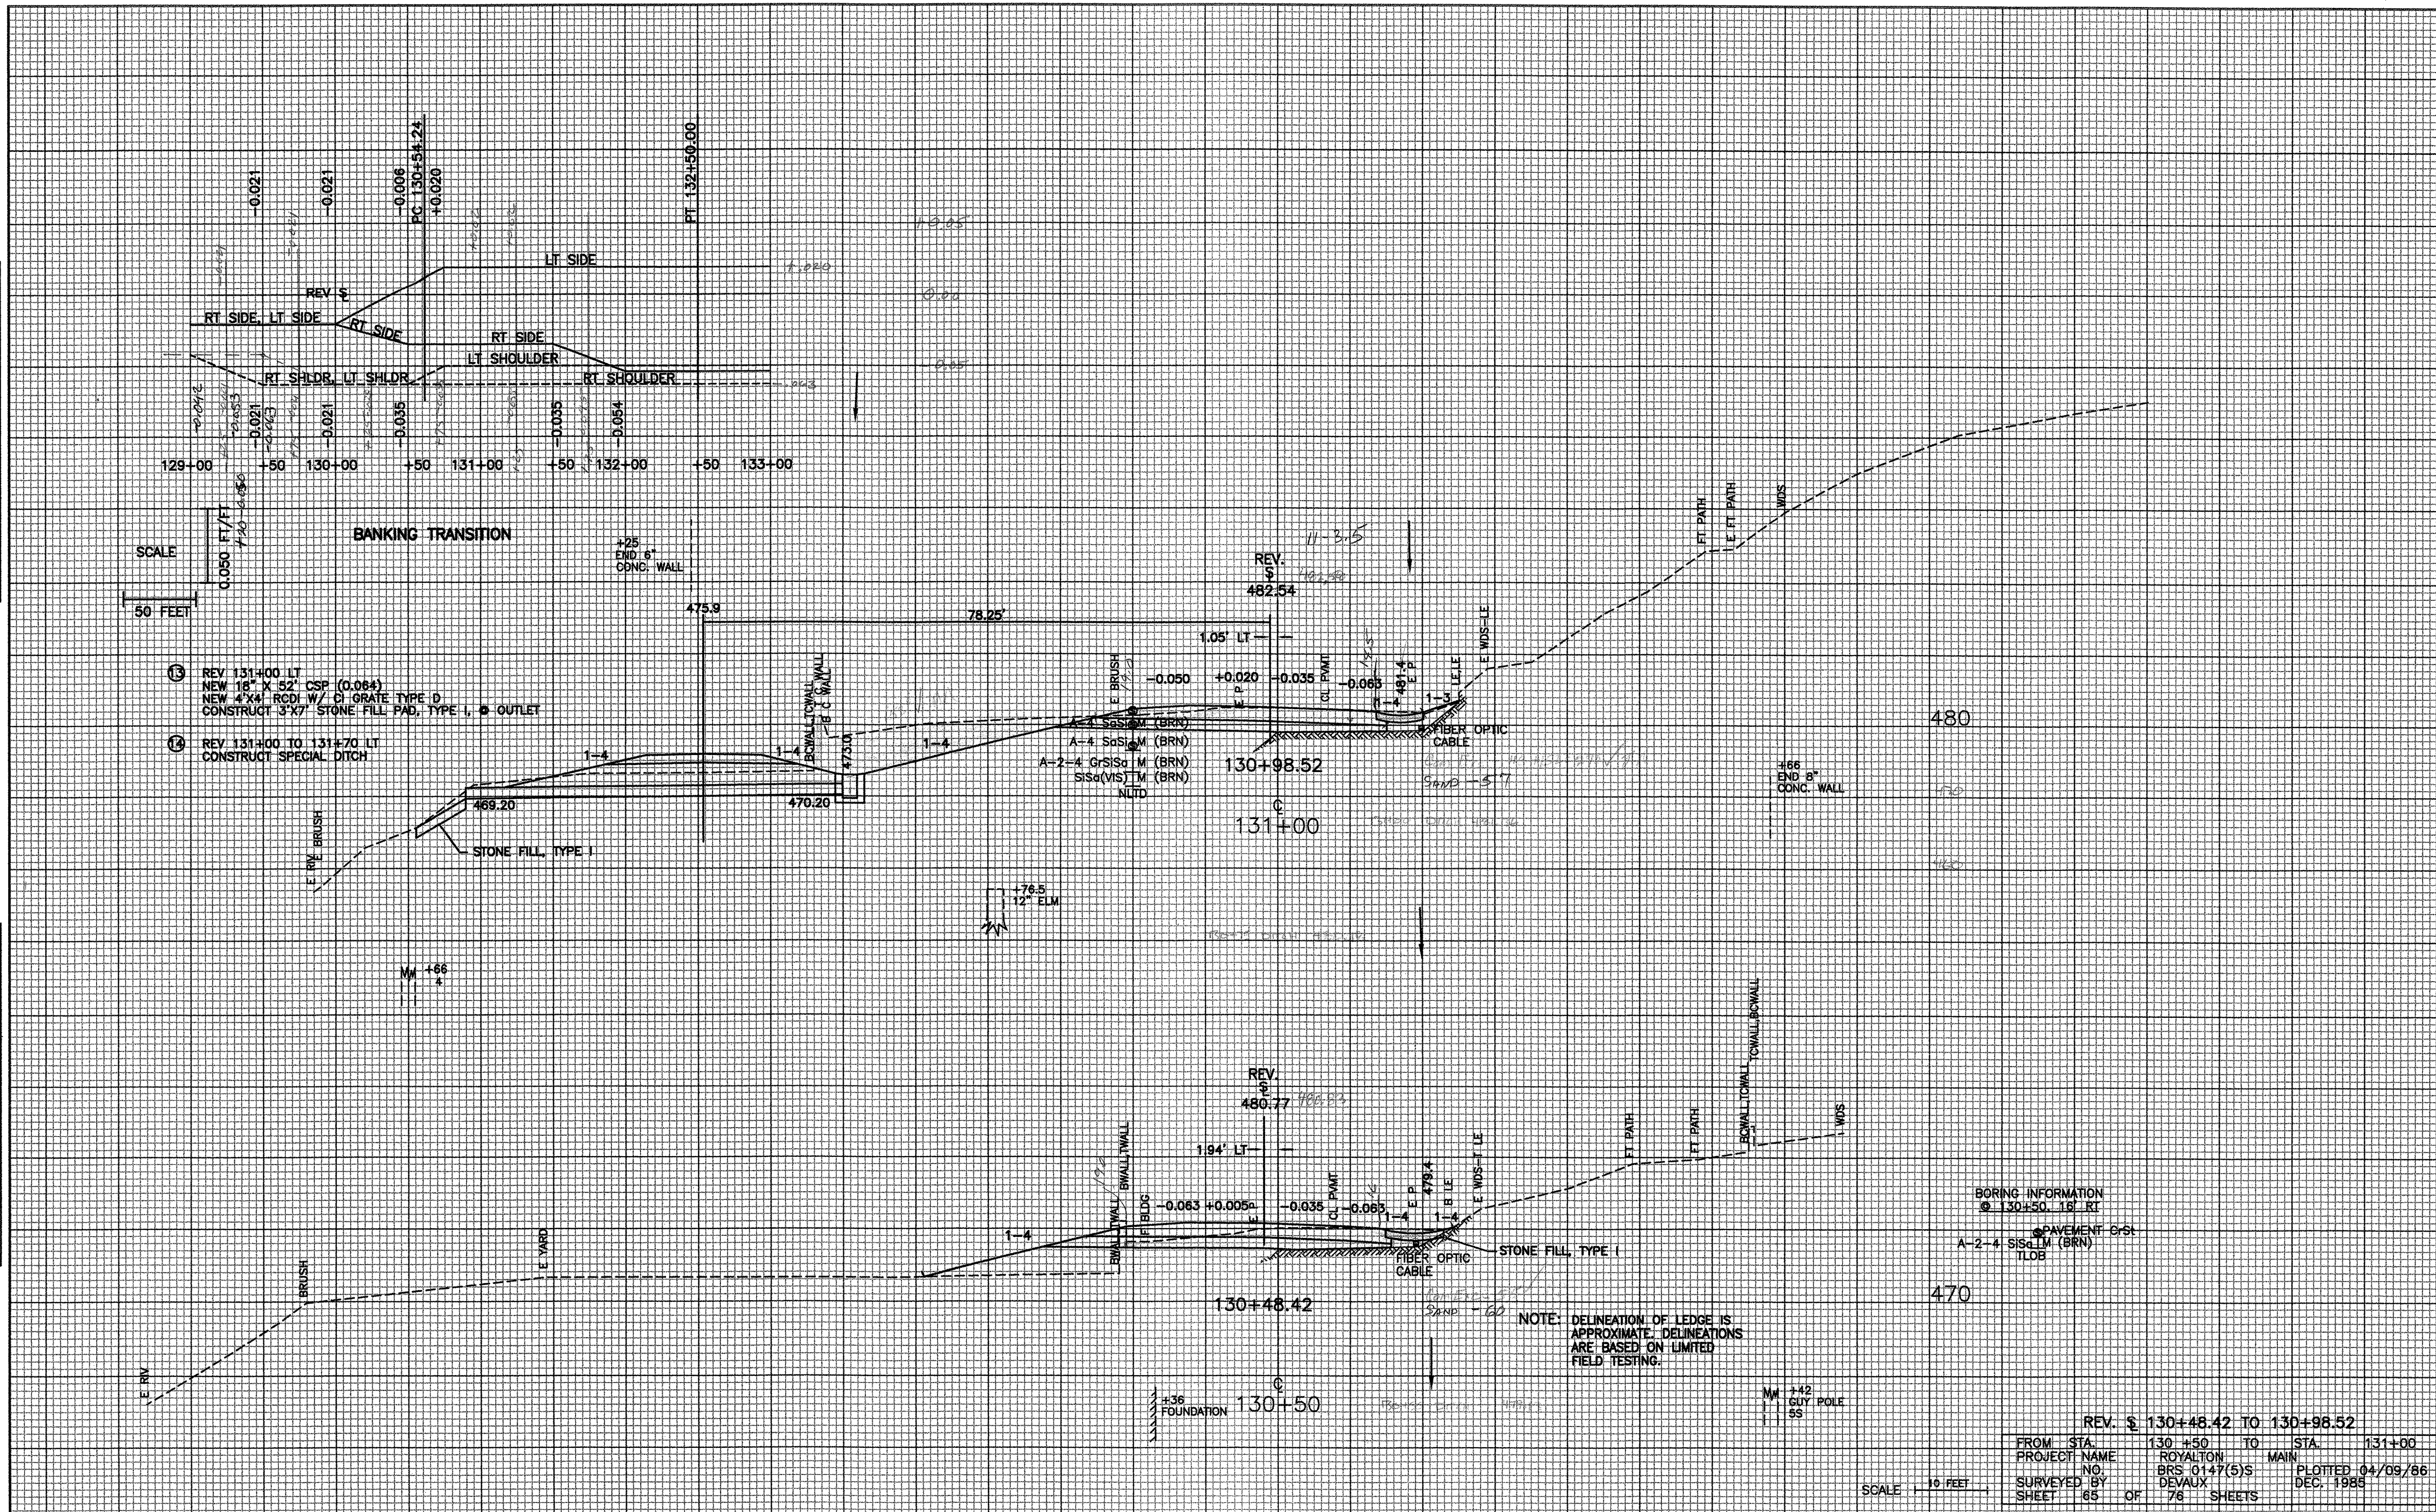

- 13 REV 131+00 LT
NEW 18" X 52" CSP (0.084)
NEW 4"X4" RODI W/ 1" ORATE TYPE D
CONSTRUCT 3'X7' STONE FILL PAD, TYPE I, & OUTLET
- 14 REV 131+00 TO 131+70 LT
CONSTRUCT SPECIAL DITCH

BORING INFORMATION
 @ 130+50 18" RT
 A-2-4 SISq.M (BRN)
 TLOB

NOTE: DELINEATION OF LEDGE IS APPROXIMATE. DELINEATIONS ARE BASED ON LIMITED FIELD TESTING.

REV. § 130+48.42 TO 130+98.52
 FROM STA. 130+50 TO STA. 131+00
 PROJECT NAME ROYALTON MAIN
 NO. BRS 0147(5)S PLOTTED 04/09/86
 SURVEYED BY DEVAUX DEC. 1985
 SHEET 65 OF 76 SHEETS

SCALE 1" = 10 FEET

92
 180-12-21-53
 130+75 01-11-47770