FINAL SURVEY		BY	DATE
NOTEBOOK	SURVEYED		
	PLOTTED		
	TEMPLATE		
	AREAS		
NO.	AREAS CHECKED		

ORIGINAL SURVEY		BY	DATE
NOTEBOOK	SURVEYED		
	PLOTTED		
	TEMPLATE		
	AREAS		
NO.	AREAS CHECKED		

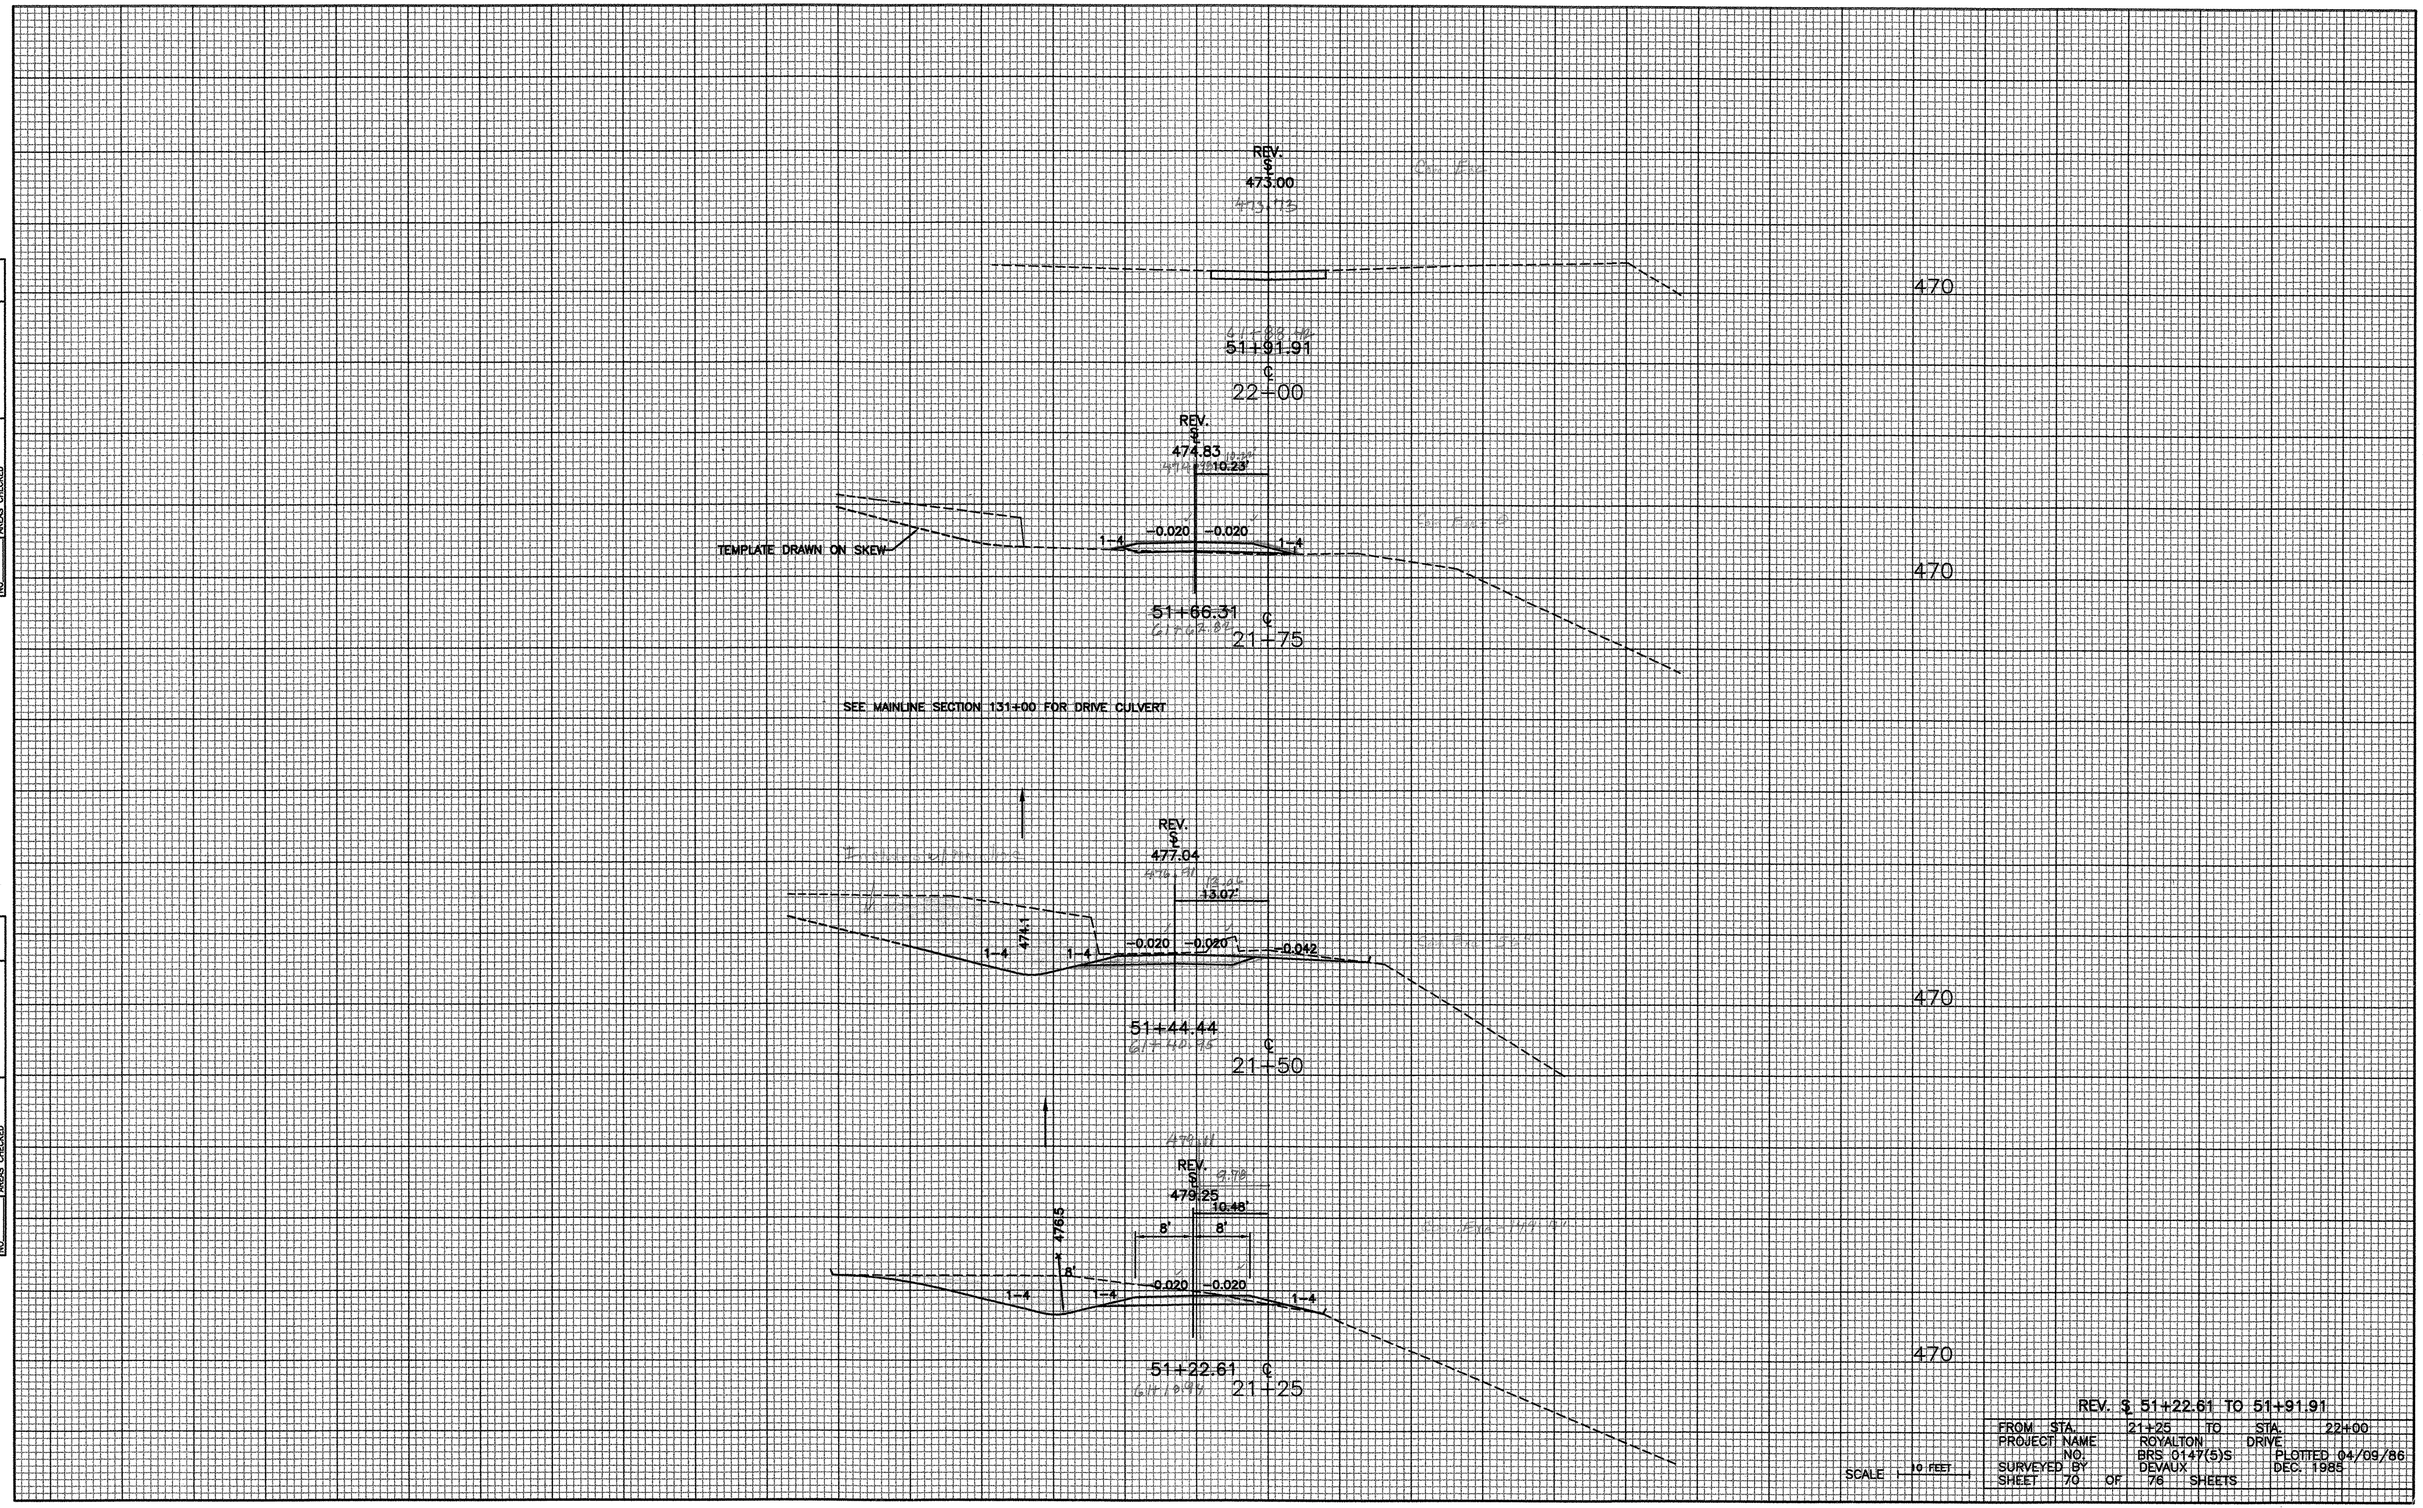

REV. ℄ 51+22.61 TO 51+91.91

FROM STA.	21+25	TO	STA.	22+00	
PROJECT NAME	ROYALTON		DRIVE		
NO.	BRS 0147(5)S			PLOTTED 04/09/86	
SURVEYED BY	DEVAUX			DEC. 1985	
SHEET 70 OF 76 SHEETS					