


DATE	
BY	
SUBMITTED	
PLOTTED	
TEMPLATE	
AREAS	
CHECKED	
FINAL SURVEY	
NOTEBOOK	
NO.	

DATE	
BY	
SUBMITTED	
PLOTTED	
TEMPLATE	
AREAS	
CHECKED	
ORIGINAL SURVEY	
NOTEBOOK	
NO.	

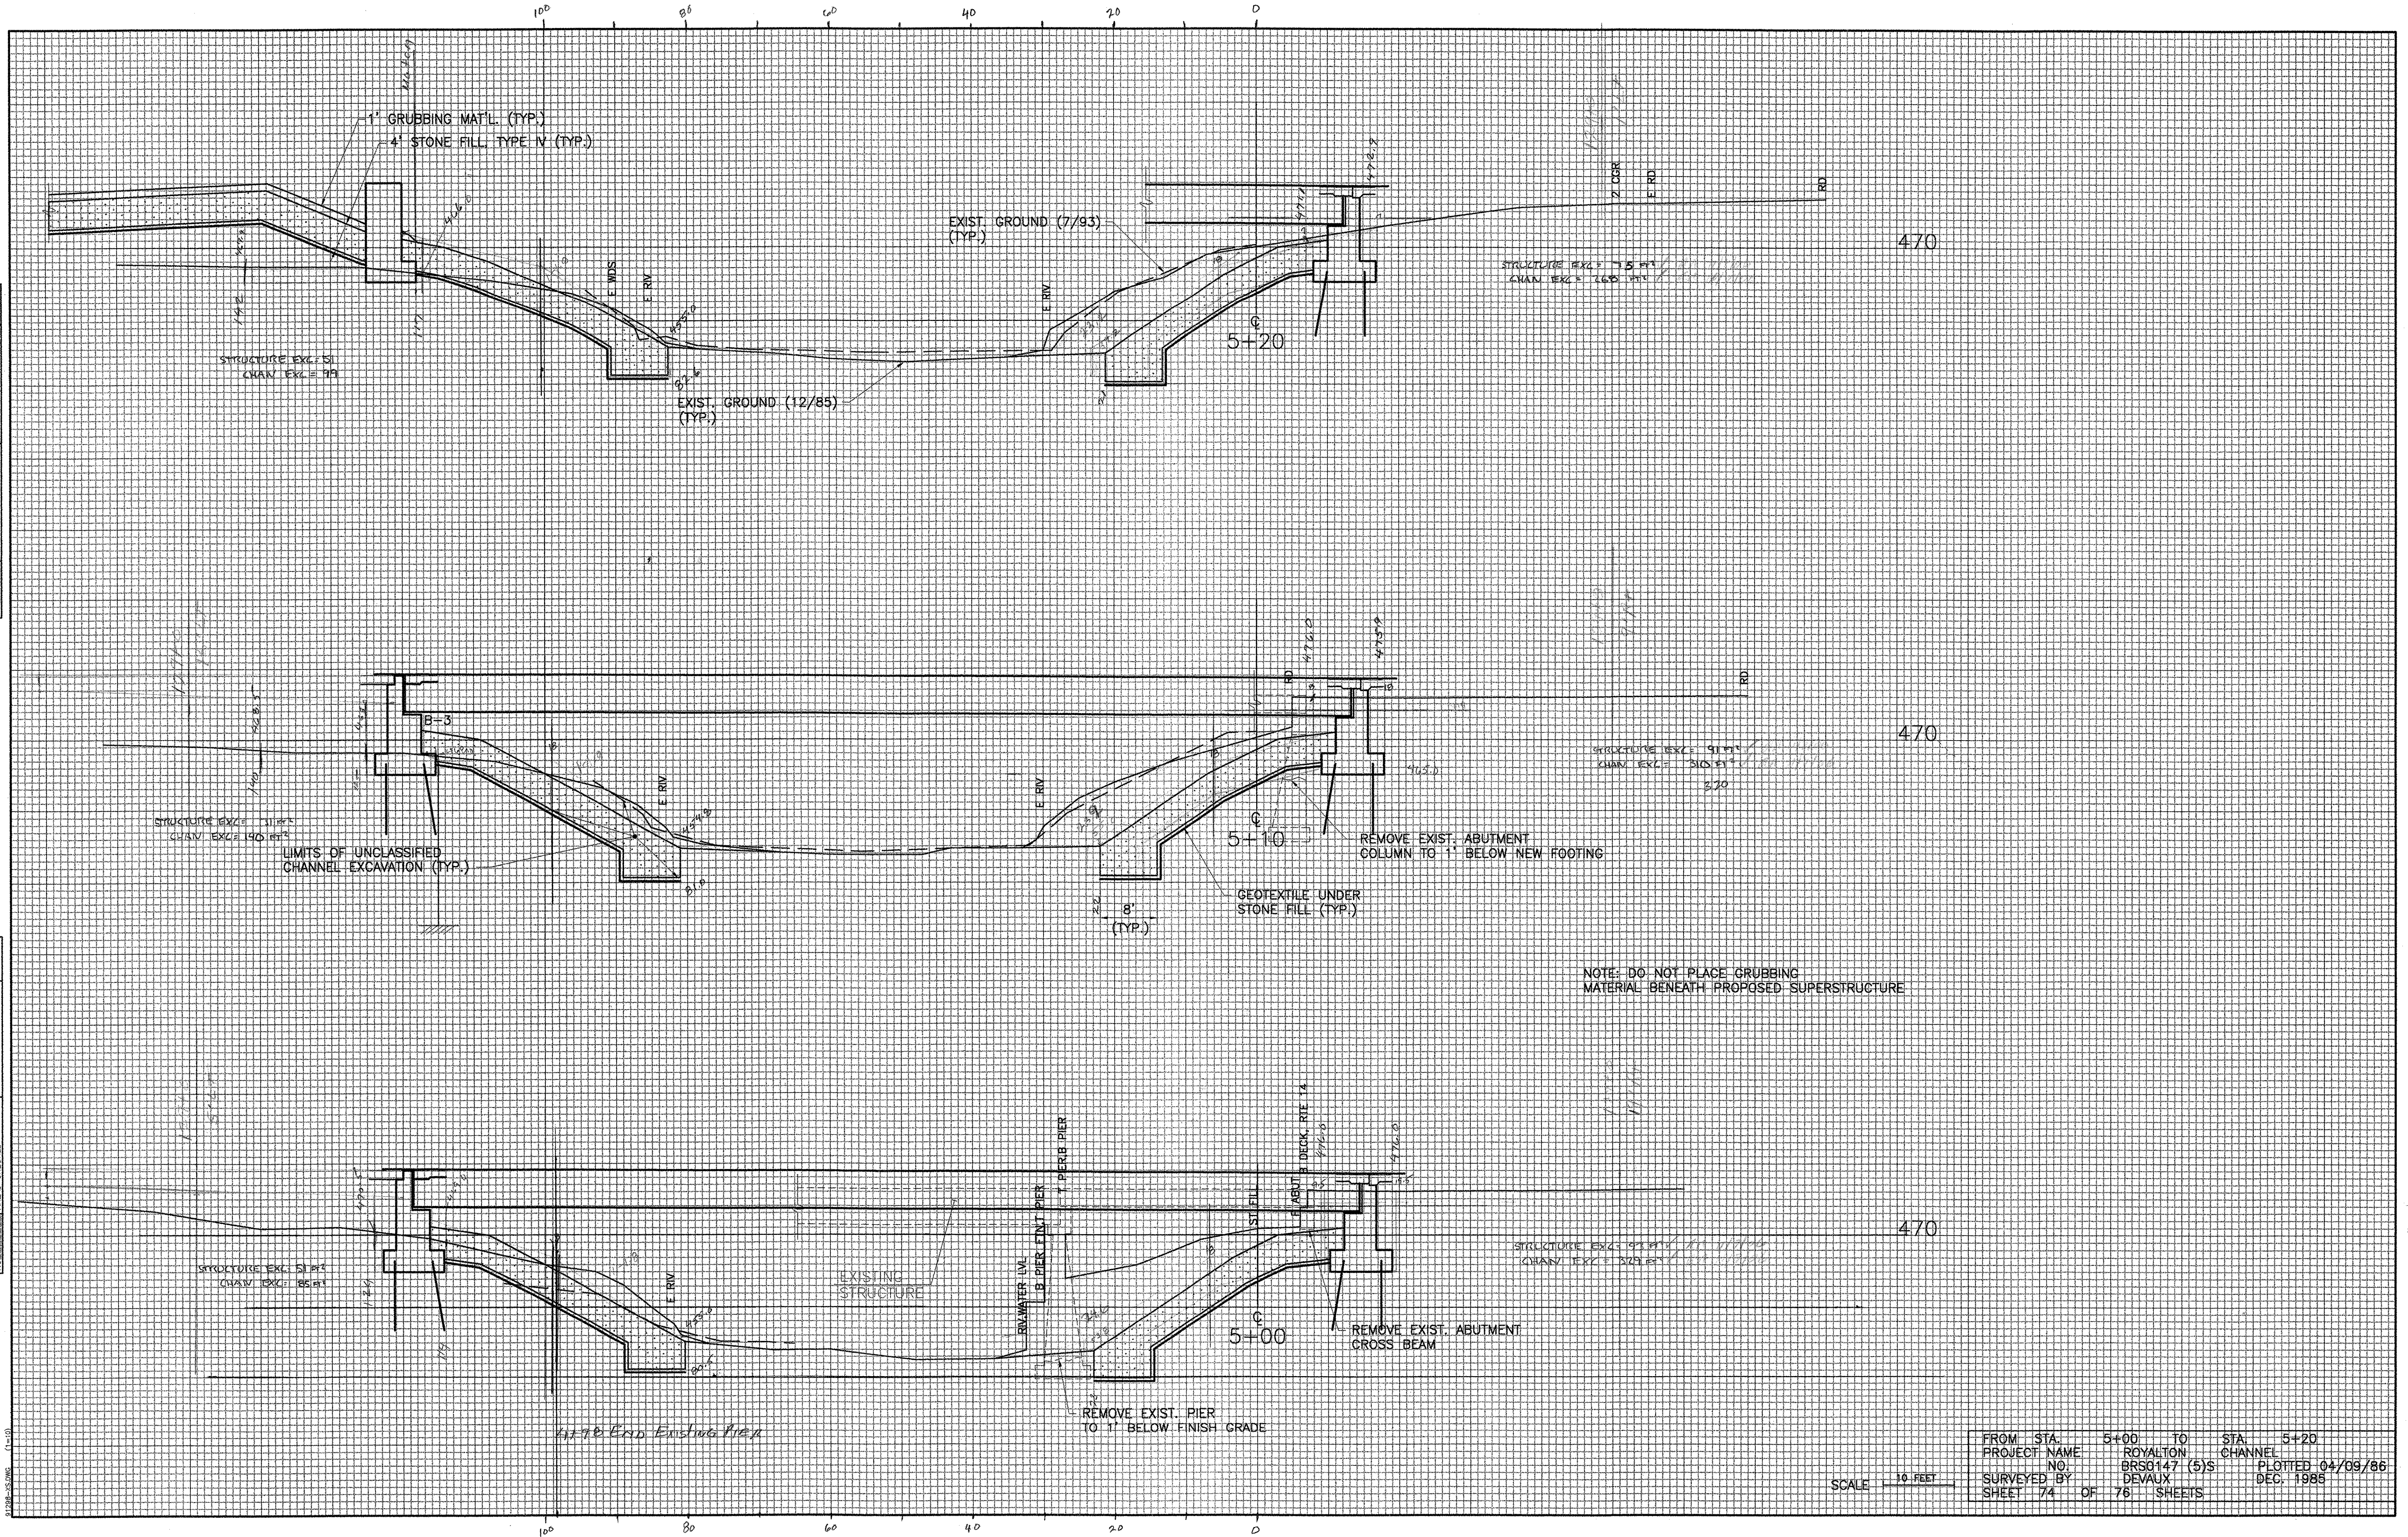

FROM STA. 5+00 TO STA. 5+20
 PROJECT NAME ROYALTON CHANNEL
 NO. BRSG147 (5)S PLOTTED 04/09/86
 SURVEYED BY DEVAUX DEC. 1985
 SHEET 74 OF 76 SHEETS

SCALE 1" = 10 FEET

470
 453
 15
 215
 225