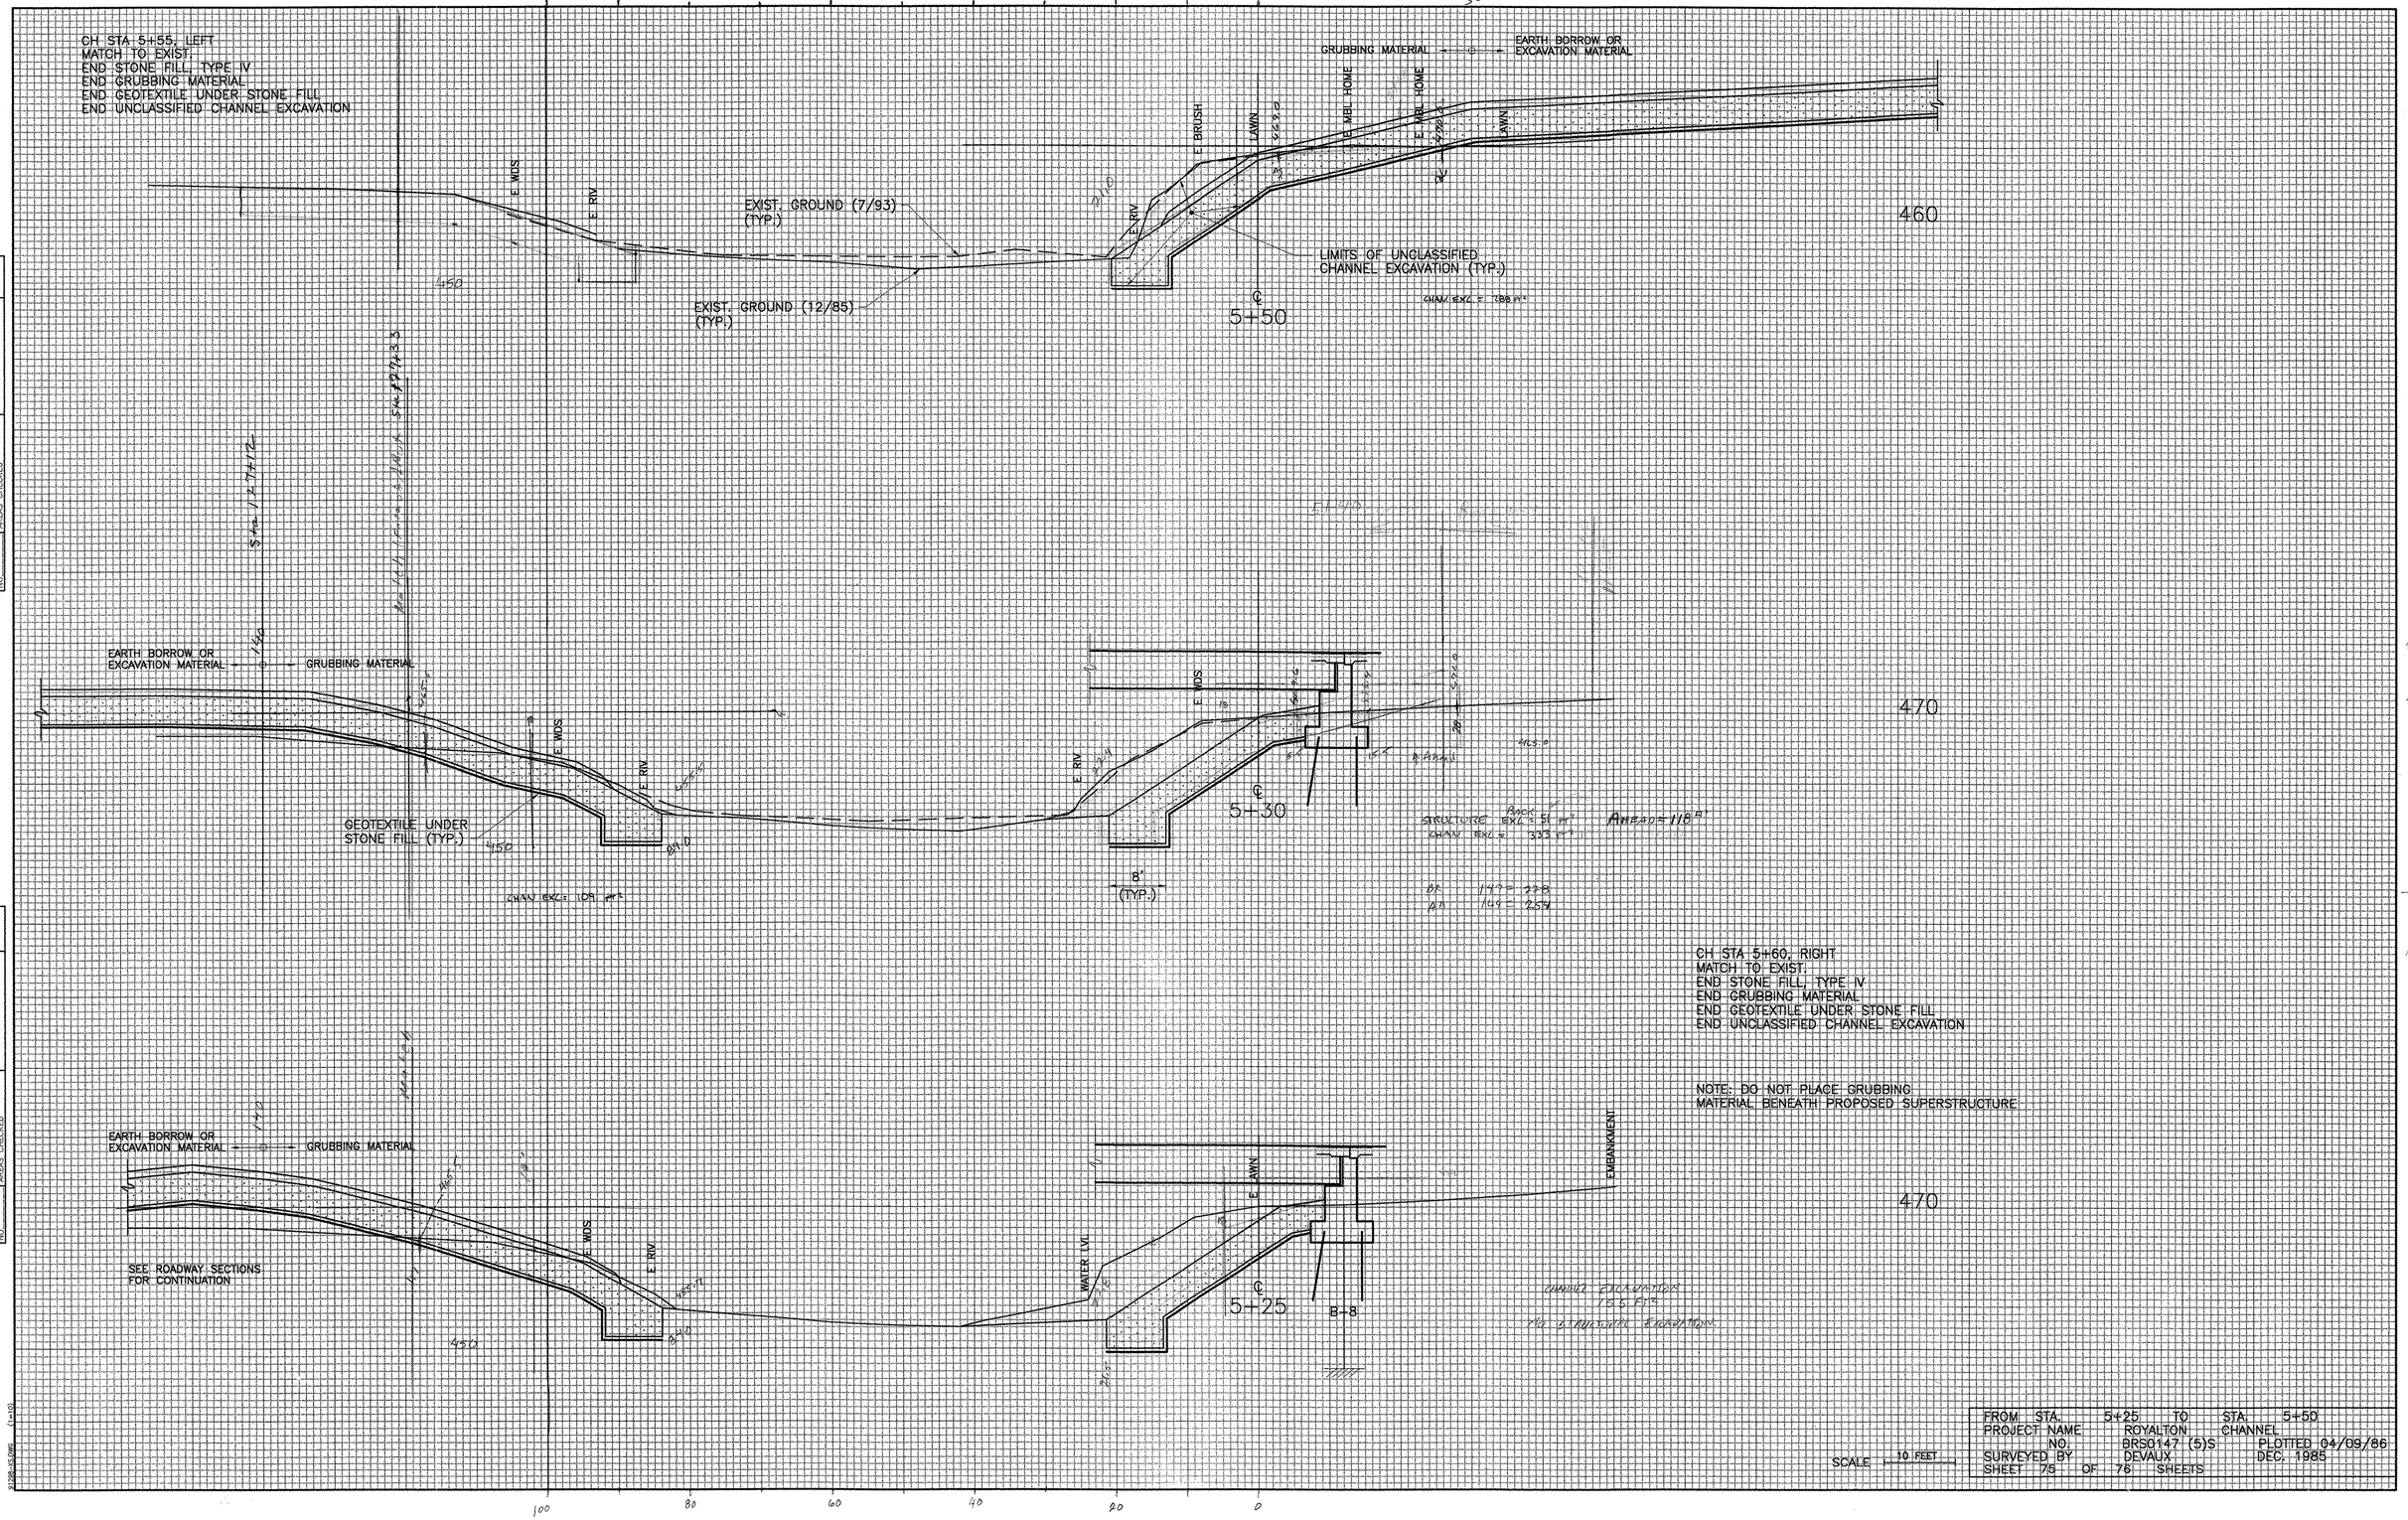
CH STA 5+55, LEFT
MATCH TO EXIST.
END STONE FILL TYPE IV
END GRUBBING MATERIAL
END GEOTEXTILE UNDER STONE FILL
END UNCLASSIFIED CHANNEL EXCAVATION
GRUBBING MATERIAL
EARTH BORROW OR EXCAVATION MATERIAL
E WDS
E RIV
EXIST. GROUND (7/93) (TYP.)
EXIST. GROUND (12/85) (TYP.)
E BRUSH
LAWN
E MBL HOME
LIMITS OF UNCLASSIFIED CHANNEL EXCAVATION (TYP.)
CHAN. EXC. = 188 yd³
460
450
5+50
EARTH BORROW OR EXCAVATION MATERIAL
GRUBBING MATERIAL
GEOTEXTILE UNDER STONE FILL (TYP.)
CHAN EXC. = 109 yd³
5+30
8' (TYP.)
STRUCTURE EXC. = 51 yd³
CHAN EXC. = 333 yd³
AHEAD = 118 yd³
BK 147 = 228
AH 149 = 254
470
CH STA 5+60, RIGHT
MATCH TO EXIST.
END STONE FILL TYPE IV
END GRUBBING MATERIAL
END GEOTEXTILE UNDER STONE FILL
END UNCLASSIFIED CHANNEL EXCAVATION
NOTE: DO NOT PLACE GRUBBING MATERIAL BENEATH PROPOSED SUPERSTRUCTURE
EMBANKMENT
SEE ROADWAY SECTIONS FOR CONTINUATION
WATER LVL
5+25
8'-8"
CHANNEL EXCAVATION 165 yd³
NO STRUCTURE EXCAVATION.
FROM STA. 5+25 TO STA. 5+50
PROJECT NAME ROYALTON CHANNEL
NO. BRS0147 (5)S
SURVEYED BY DEVAUX
PLOTTED 04/09/86
DEC. 1985
SHEET 75 OF 76 SHEETS
SCALE 10 FEET
FINAL SURVEY
NOTEBOOK
NO.
SURVEYED
PLOTTED
TEMPLATE
AREAS
AREAS CHECKED
BY
DATE
ORIGINAL SURVEY
NOTEBOOK
NO.
SURVEYED
PLOTTED
TEMPLATE
AREAS
AREAS CHECKED
BY
DATE