


FINAL SURVEY	SUBMITTED	DATE
NOTEBOOK	PLOTTED	BY
NO.	TEMPLATE	
	AREAS	
	CHECKED	

ORIGINAL SURVEY	SUBMITTED	DATE
NOTEBOOK	PLOTTED	BY
NO.	TEMPLATE	
	AREAS	
	CHECKED	

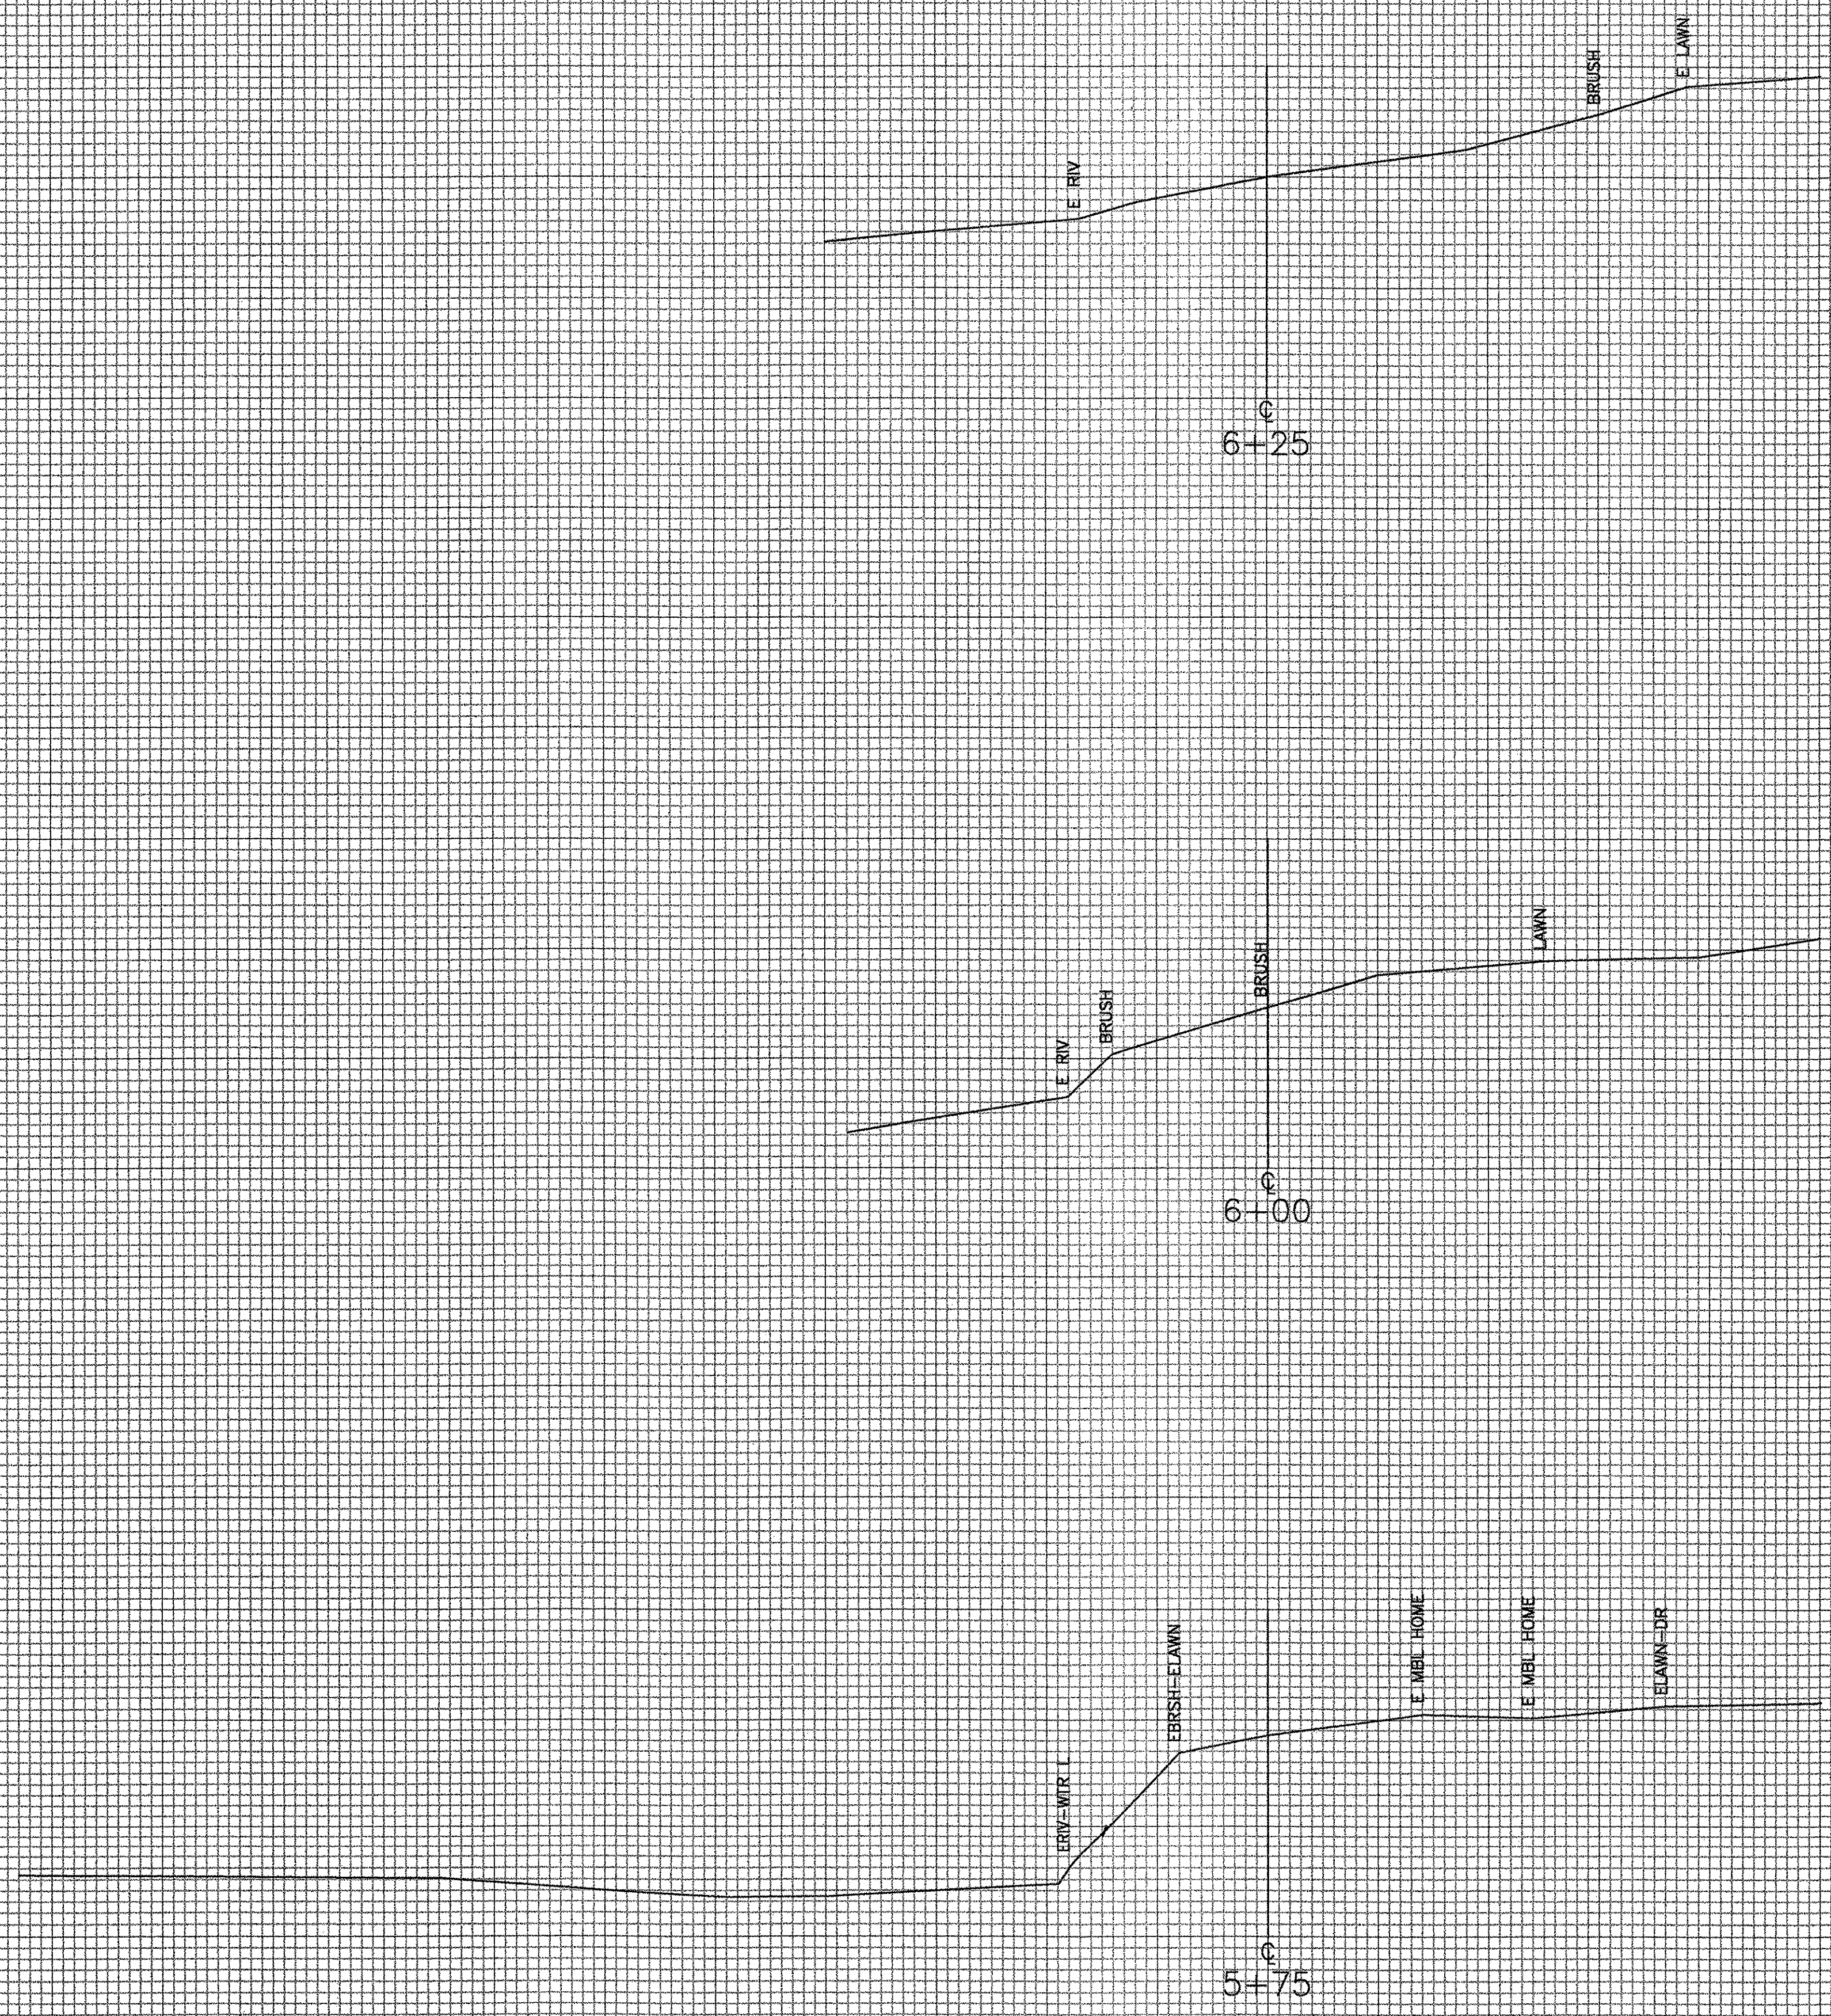

SCALE 10 FEET

FROM STA.	5+75	TO STA.	6+25
PROJECT NAME	ROYALTON	CHANNEL	
NO.	BR50147 (5)S	PLOTTED	04/09/86
SURVEYED BY	DEVAUX		DEC. 1985
SHEET	76	OF	76 SHEETS

9/28/85-JS/76/85 C-10