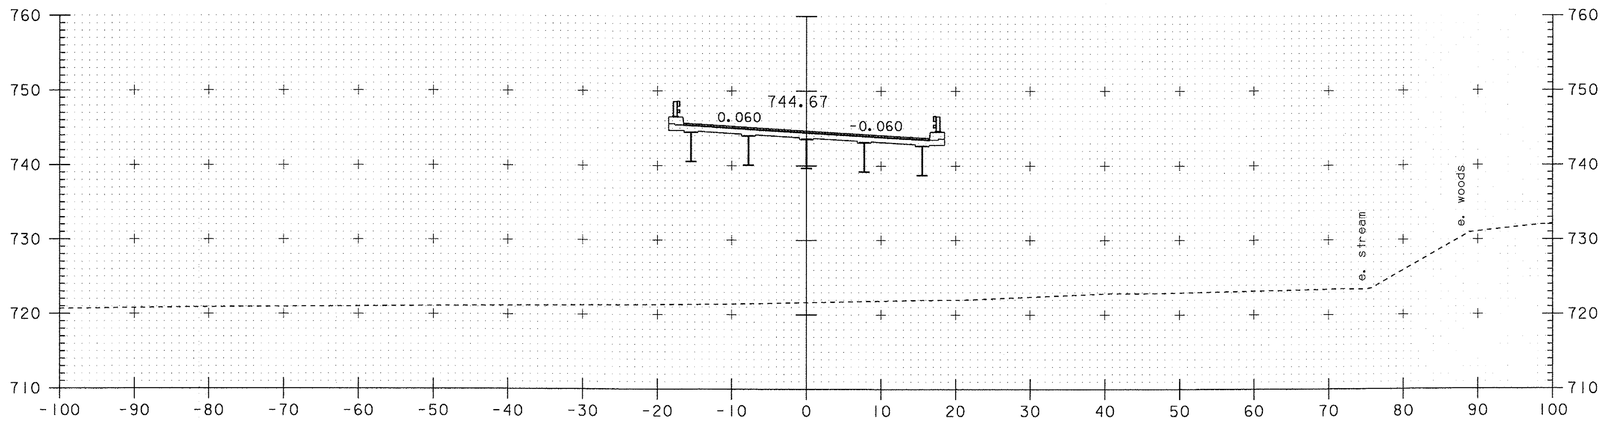

143+00

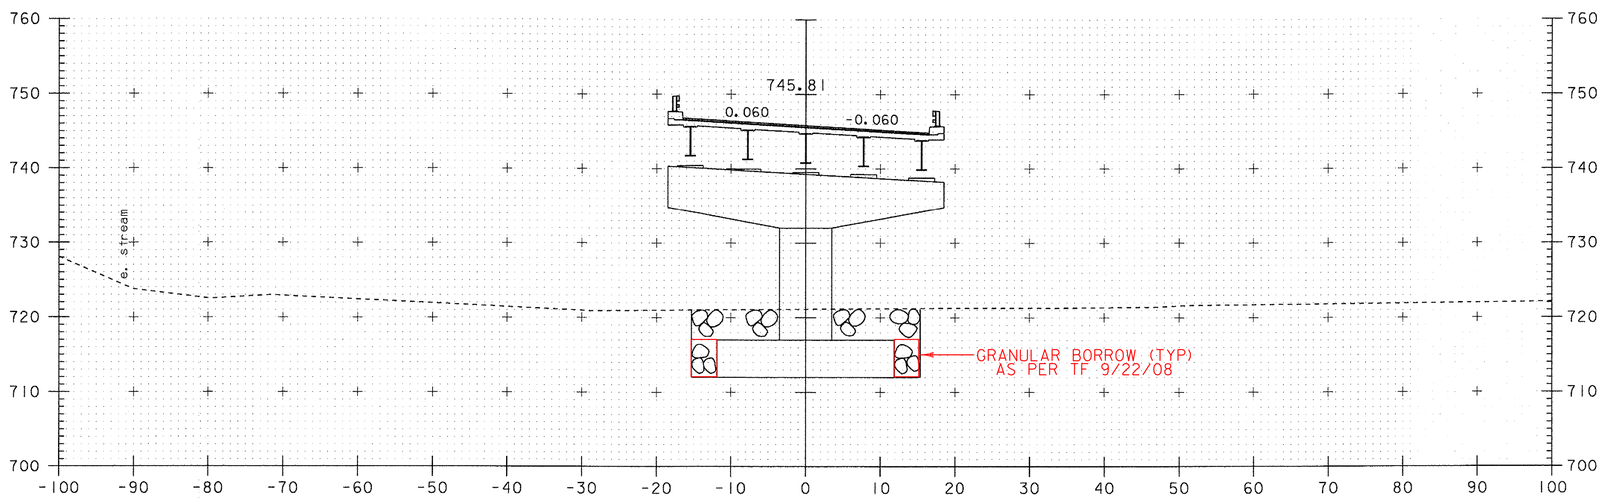

142+50

SCALE 1" = 10'-0

Stonefill 23.75'x23.75'x4' − (π 3.5²x4') + (8'x4'x31.75')2 + (8'x4'x23.75')2
2256.25 ft³ − 153.94 ft³ + 2032.0 ft³ + 1520.0 ft³
5654.31 ft³ / 27 ft³/cy = 209.42 cy to add to channel total

NRC 12/18/09
DGB 11/13/11

MAINLINE CROSS SECTIONS
STA. 142+50 – STA. 143+00

PROJECT NAME-	STOCKBRIDGE
PROJECT NUMBER-	BRF 013-4 (21)
FILE NAME- /78f238/str5/df268xs1.dgn	PLOT DATE- 06-FEB-2008
PROJECT LEADER- K. HIGGINS	DRAWN BY- G. SHANGRAW
DESIGNED BY- T. SUMNER	CHECKED BY- T. FILLBACH
df238x12.i	SHEET 120 OF 144