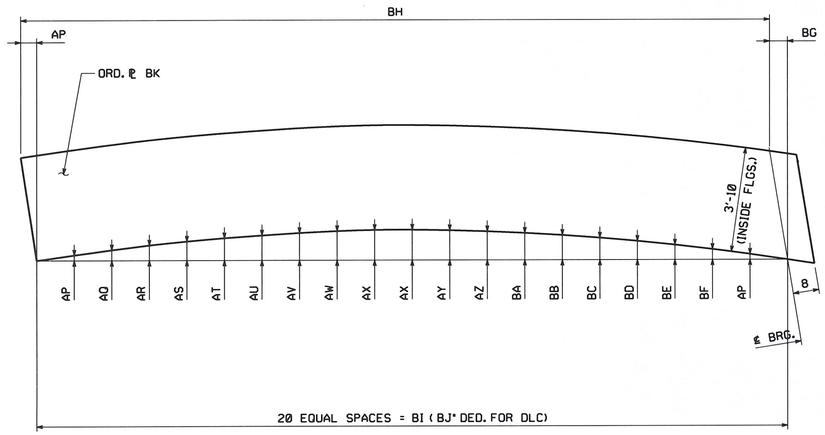

MARK	AP	AQ	AR	AS	AT	AU	AV	AW	AX	AY	AZ	BA	BB	BC	BD	BE	BF	BG	BH	BI	BJ	BK
G1C	5/8	1 3/16	1 3/4	2 3/16	2 9/16	2 7/8	3 1/8	3 3/8	3 1/2	3 7/16	3 5/16	3 1/8	2 7/8	2 9/16	2 3/16	1 3/4	1 3/16	1 1/16	82'-1 3/8	82'-1 13/16	1/4	5/8 × 50 1/2 × 83'-1 M270 GR. 50W (03001)
G2C	5/8	1 1/4	1 3/4	2 3/16	2 9/16	2 13/16	3 1/16	3 1/4	3 3/8	3 3/8	3 1/4	3 1/16	2 13/16	2 1/2	2 1/8	1 11/16	1 3/16	1 1/8	81'-5 9/16	81'-6 1/16	1/4	5/8 × 50 1/2 × 82'-5 M270 GR. 50W (03002)
G3C	5/8	1 3/16	1 11/16	2 1/8	2 7/16	2 3/4	3 1/16	3 1/4	3 3/8	3 5/16	3 3/16	3	2 3/4	2 7/16	2 1/8	1 11/16	1 3/16	1 1/8	79'-7 9/16	79'-8 1/16	1/4	5/8 × 50 1/2 × 80'-7 M270 GR. 50W (03003)
G4C	5/8	1 3/16	1 11/16	2 1/8	2 7/16	2 3/4	3	3 1/8	3 1/4	3 1/4	3 1/8	2 7/8	2 5/8	2 5/16	2	1 5/8	1 1/8	1 1/8	78'-2 9/16	78'-3 1/16	3/16	5/8 × 50 1/2 × 79'-2 M270 GR. 50W (03004)
G5C	9/16	1 1/16	1 9/16	2	2 5/16	2 5/8	2 13/16	3	3 1/8	3 1/16	2 15/16	2 13/16	2 5/8	2 5/16	1 15/16	1 9/16	1 1/16	1 1/4	77'-2 15/16	77'-3 5/8	3/16	5/8 × 50 × 78'-3 M270 GR. 50W (03005)

NOTES:
FOR NOTES, SEE DWG. WC1.

RECEIVED
CK'D BY ___ OK'D BY ___
AUG 18 2008
RESUBMIT ___ APPROVED ✓
BY KMH DATE 8/19/08

NO.	REVISION	BY	CHK'D	DATE
△				
△				
△				

HOLES
BOLTS
COATING
CODE(S) 30
SCALE N.T.S.

HIGH STEEL STRUCTURES INC.
An ISO 9001:2000 Certified Company
An Affiliate of High Industries Inc.
Lancaster Facility
1915 Old Philadelphia Pike
Lancaster, PA 17605-0008
Phone (717) 299-5211
Williamsport Facility
3501 W. 4th Street
Williamsport, PA 17701
Phone (570) 326-9051
www.highsteel.com

WEB CAMBER DIAGRAMS
VT ROUTE 100 (MINOR ARTERIAL) OVER WHITE RIVER
VT ROUTE 100 STA. 141+39.00 TO STA. 143+61.00
TOWN OF STOCKBRIDGE, COUNTY OF WINDSOR, VERMONT
STATE OF VERMONT
AGENCY OF TRANSPORTATION

STATE CONT. OR REF. NO.	PROJECT NO. (STP) BRF 013-4(21)	FED. AID PROJ. NO.	
GENERAL CONTRACTOR	WINTERSET, INC.	HSSI PROJ. MGR	DEB KUPRES

SHPMT	1	DRAWING MANAGER	KREIDER (IH)	MADE BY	KMA	CHK'D. BY	SJA	DATE 5/22/08
STATE	VT	HSSI PROJECT NUMBER	S-1080077	HSSI STRUCT. ID	A	DRAWING NUMBER	WC2 OF WC2

ENGLISH
SHIPMENT 01 PM&ENG: 5004327 PRD: 5004328 SHIP&ERECT.: 5004329
BY: MKreidel
PLOTTED: 6/25/2008 3:40:16 PM

1080077A X2 8/7/08 8/Resubmit For Approval TO:Winterset, Inc.