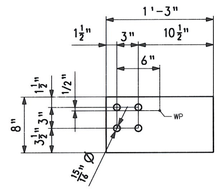

GUSSET PL. - MK. m1a

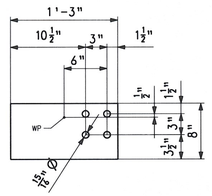

GUSSET PL. - MK. m1b

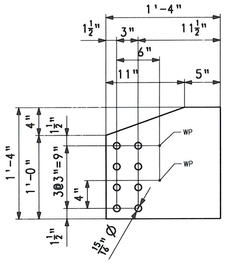

GUSSET PL. - MK. m1c

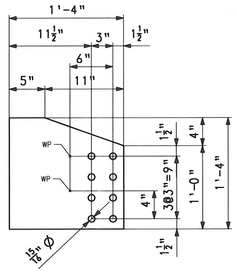

GUSSET PL. - MK. m1d

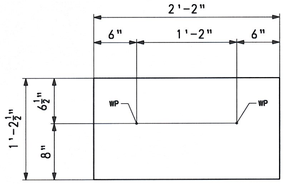

GUSSET PL. - MK. m1f

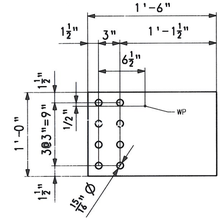

GUSSET PL. - MK. m1g

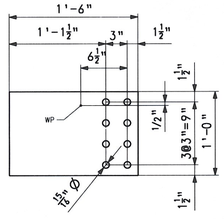

GUSSET PL. - MK. m1h

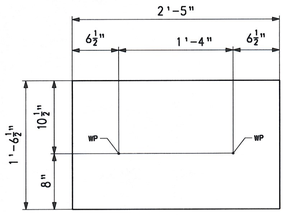

GUSSET PL. - MK. m1n

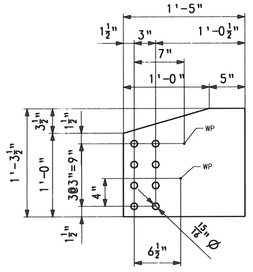

GUSSET PL. - MK. m1k

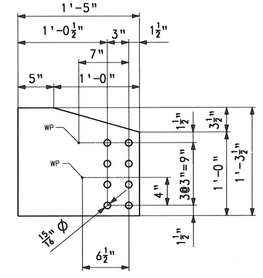

GUSSET PL. - MK. m1m

BILL OF MATERIAL

QTY	MARK	COMMODITY	DESCRIPTION	LENGTH	SPEC	GRADE	TEST	REMARKS	ITEM	GROSS WEIGHT EA.	DEDUCTED WEIGHT EA.	NET WEIGHT EA.
56	m1a	PL	1/2 x 8	1 3 1/2	M270	50W	T			17.58	0.00	17.58
56	m1b	PL	1/2 x 8	1 3 1/2	M270	50W	T			17.58	0.00	17.58
56	m1c	PL	1/2 x 16	1 4	M270	50W	T			36.30	0.00	36.30
56	m1d	PL	1/2 x 16	1 4	M270	50W	T			36.30	0.00	36.30
56	m1f	PL	1/2 x 14 1/2	2 2	M270	50W	T			53.45	0.00	53.45
4	m1g	PL	1/2 x 12	1 6	M270	50W	T			30.62	0.00	30.62
4	m1h	PL	1/2 x 12	1 6	M270	50W	T			30.62	0.00	30.62
4	m1k	PL	1/2 x 15 1/2	1 5	M270	50W	T			37.36	0.00	37.36
4	m1m	PL	1/2 x 15 1/2	1 5	M270	50W	T			37.36	0.00	37.36
4	m1n	PL	1/2 x 18 1/2	2 5	M270	50W	T			76.07	0.00	76.07

RECEIVED
CK'D BY TT OK'D BY JEL
AUG 18 2008
RESUBMIT ____ APPROVED ✓
BY KMH DATE 8/19/08

FOR SHOP NOTES, SEE DEG. GN1.

NO.	REVISION	BY	CHK'D	DATE

HIGH STEEL STRUCTURES INC.
An AISC Certified Company
An ISO 9001:2000 Certified Company
An Affiliate of High Industries Inc.
1915 Old Philadelphia Pike
Lancaster, PA 17605-0008
Phone (717) 299-5211
www.highsteel.com

HOLES	15/16" Ø
BOLTS	NONE
COATING	NONE
CODE(S)	63
SCALE	N.T.S.

MISCELLANEOUS JOB STANDARDS
VT ROUTE 100 (MINOR ARTERIAL) OVER WHITE RIVER
VT ROUTE 100 STA. 141+39.00 TO STA. 143+61.00
TOWN OF STOCKBRIDGE, COUNTY OF WINDSOR, VERMONT
STATE OF VERMONT
AGENCY OF TRANSPORTATION

STATE CONT. OR REF. NO.	PROJ. NO.(STP)BRF 013-4(21)			FED. AID PROJ. NO.				
GENERAL CONTRACTOR	WINTERSET, INC.			HSSI PROJ. MGR	DEB KUPRES			
SHPMT 1	DRAWING MANAGER	KREIDER (IH)	MADE BY	SSL	CHK'D. BY	CS	DATE	6-19-08
STATE VT	HSSI PROJECT NUMBER	S-1080077	HSSI STRUCT. ID	A	DRAWING NUMBER	M1 OF M1		

1080077A X2 8/7/08 8/Resubmit For Approval TO:Winterset, Inc.

SHIPMENT 1 PMENG: 5004327 PRD: 5004328 SHIPMGERECT: 5004329
PLOTTED: 06/25/08 16:13:27 BY: SLaudeng