BOX BEAM GUARDRAIL
STA 201+85.61 TO STA 203+74.12 LT
STA 204+06.71 TO STA 205+50.00 LT
STA 204+36.31 TO STA 205+44.40 RT

COLD PLANING, BITUMINOUS PAVEMENT
STA 200+45.00 TO STA 201+45.00

MANUFACTURED TERMINAL SECTION, TANGENT
STA 204+21.87 TO STA 204+36.31 RT

DELINEATOR WITH STEEL POST
VT 100 STA 201+85.00 LT (GREEN)
VT 100 STA 203+45.00 LT (BLUE)
VT 100 STA 204+06.00 LT (GREEN)
VT 100 STA 204+22.00 RT (GREEN)

SPECIAL PROVISION (GUARDRAIL APPROACH SECTION, GALVANIZED 2 RAIL BOX BEAM
STA 205+44.40 TO STA 205+50.00 RT

CONSTRUCT DRIVE (BITUMINOUS CONCRETE PAVEMENT)
STA 203+75.00 LT (55'-8" LENGTH x 16'-0" WIDE)

REMOVAL AND DISPOSAL OF GUARDRAIL
STA 205.38.37 TO STA 205+50.00 LT
STA 205+15.49 TO STA 205+50.00 RT

VT-100 CURVE #1
DELTA = 49°40'45"
D = 10°16'22"
R = 557.74'
T = 258.18'
L = 483.60'
E = 56.86'

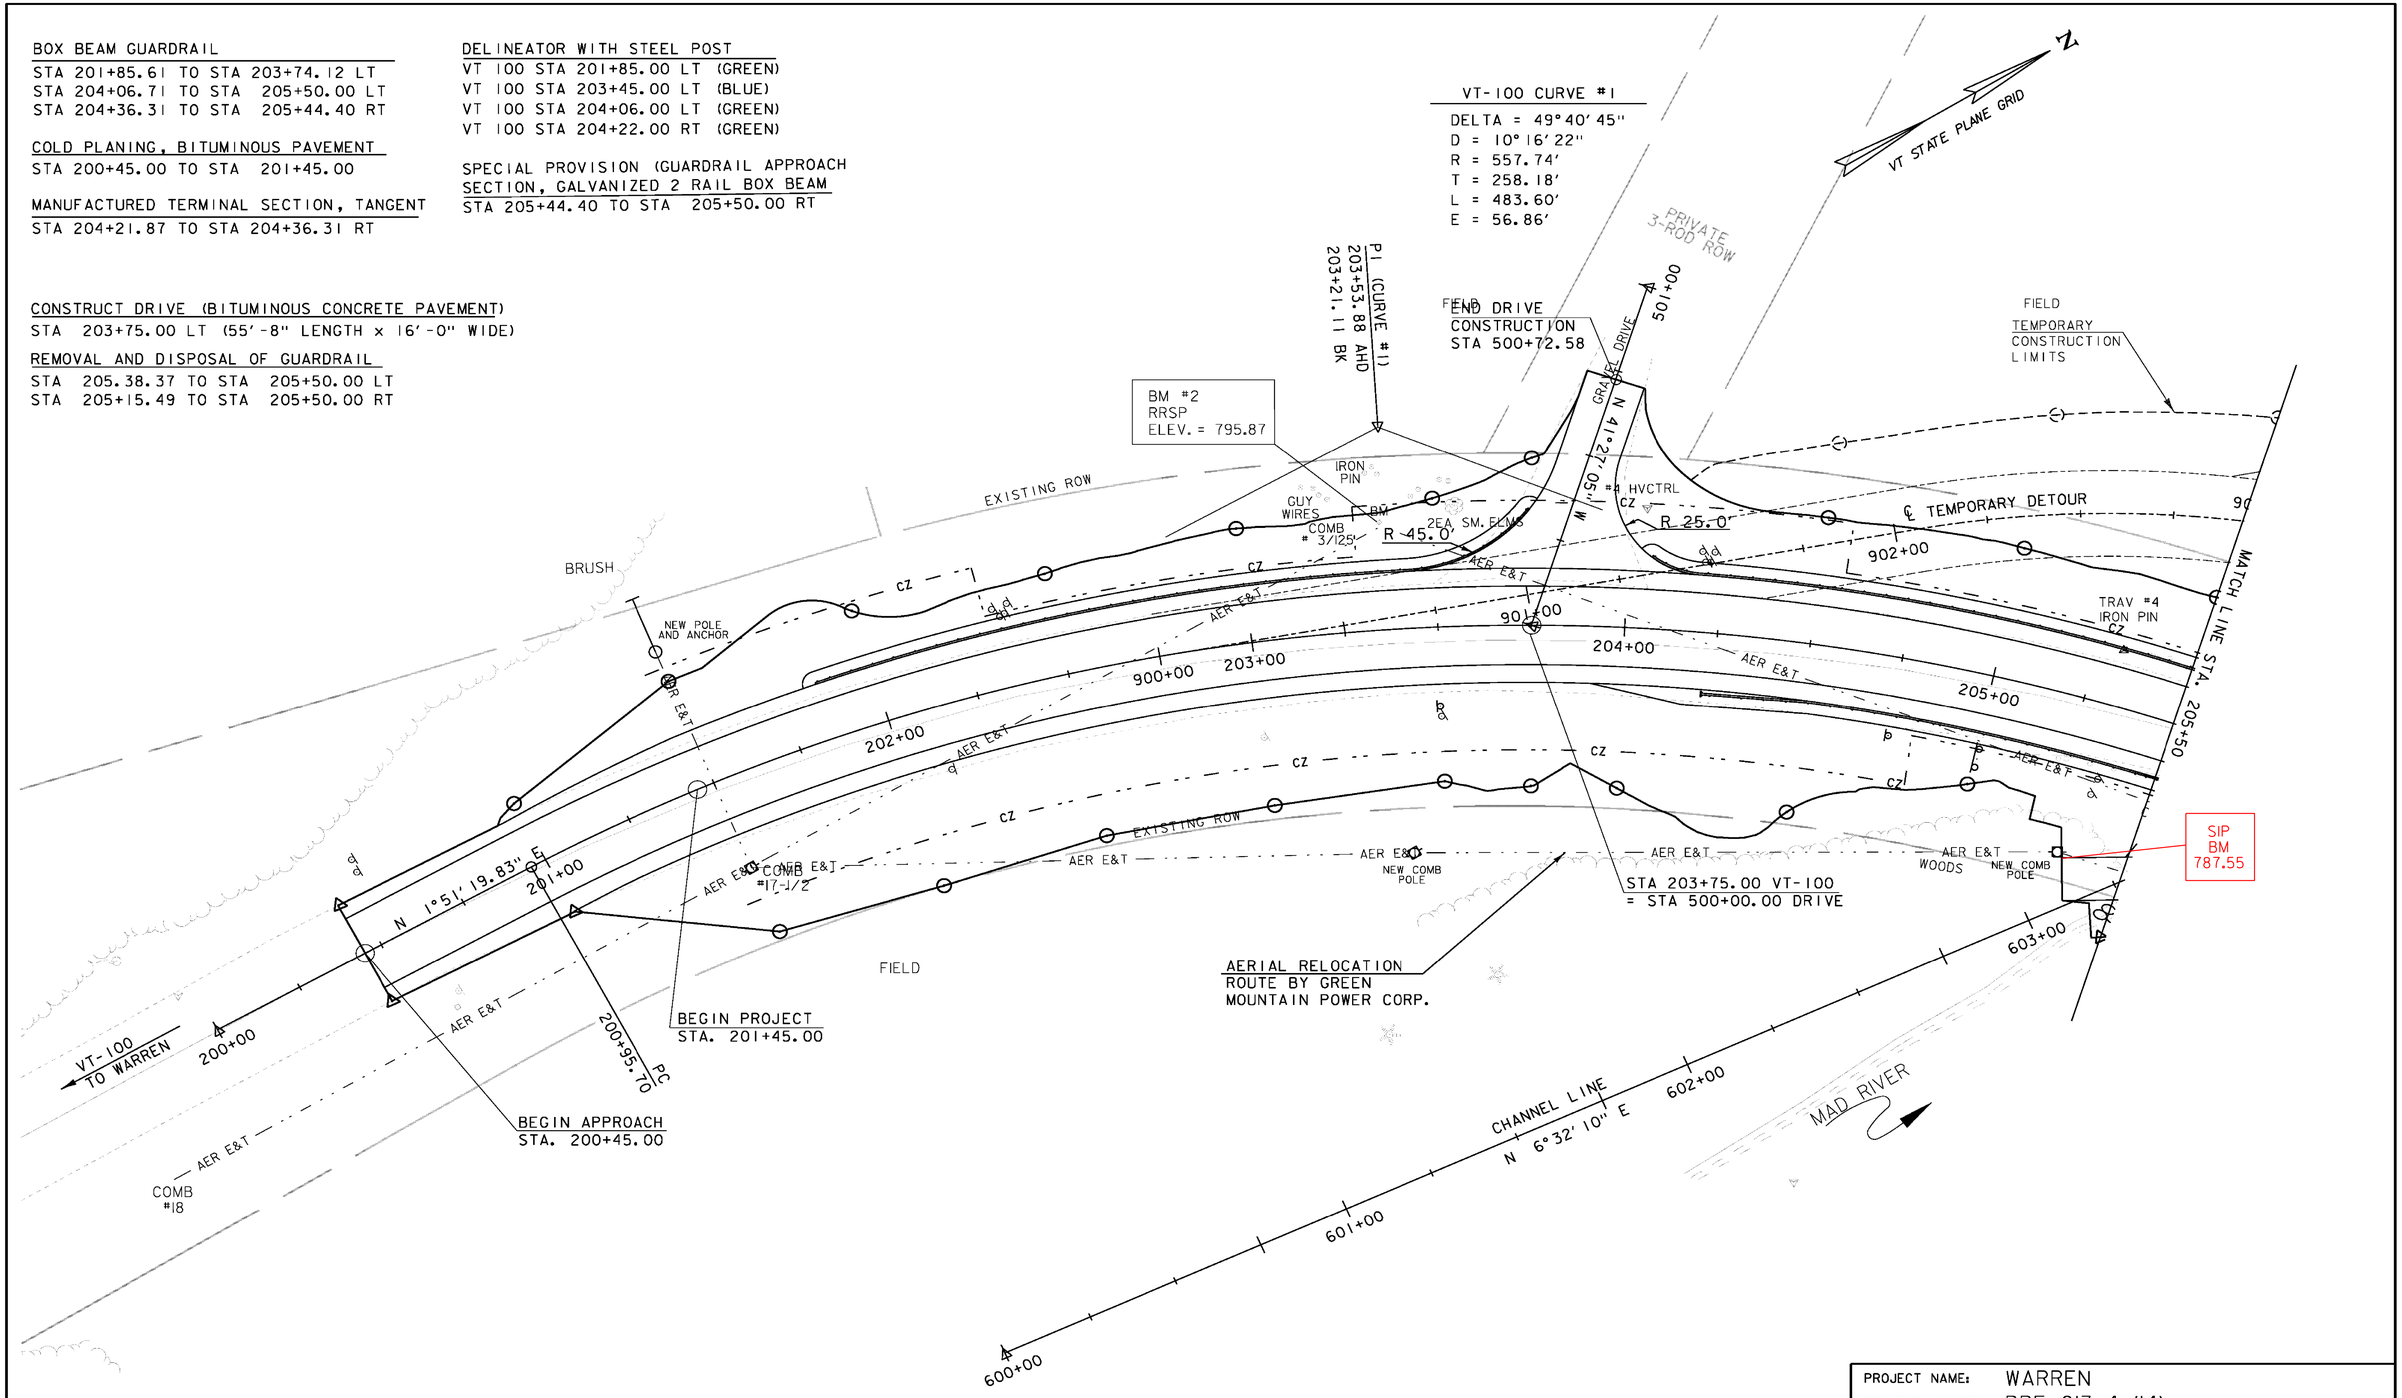

SCALE 1" = 20'-0"
20 0 20

PROJECT NAME: WARREN	
PROJECT NUMBER: BRF 013-4 (14)	
FILE NAME: s78f242bdr.dgn	PLOT DATE: 27-JUL-2012
PROJECT LEADER: J. LACROIX	DRAWN BY: G. ROKES
DESIGNED BY: U. STANLEY	CHECKED BY: U. STANLEY
LAYOUT SHEET 1	SHEET 14 OF 83