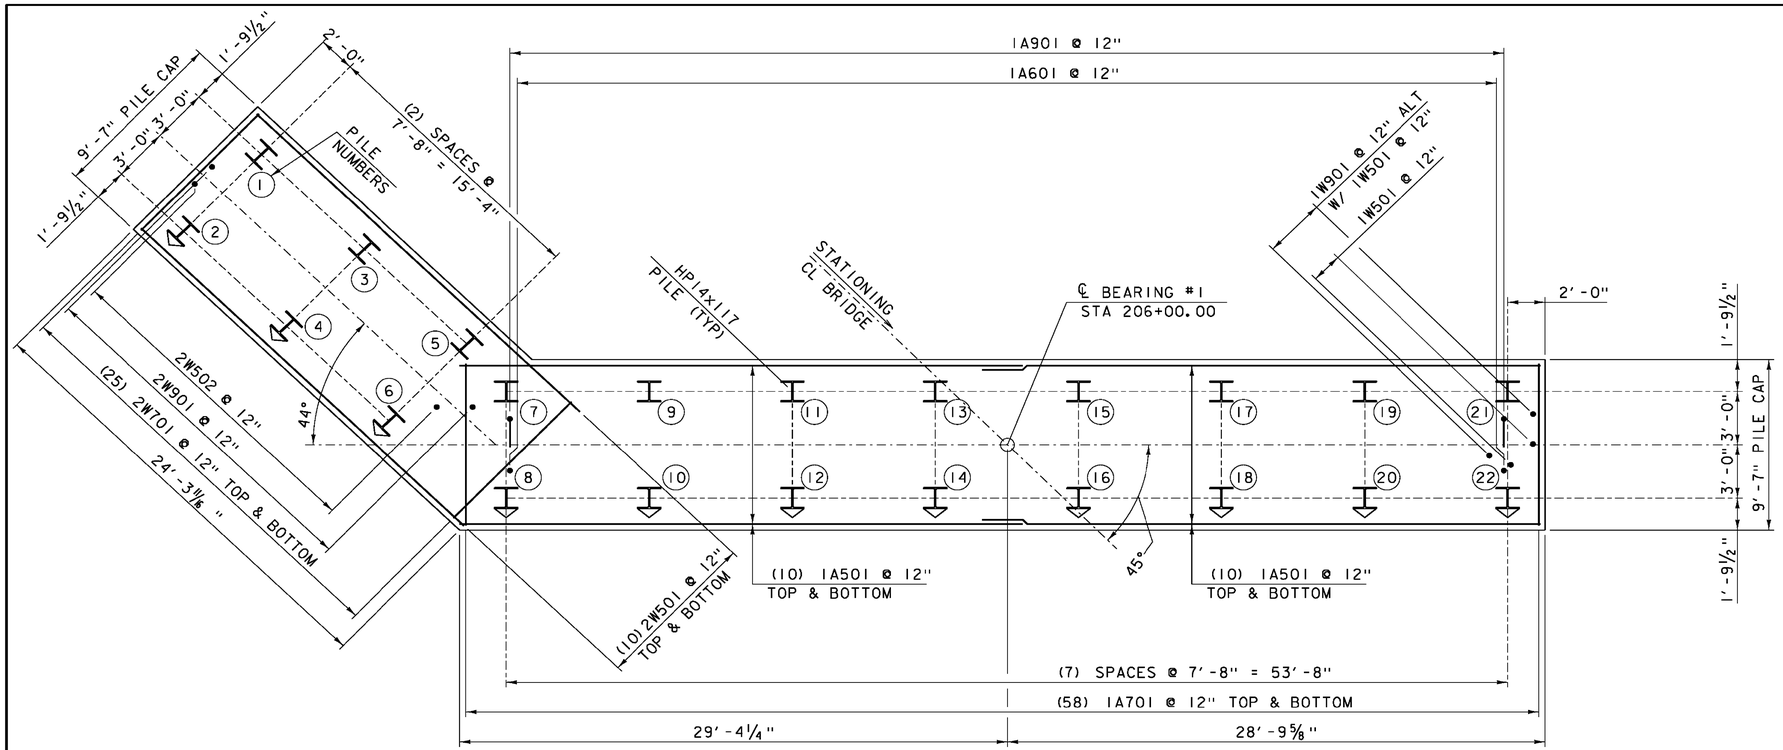

ABUTMENT #1 PILE CAP PLAN

SCALE ¼" = 1'-0"

HP14x117 BATTERED PILE

SEE REVISED PAGE

NOTE:

NF = NEAR FACE
FF = FAR FACE
EF = EACH FACE
▲ = CUT TO FIT IN FIELD
3" CLEAR, UNLESS OTHERWISE SPECIFIED ON THE PLANS.
2'-2" BAR LAP UNLESS OTHERWISE SPECIFIED ON THE PLANS.

PROJECT NAME: WARREN	
PROJECT NUMBER: BRF 013-4 (14)	
FILE NAME: s78f242sub.dgn	PLOT DATE: 27-JUL-2012
PROJECT LEADER: J.LACROIX	DRAWN BY: M.LONGSTREET
DESIGNED BY: U.STANLEY	CHECKED BY: U. STANLEY
ABUTMENT #1 PILE CAP PLAN	SHEET 54 OF 83