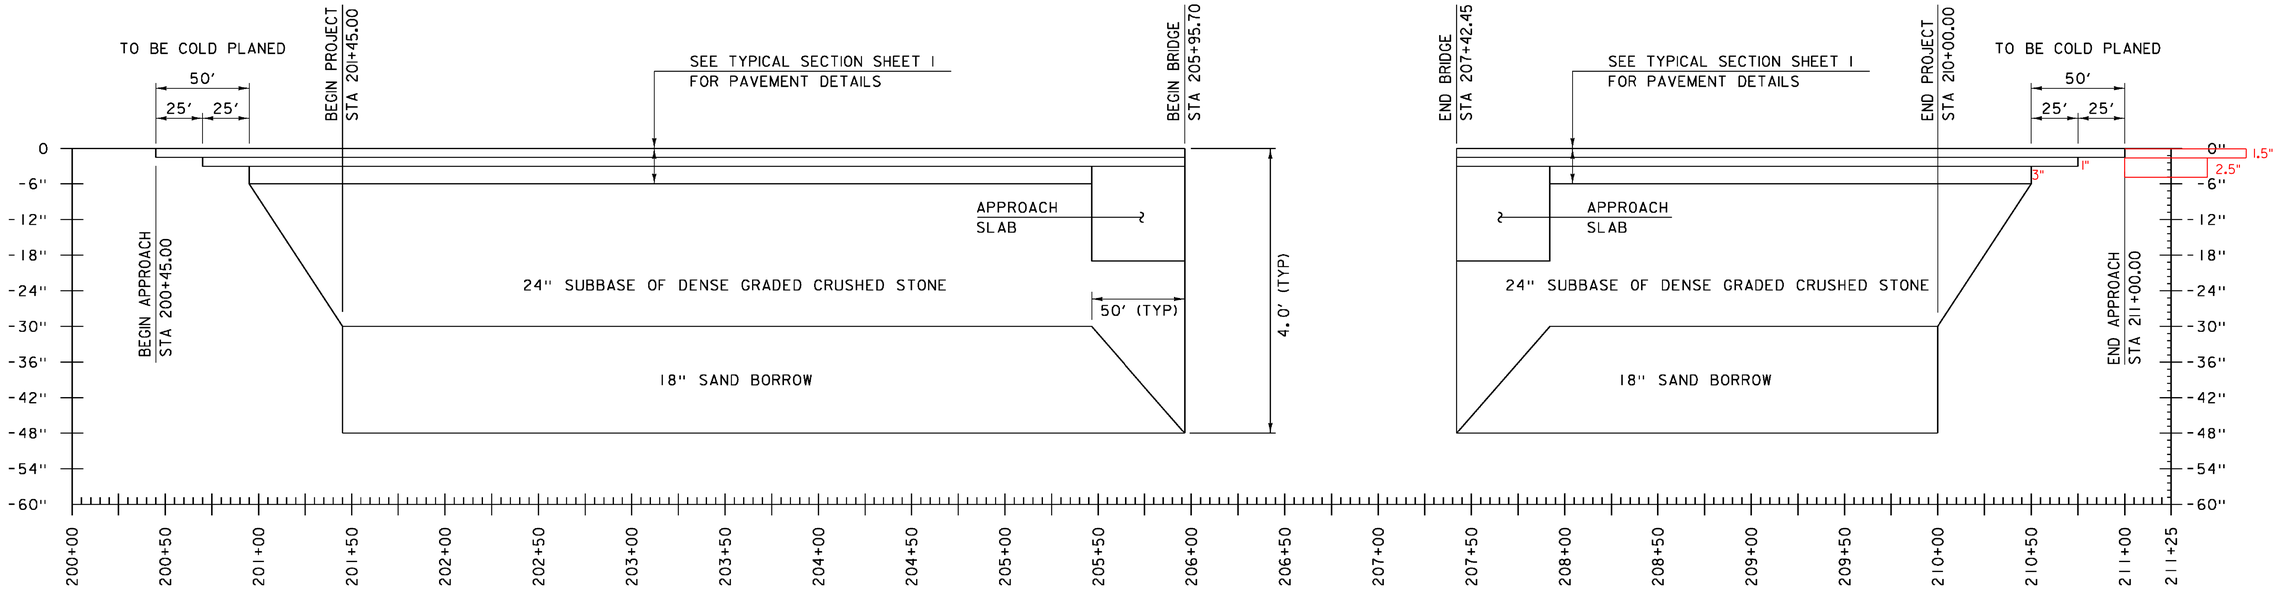

MATERIAL TRANSITION

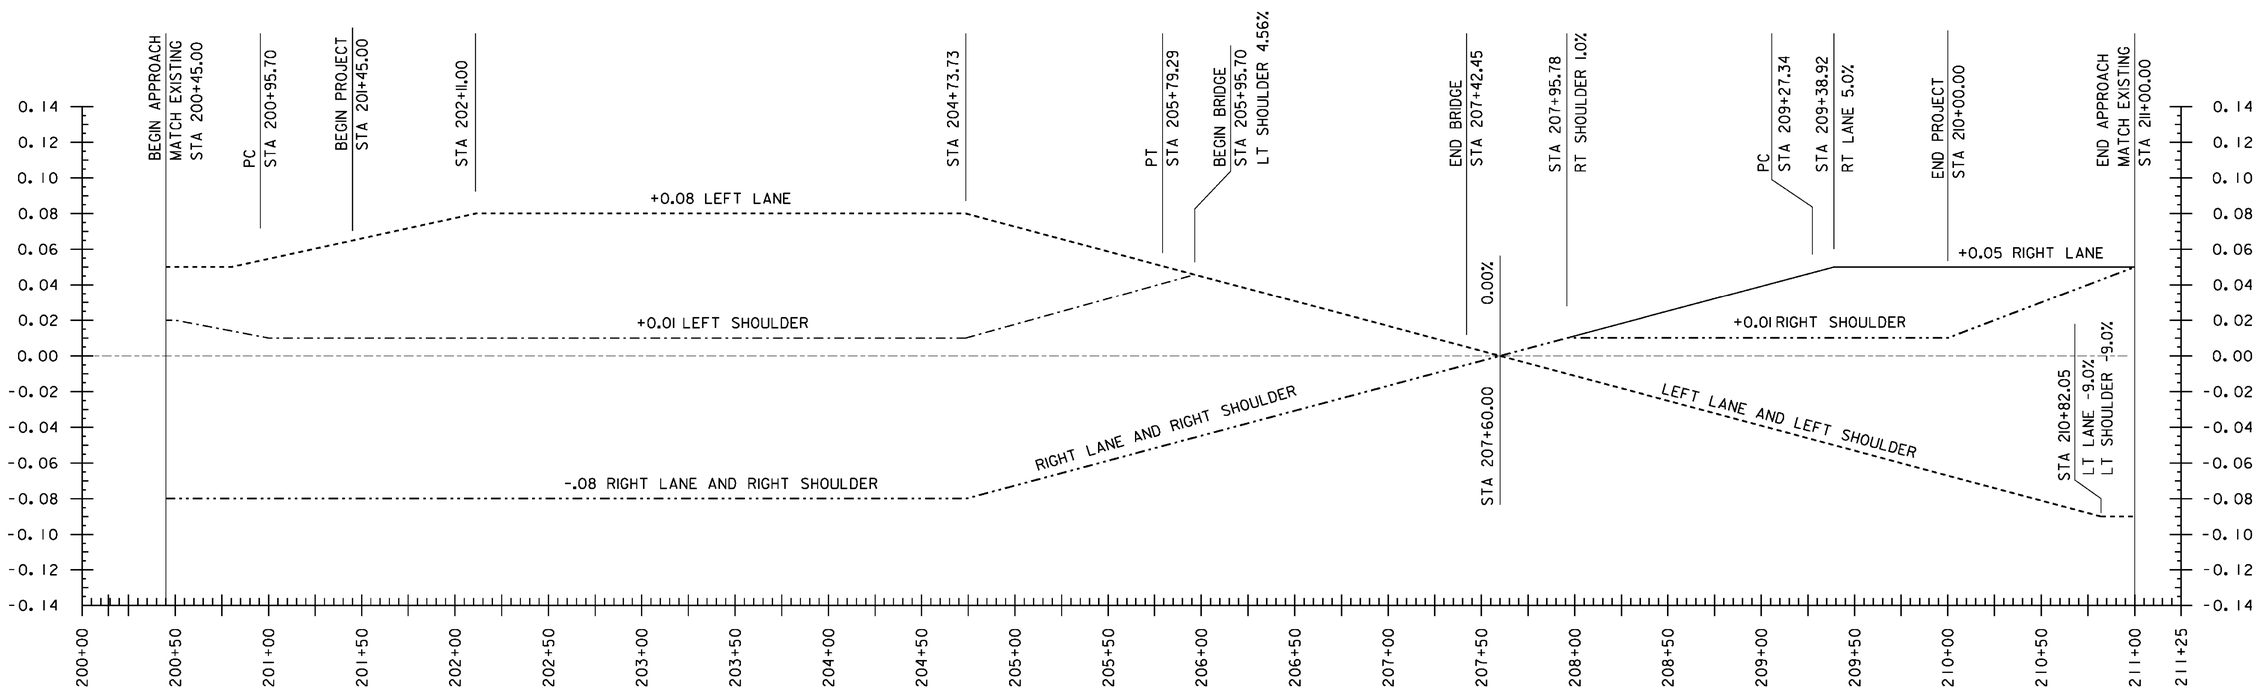

BANKING DIAGRAM

PROJECT NAME: WARREN	
PROJECT NUMBER: BRF 013-4 (14)	
FILE NAME: s78f242xs.dgn	PLOT DATE: 27-JUL-2012
PROJECT LEADER: J. LACROIX	DRAWN BY: M. LONGSTREET
DESIGNED BY: U. STANLEY	CHECKED BY: U. STANLEY
MATERIAL TRANSITION & BANKING DIAGRAM	SHEET 60 OF 83