DATE PLOTTED June 24, 2013

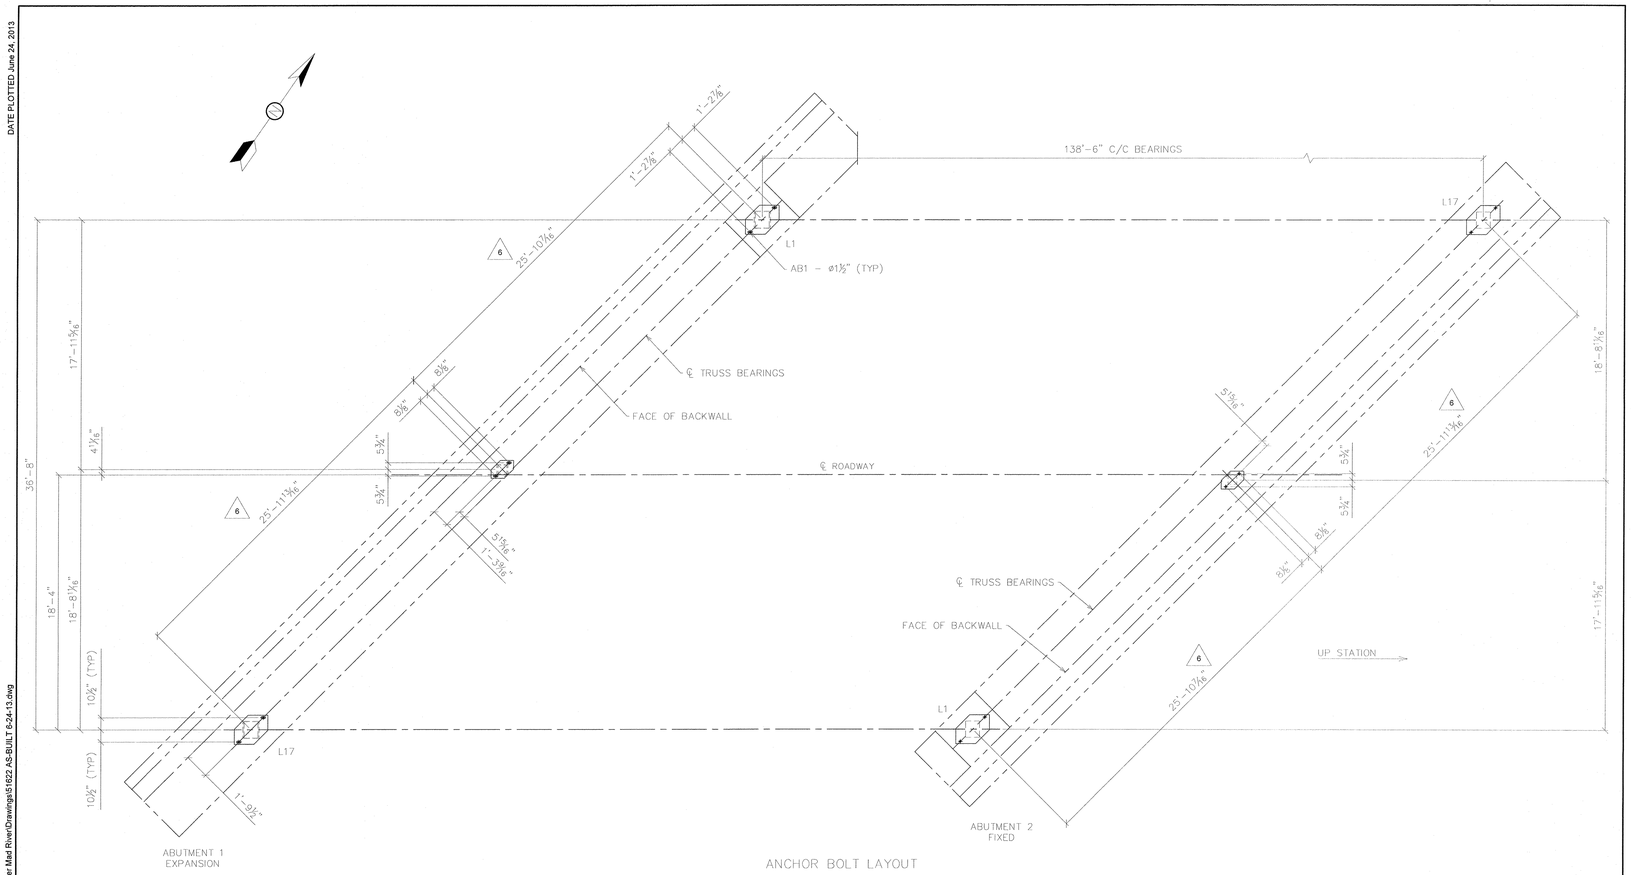


ANCHOR BOLT LAYOUT

RECORD DWGS
AS FABRICATED
6/24/13

S:\JOBS\VERMONT\51622-Gyk-Truss-138'6 x 35'-Vernon,VT over Mad River\Drawings\51622-AS-BUILT 6-24-13.dwg

SYMBOLS & ABBREVIATIONS

| | |
|---|---|
| ES: EACH SIDE | NS: NEAR SIDE |
| EQ: EQUAL | FS: FAR SIDE |
| ℄: CENTERLINE | WP/✥: WORK POINT |
| REF: REFERENCE | GA: GAUGE |
| CHK: CHECK | ID: INSIDE DIAMETER |
| O\O: OUT TO OUT | OD: OUTSIDE DIAMETER |
| C\C: CENTER TO CENTER | BRG: BEARING |
| F\F: FACE TO FACE | TYP: TYPICAL |
| DIA/ø: DIAMETER | UNO: UNLESS NOTED OTHERWISE |
| R: RADIUS | ABUT: ABUTMENT |
| | T&B: TOP & BOTTOM |

DIST. BY: CONTECH® CONSTRUCTION PRODUCTS INC. www.contech-cpi.com

FAB. BY: U.S. BRIDGE® BRIDGING AMERICA SINCE 1936

| SUBMITTAL LOG | DATE |
|---|---|
| INITIAL SUBMITTAL | 12/18/12 |
| RESUBMITTAL NO. 2 | 2/5/13 |
| CUSTOMER APPROVAL | 2/13/13 |
| SHOP REVIEW | - |
| PRE FAB MTG | - |
| APPROVED FOR FAB | 2/28/13 |

| NO: | DATE: | REVISIONS: | BY: |
|---|---|---|---|
| 1 | 5/15/13 | FLOOR BEAM END PLATES WAS 1" THK | TLB |
| 2 | 5/15/13 | ADDED 2" DIA. RAT HOLES IN fb1 & fb9 | TLB |
| 3 | 5/15/13 | CHANGED WELD WAS ⅜" ALL AROUND | TLB |
| 4 | 5/15/13 | CHANGED BOLT PATTERN | TLB |
| 5 | 5/15/13 | WAS 2" EDGE DISTANCE | TLB |
| 6 | 6/3/13 | DIMENSIONAL ERRORS | TLB |

00000001.jpg

TOWN OF WARREN, VT
COUNTY OF WASHINGTON
BRIDGE NO.173 REPLACEMENT
WARREN, VT

ITEM NO.:
PROJECT NO.: BRF 013-4 (14)
REFERENCE NO.:
BRIDGE NO.: 173
STRUCTURAL FILE NO.:

DESIGN: SAF | DRAW: TLB | REVIEW: SAF/RLL | CHECK: CJC

CONSTRUCTION PLANS / ABUTMENTS

USB JOB# 51622

SHEET 4 / 58 TOTAL