DATE PLOTTED: June 24, 2013

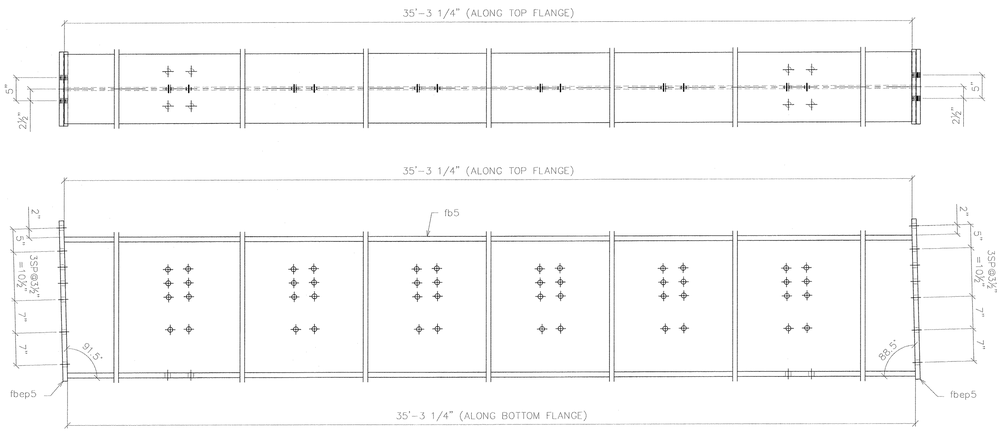

1 - FLOOR BEAM - FB5
(6585 lbs)

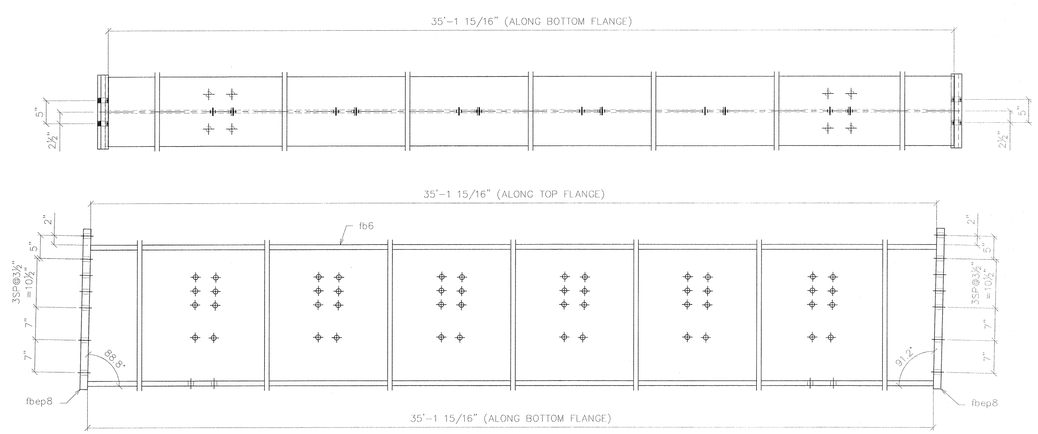

1 - FLOOR BEAM - FB6
(6585 lbs)

RECORD DWGS
AS FABRICATED
6/24/13

S:\JOBS\VERMONT\51622-Gale-Truss-138'8 x 35'-Warren\VT over Mad River\Drawings\51622_AS-BUILT 6-24-13.dwg

SYMBOLS & ABBREVIATIONS

ES: EACH SIDE	NS: NEAR SIDE
EQ: EQUAL	FS: FAR SIDE
℄: CENTERLINE	WP/✥: WORK POINT
REF: REFERENCE	GA: GAUGE
CHK: CHECK	ID: INSIDE DIAMETER
O\O: OUT TO OUT	OD: OUTSIDE DIAMETER
C\C: CENTER TO CENTER	BRG: BEARING
F\F: FACE TO FACE	TYP: TYPICAL
DIA/⌀: DIAMETER	UNO: UNLESS NOTED OTHERWISE
R: RADIUS	ABUT: ABUTMENT
	T&B: TOP & BOTTOM

DIST. BY: CONTECH® CONSTRUCTION PRODUCTS INC. www.contech-cpi.com

FAB. BY: U.S. BRIDGE® BRIDGING AMERICA SINCE 1936

SUBMITTAL LOG	DATE
INITIAL SUBMITTAL	12/18/12
RESUBMITTAL NO. 2	2/5/13
CUSTOMER APPROVAL	2/13/13
SHOP REVIEW	-
PRE FAB MTG	-
APPROVED FOR FAB	2/28/13

NO:	DATE:	REVISIONS:	BY:
1	5/15/13	FLOOR BEAM END PLATES WAS 1" THK	TLB
2	5/15/13	ADDED 2" DIA. RAT HOLES IN fb1 & fb9	TLB
3	5/15/13	CHANGED WELD WAS 3/16" ALL AROUND	TLB
4	5/15/13	CHANGED BOLT PATTERN	TLB
5	5/15/13	WAS 2" EDGE DISTANCE	TLB
6	6/3/13	DIMENSIONAL ERRORS	TLB

00000001.jpg

TOWN OF WARREN, VT
COUNTY OF WASHINGTON
BRIDGE NO.173 REPLACEMENT
WARREN, VT

ITEM NO.:
PROJECT NO.: BRF 013-4 (14)
REFERENCE NO.:
BRIDGE NO.: 173
STRUCTURAL FILE NO.:

DESIGN: SAF | DRAW: TLB | REVIEW: SAF/RLL | CHECK: CJG

SHOP DETAILS / SHOP ASSEMBLY

USB JOB# 51622

SHEET 8b / 58 TOTAL