DATE PLOTTED June 24, 2013

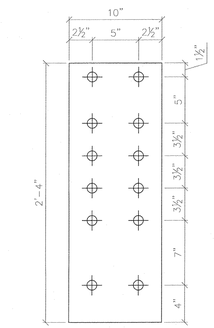

2 – FLOOR BEAM END PLATE – fbep1
Plate 3/4"x2'-4" (10") GALV

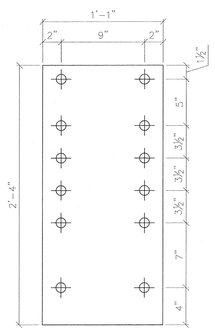

4 – FLOOR BEAM END PLATE – fbep2
Plate 3/4"x2'-4" (1'-1") GALV

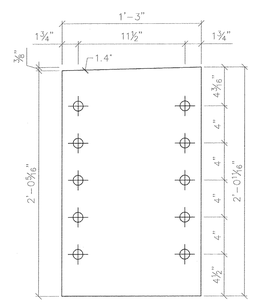

1 – FLOOR BEAM END PLATE – fbep3
Plate 3/4"x2'-0 11/16" (1'-3") GALV

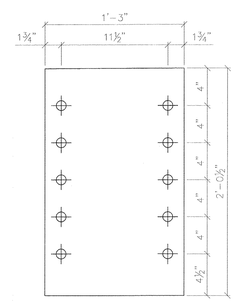

1 – FLOOR BEAM END PLATE – fbep4
Plate 3/4"x2'-0 1/2" (1'-3") GALV

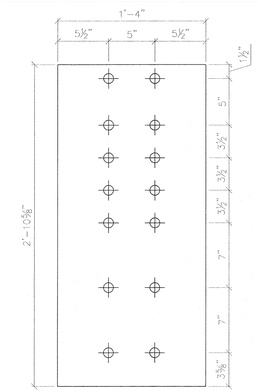

1 6 – FLOOR BEAM END PLATE – fbep5
Plate 1"x2'-10 5/8" (1'-4") GALV

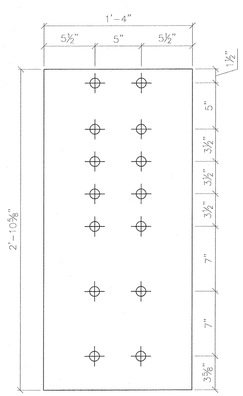

1 2 – FLOOR BEAM END PLATE – fbep6
Plate 2 1/4"x2'-10 5/8" (1'-4") GALV

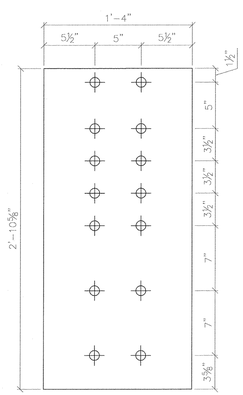

1 2 – FLOOR BEAM END PLATE – fbep7
Plate 2"x2'-10 5/8" (1'-4") GALV

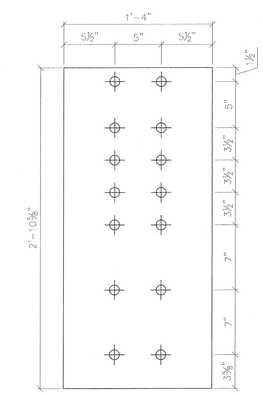

1 2 – FLOOR BEAM END PLATE – fbep8
Plate 1 5/8"x2'-10 5/8" (1'-4") GALV

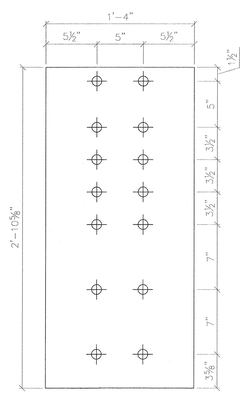

1 2 – FLOOR BEAM END PLATE – fbep9
Plate 1 3/8"x2'-10 5/8" (1'-4") GALV

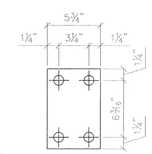

46 – SPACER PLATE – sp1
Plate 1/2"x8 11/16" (5 3/4") GALV

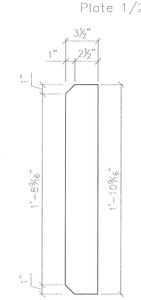

16 – JACKING GUSSET – jg1
Plate 1/2"x1'-10 9/16" (3 1/2") GALV

1 13/16"ø HOLES UNO

RECORD DWGS
AS FABRICATED
6/24/13

SYMBOLS & ABBREVIATIONS

ES: EACH SIDE	NS: NEAR SIDE
EQ: EQUAL	FS: FAR SIDE
℄: CENTERLINE	WP/✥: WORK POINT
REF: REFERENCE	GA: GAUGE
CHK: CHECK	ID: INSIDE DIAMETER
O\O: OUT TO OUT	OD: OUTSIDE DIAMETER
C\C: CENTER TO CENTER	BRG: BEARING
F\F: FACE TO FACE	TYP: TYPICAL
DIA/ø: DIAMETER	UNO: UNLESS NOTED OTHERWISE
R: RADIUS	ABUT: ABUTMENT
	T&B: TOP & BOTTOM

DIST. BY: CONTECH® CONSTRUCTION PRODUCTS INC. www.contech-cpi.com

FAB. BY: U.S. BRIDGE® BRIDGING AMERICA SINCE 1936

SUBMITTAL LOG	DATE	NO:	DATE:	REVISIONS:	BY:
INITIAL SUBMITTAL	12/18/12	1	5/15/13	FLOOR BEAM END PLATES WAS 1" THK	TLB
RESUBMITTAL NO. 2	2/5/13	2	5/15/13	ADDED 2" DIA. RAT HOLES IN fb1 & fb9	TLB
CUSTOMER APPROVAL	2/13/13	3	5/15/13	CHANGED WELD WAS 5/16" ALL AROUND	TLB
SHOP REVIEW	-	4	5/15/13	CHANGED BOLT PATTERN	TLB
PRE FAB MTG	-	5	5/15/13	WAS 2" EDGE DISTANCE	TLB
APPROVED FOR FAB	2/28/13	6	6/3/13	DIMENSIONAL ERRORS	TLB

00000001.jpg

TOWN OF WARREN, VT
COUNTY OF WASHINGTON
BRIDGE NO.173 REPLACEMENT
WARREN, VT

ITEM NO.:
PROJECT NO.: BRF 013-4 (14)
REFERENCE NO.:
BRIDGE NO.: 173
STRUCTURAL FILE NO.:

DESIGN: SAF | DRAW: TLB | REVIEW: SAF/RLL | CHECK: CJG

SHOP DETAILS | PLATES | USB JOB# 51622 | SHEET 10a / 58 TOTAL

S:\JOBS\VERMONT\51622-Gale\Truss-138'6 x 35'-Warren\VT over Mad River\Drawings\51622 AS-BUILT 6-24-13.dwg