FED. ROAD DIST. NO.	STATE	FAS PROJ. NO.	FISCAL YEAR	SHEET NO.
9	VT.	18-A	1939	4

SEE SHEET 122 OF 420

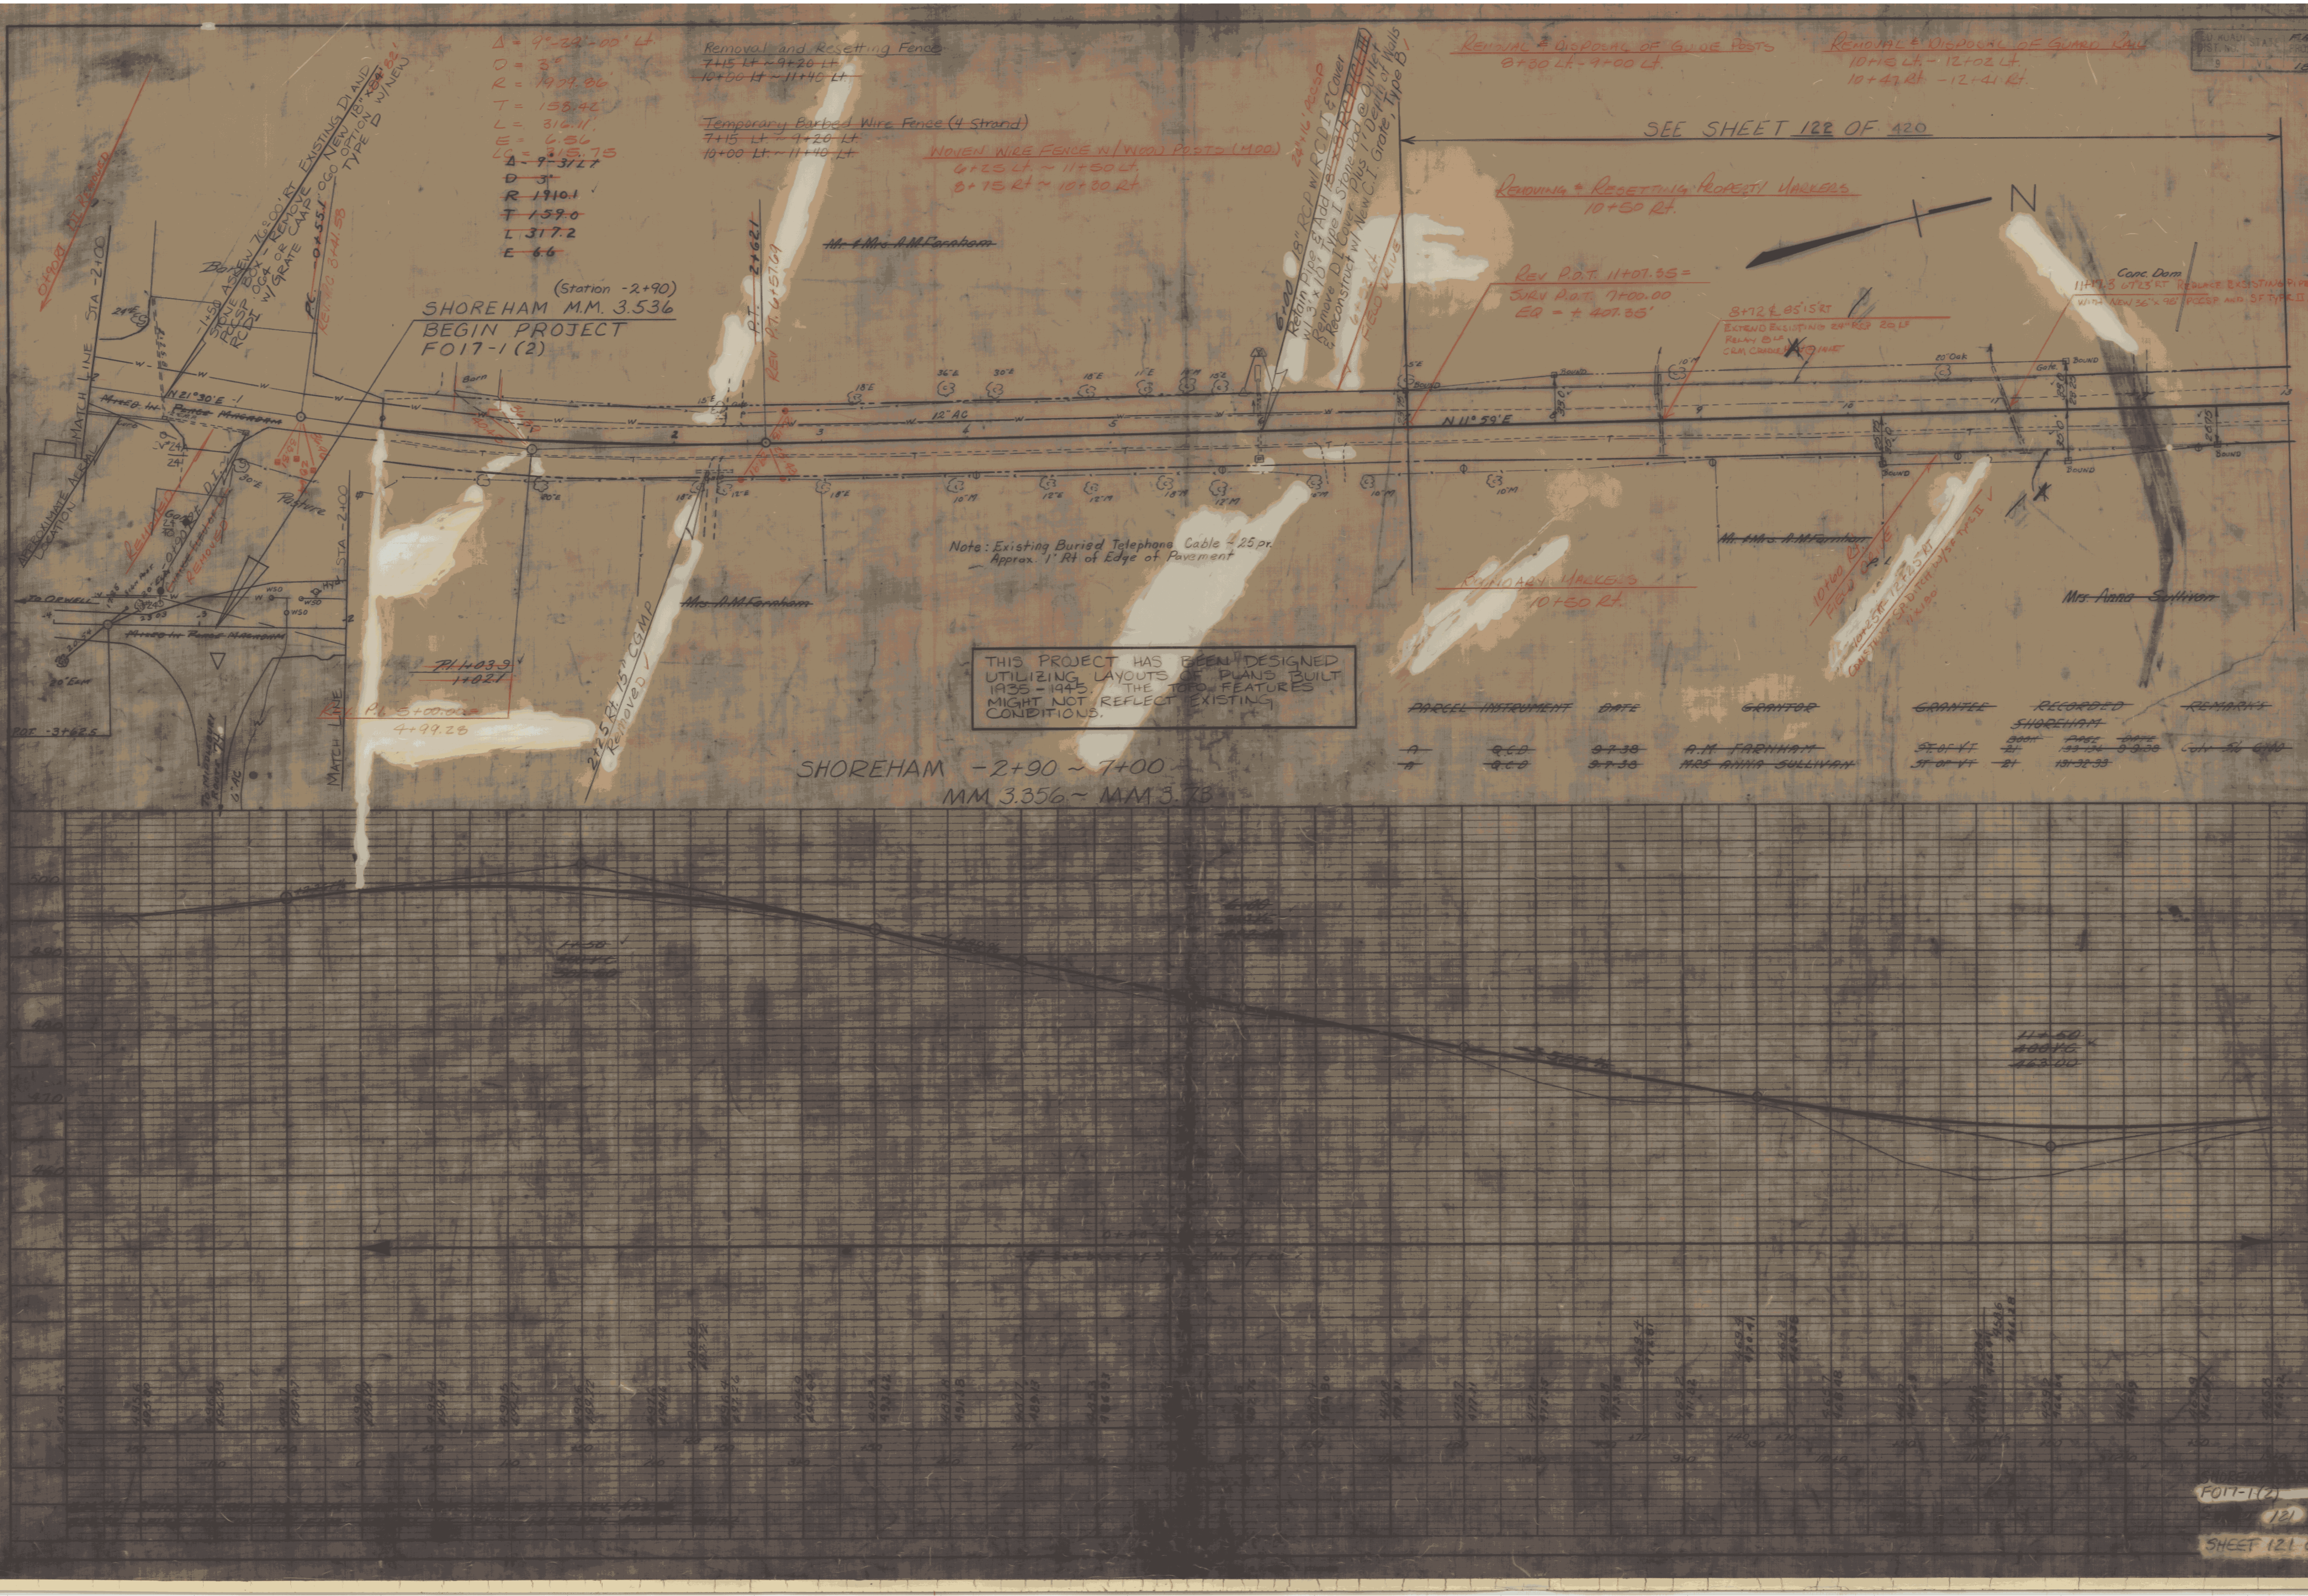

THIS PROJECT HAS BEEN DESIGNED UTILIZING LAYOUTS OF PLANS BUILT 1935 - 1945. THE TOPO FEATURES MIGHT NOT REFLECT EXISTING CONDITIONS.

SHOREHAM -2+90 ~ 7+00
MM 3.356 ~ MM 3.73

~~PARCEL~~	~~INSTRUMENT~~	~~DATE~~	~~GRANTOR~~	~~GRANTEE~~	~~RECORDED SHOREHAM BOOK~~	~~PAGE~~	~~DATE~~	~~REMARKS~~
~~A~~	~~Q.C.D.~~	~~9-7-38~~	~~A.M. FARNHAM~~	~~ST. OF VT.~~	~~21~~	~~133-134~~	~~9-9-38~~	~~Conv. Slo. Grad~~
~~A~~	~~Q.C.D.~~	~~9-7-38~~	~~MRS ANNA SULLIVAN~~	~~ST. OF VT.~~	~~21~~	~~131-32-33~~		

F017-1(2)
121 420
SHEET 121 OF 477