FED. ROAD DIST. NO.	STATE	FAS PROJ. NO.	FISCAL YEAR	SHEET NO.	TOTAL SHEETS
5	V	18-A	1939	8	47

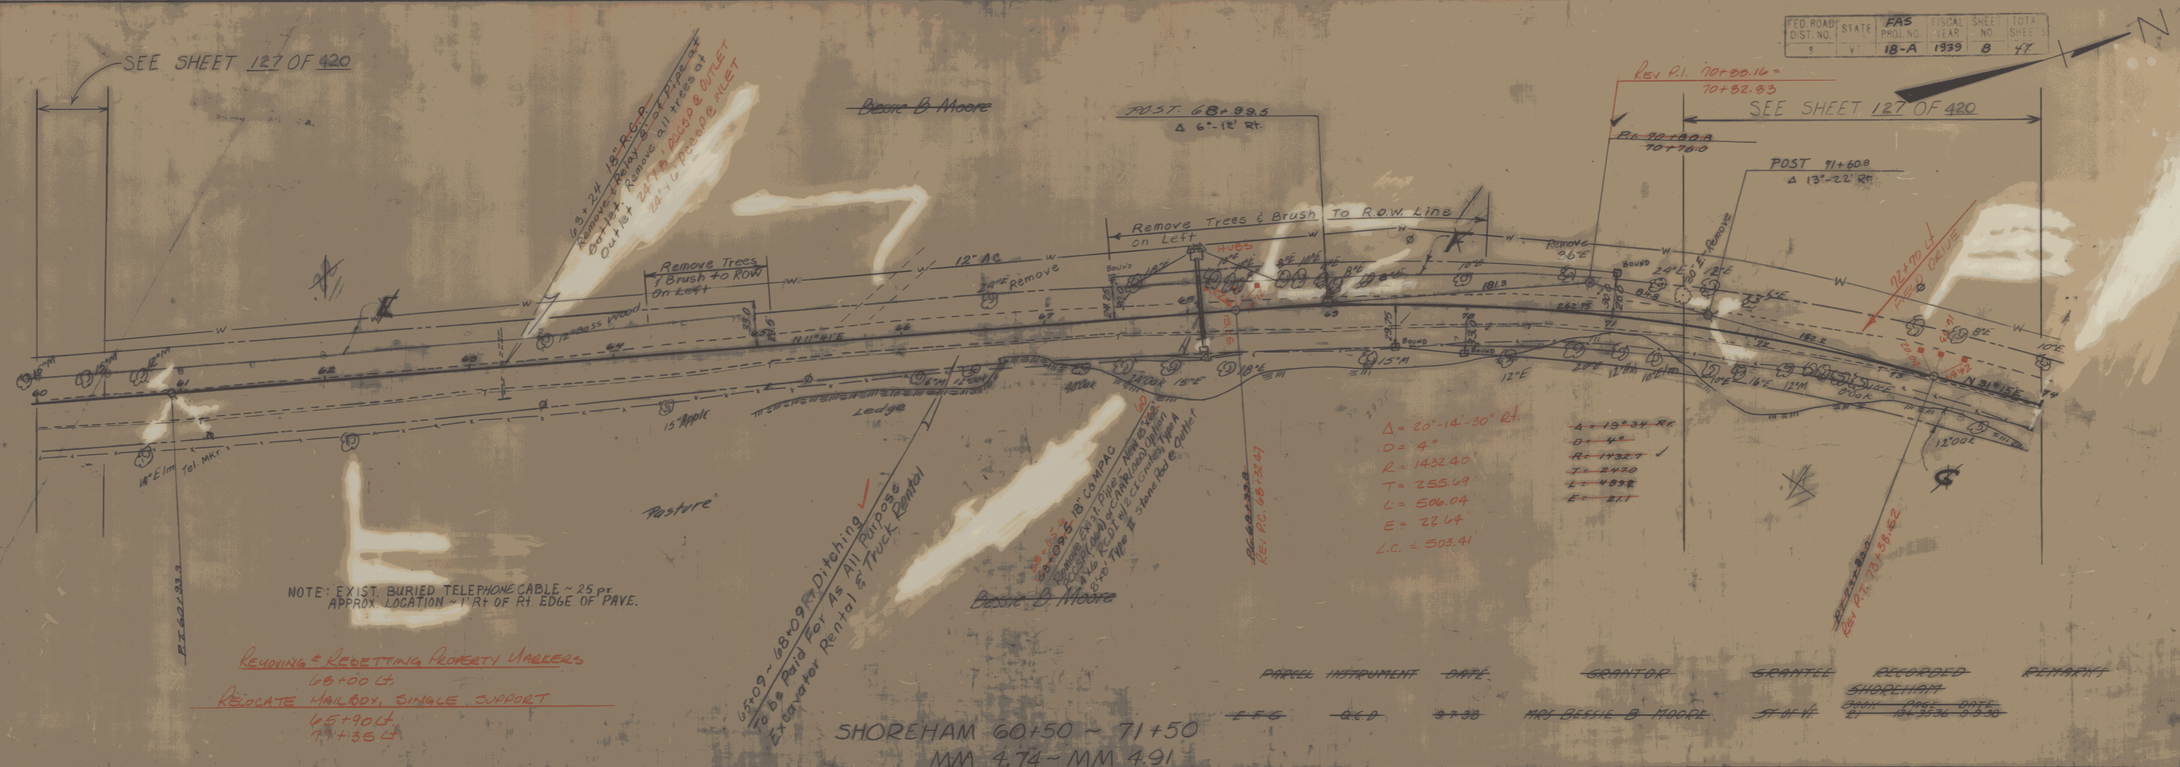

PARCEL	INSTRUMENT	DATE	GRANTOR	GRANTEE	RECORDED	REMARKS
					SHORELAND PROJ. PARCEL DATE BY	
E F G	9269	9-2-38	MRS BESSIE B MOORE	STATE	18-9336 9-2-38	

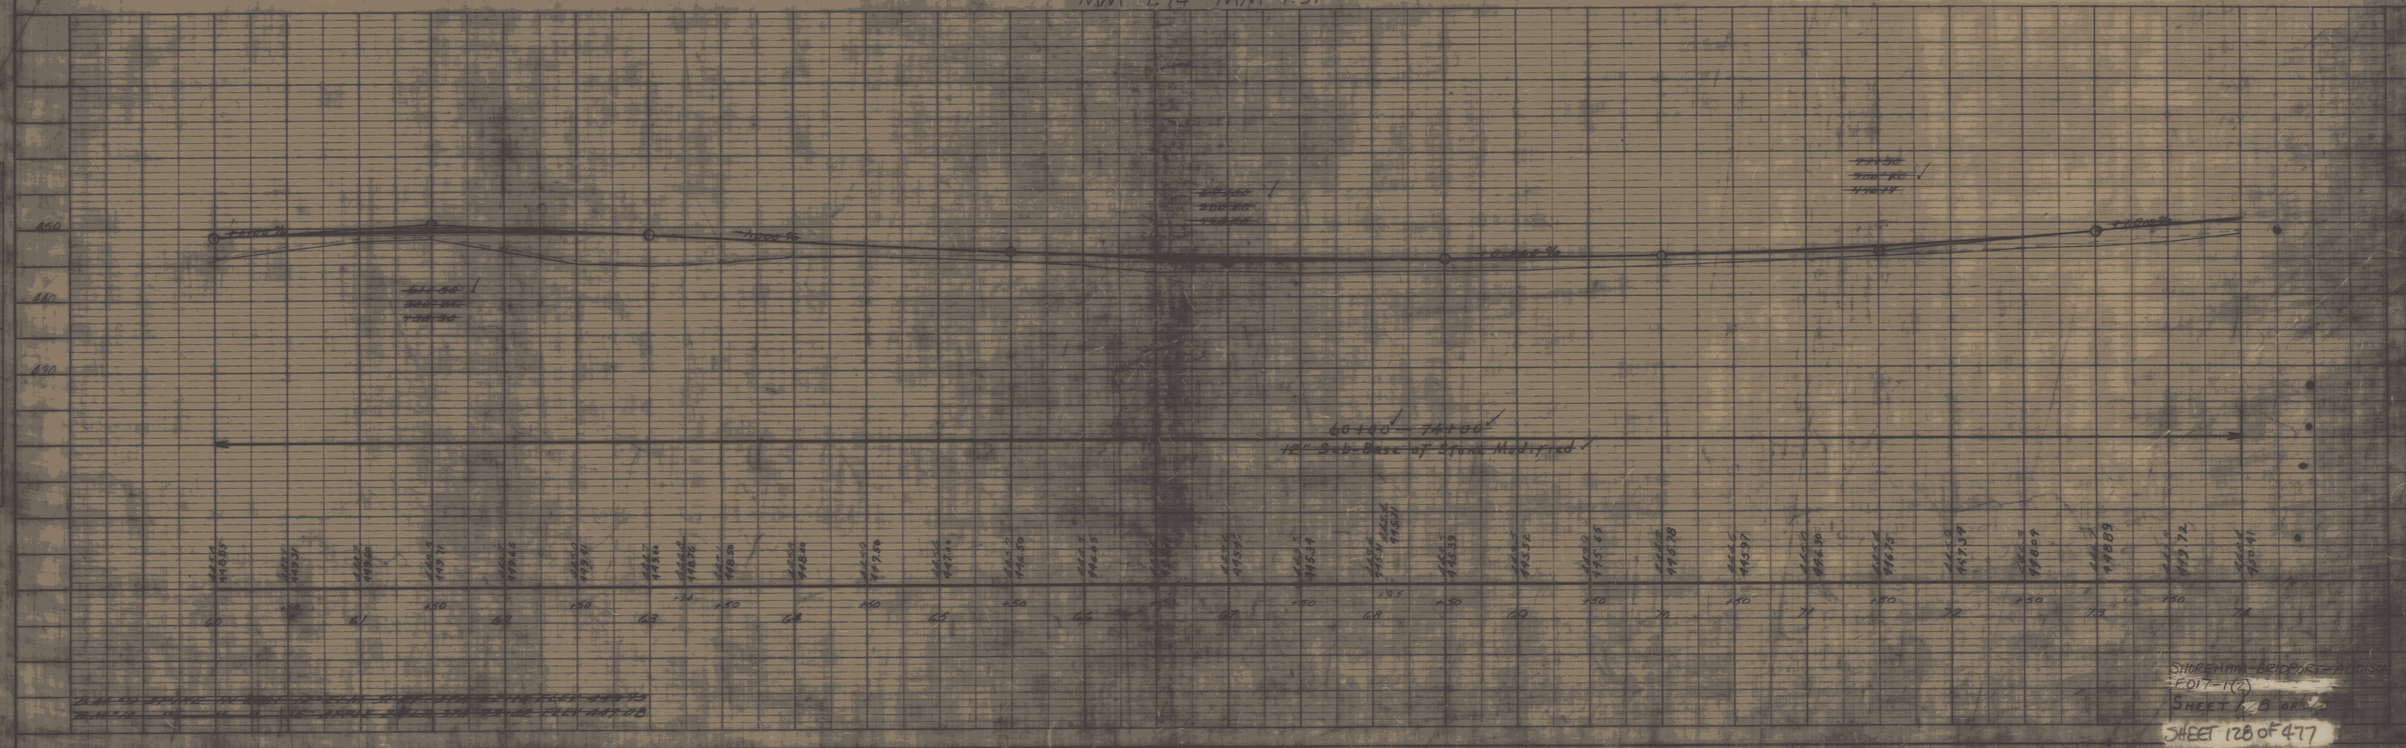

F017-1(2)
SHEET 128 OF 477