~~PARCEL~~	~~INSTRUMENT~~	~~DATE~~	~~GRANTOR~~	~~GRANTEE~~	~~RECORDED BRIDPORT BOOK~~	~~PAGE~~	~~DATE~~	~~REMARKS~~
~~A~~	~~QCD~~	~~9-7-38~~	~~T.D. A.P. & MARY SUNDERLAND~~	~~ST OF VT~~	~~20~~	~~210-19~~	~~9-10-38~~	~~Col. Stg 296100~~

CONSTRUCT TURNOUT (Mailbox)
199+~~30~~ ~ 200+30 Lt.
65 15

CONSTRUCT DRIVE
201+13 Lt. (20' Wide) GRAVEL
193+64 Lt. (16' Wide) GRAVEL

RELOCATE MAILBOX, SINGLE SUPPORT
~~200+05 Lt~~
199+90 Lt
201+10 Rt.

REMOVAL OF EXISTING FENCE
200+85 Rt. - 204+0 Rt.

~~Removing and Resetting Fence~~
~~194+46 Lt. ~ 199+70 Lt~~

~~Temporary Barbed Wire Fence (4 Strand)~~
~~194+40 Lt ~ 199+70 Lt~~

Rev. Curve
Δ 15-26 Lt
D 5
R ~~1146.3~~ 1145.92
T 155.3 21
L 308.7 41
E 10.5 41

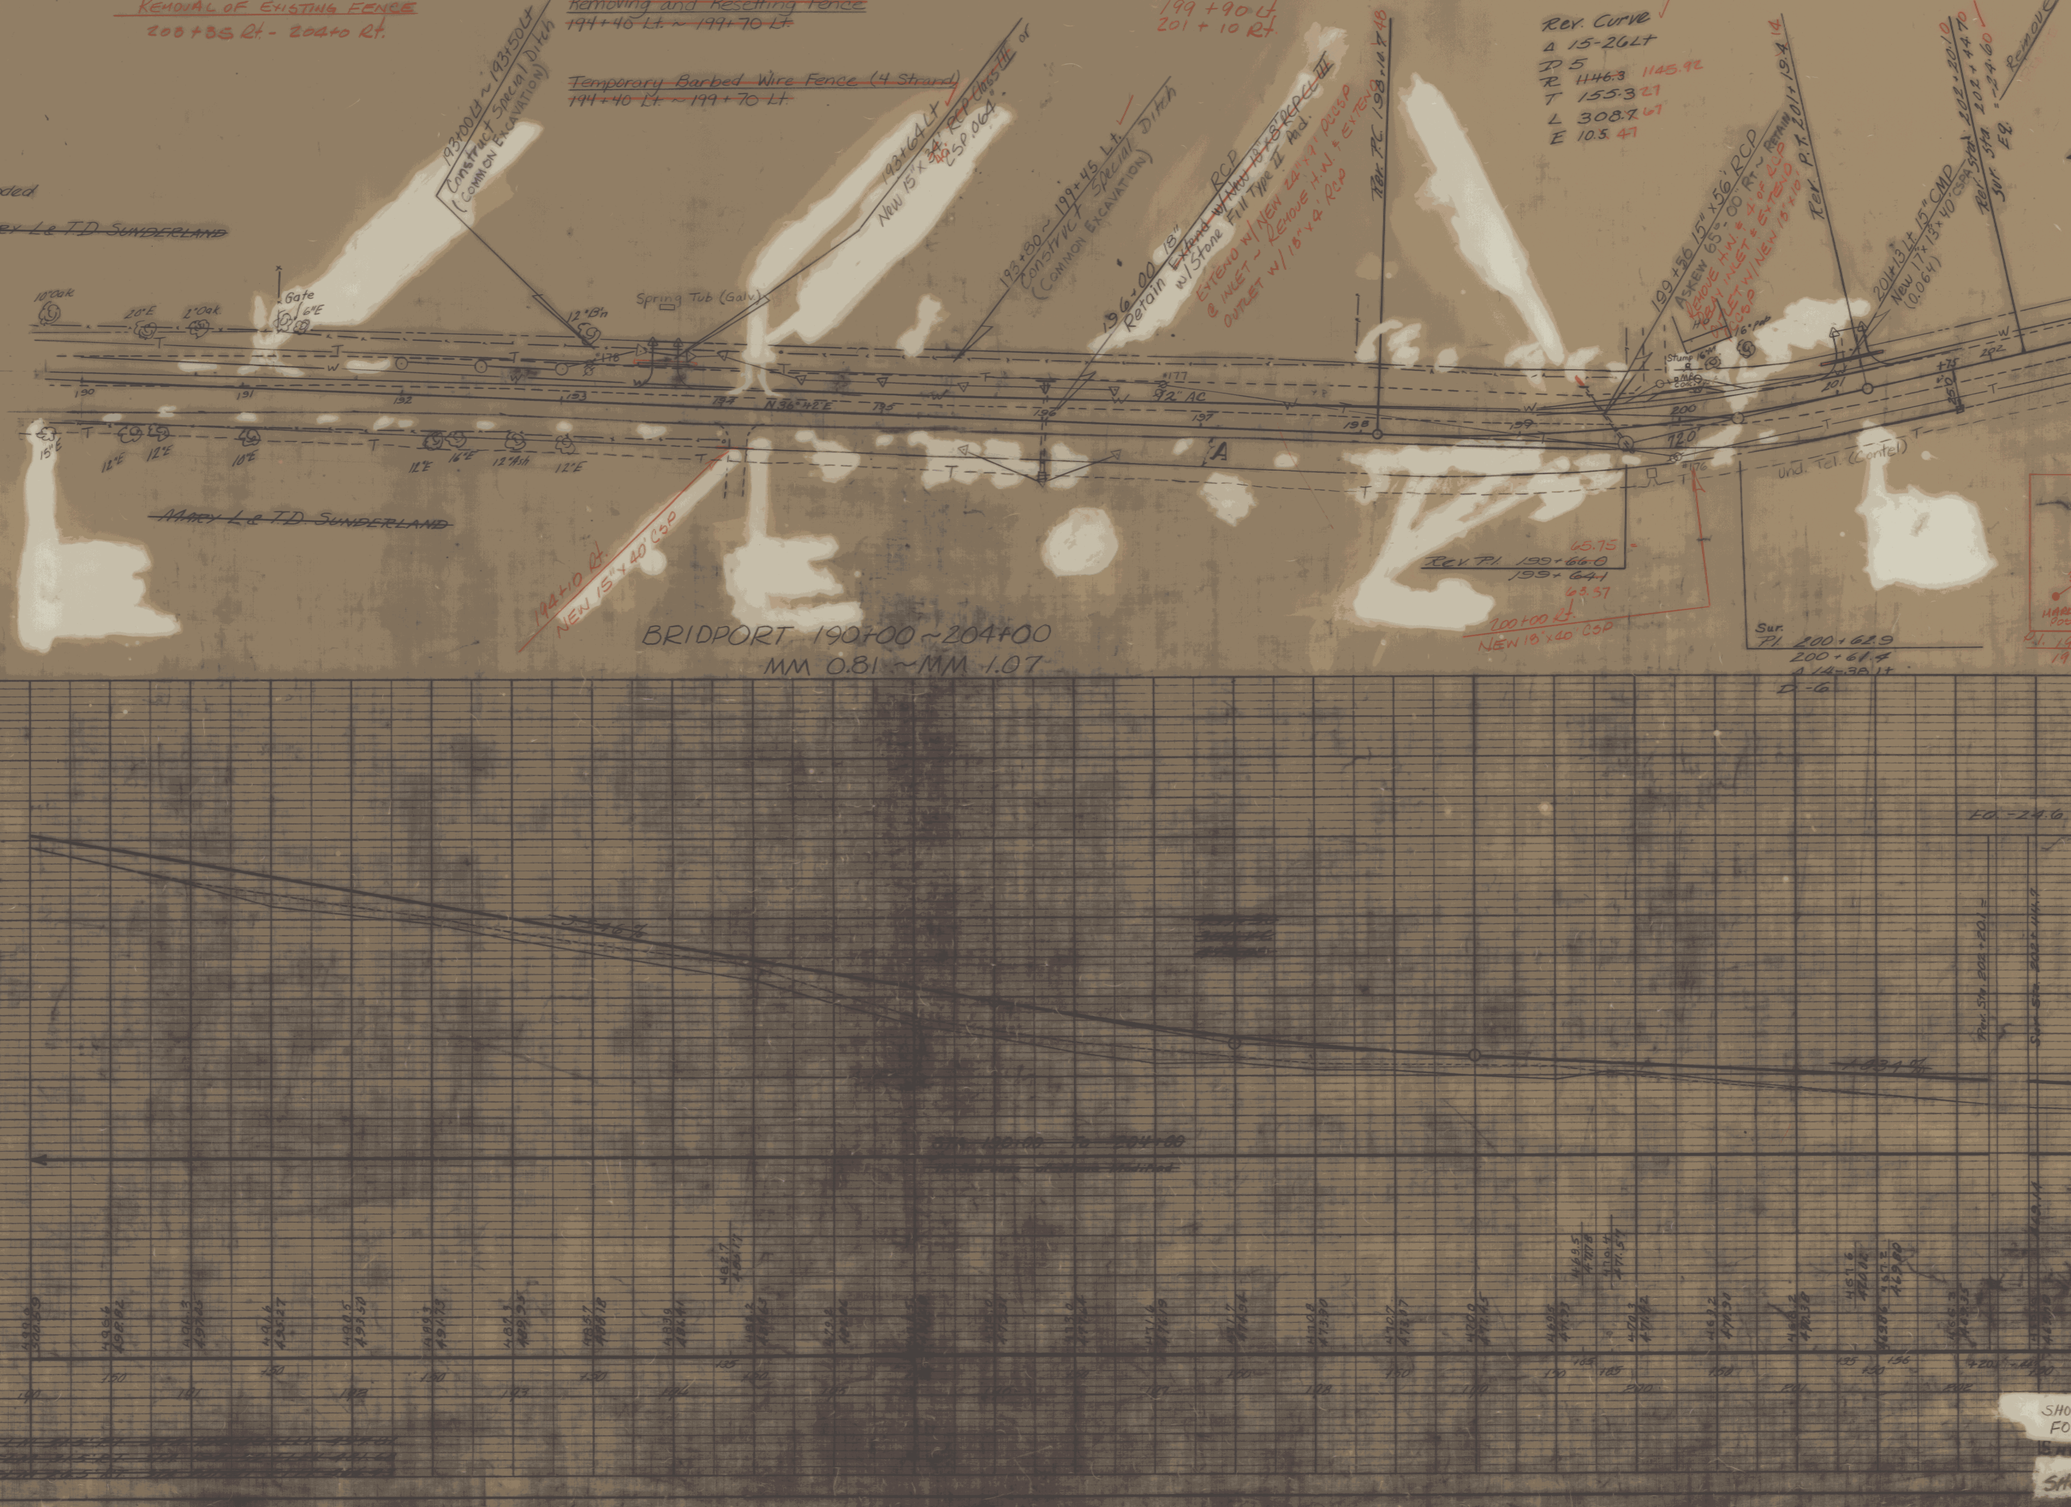

PLAN		BY
	SURVEYED	
	PLOTTED	Wood - LANE
	CALCULATIONS CHECKED	R.W. Bailey
	RT. OF WAY CHECKED	Everette Adams
NOTE BOOK		5/14/70
NO.	Traced	R.H. Bailey May-'80

STATE OF VERMONT
AGENCY OF TRANSPORTATION
DIVISION OF HIGHWAYS
ROUTE 30 BRIDPORT
STRUCTURE NO. VT-0.81 R.R. OVER