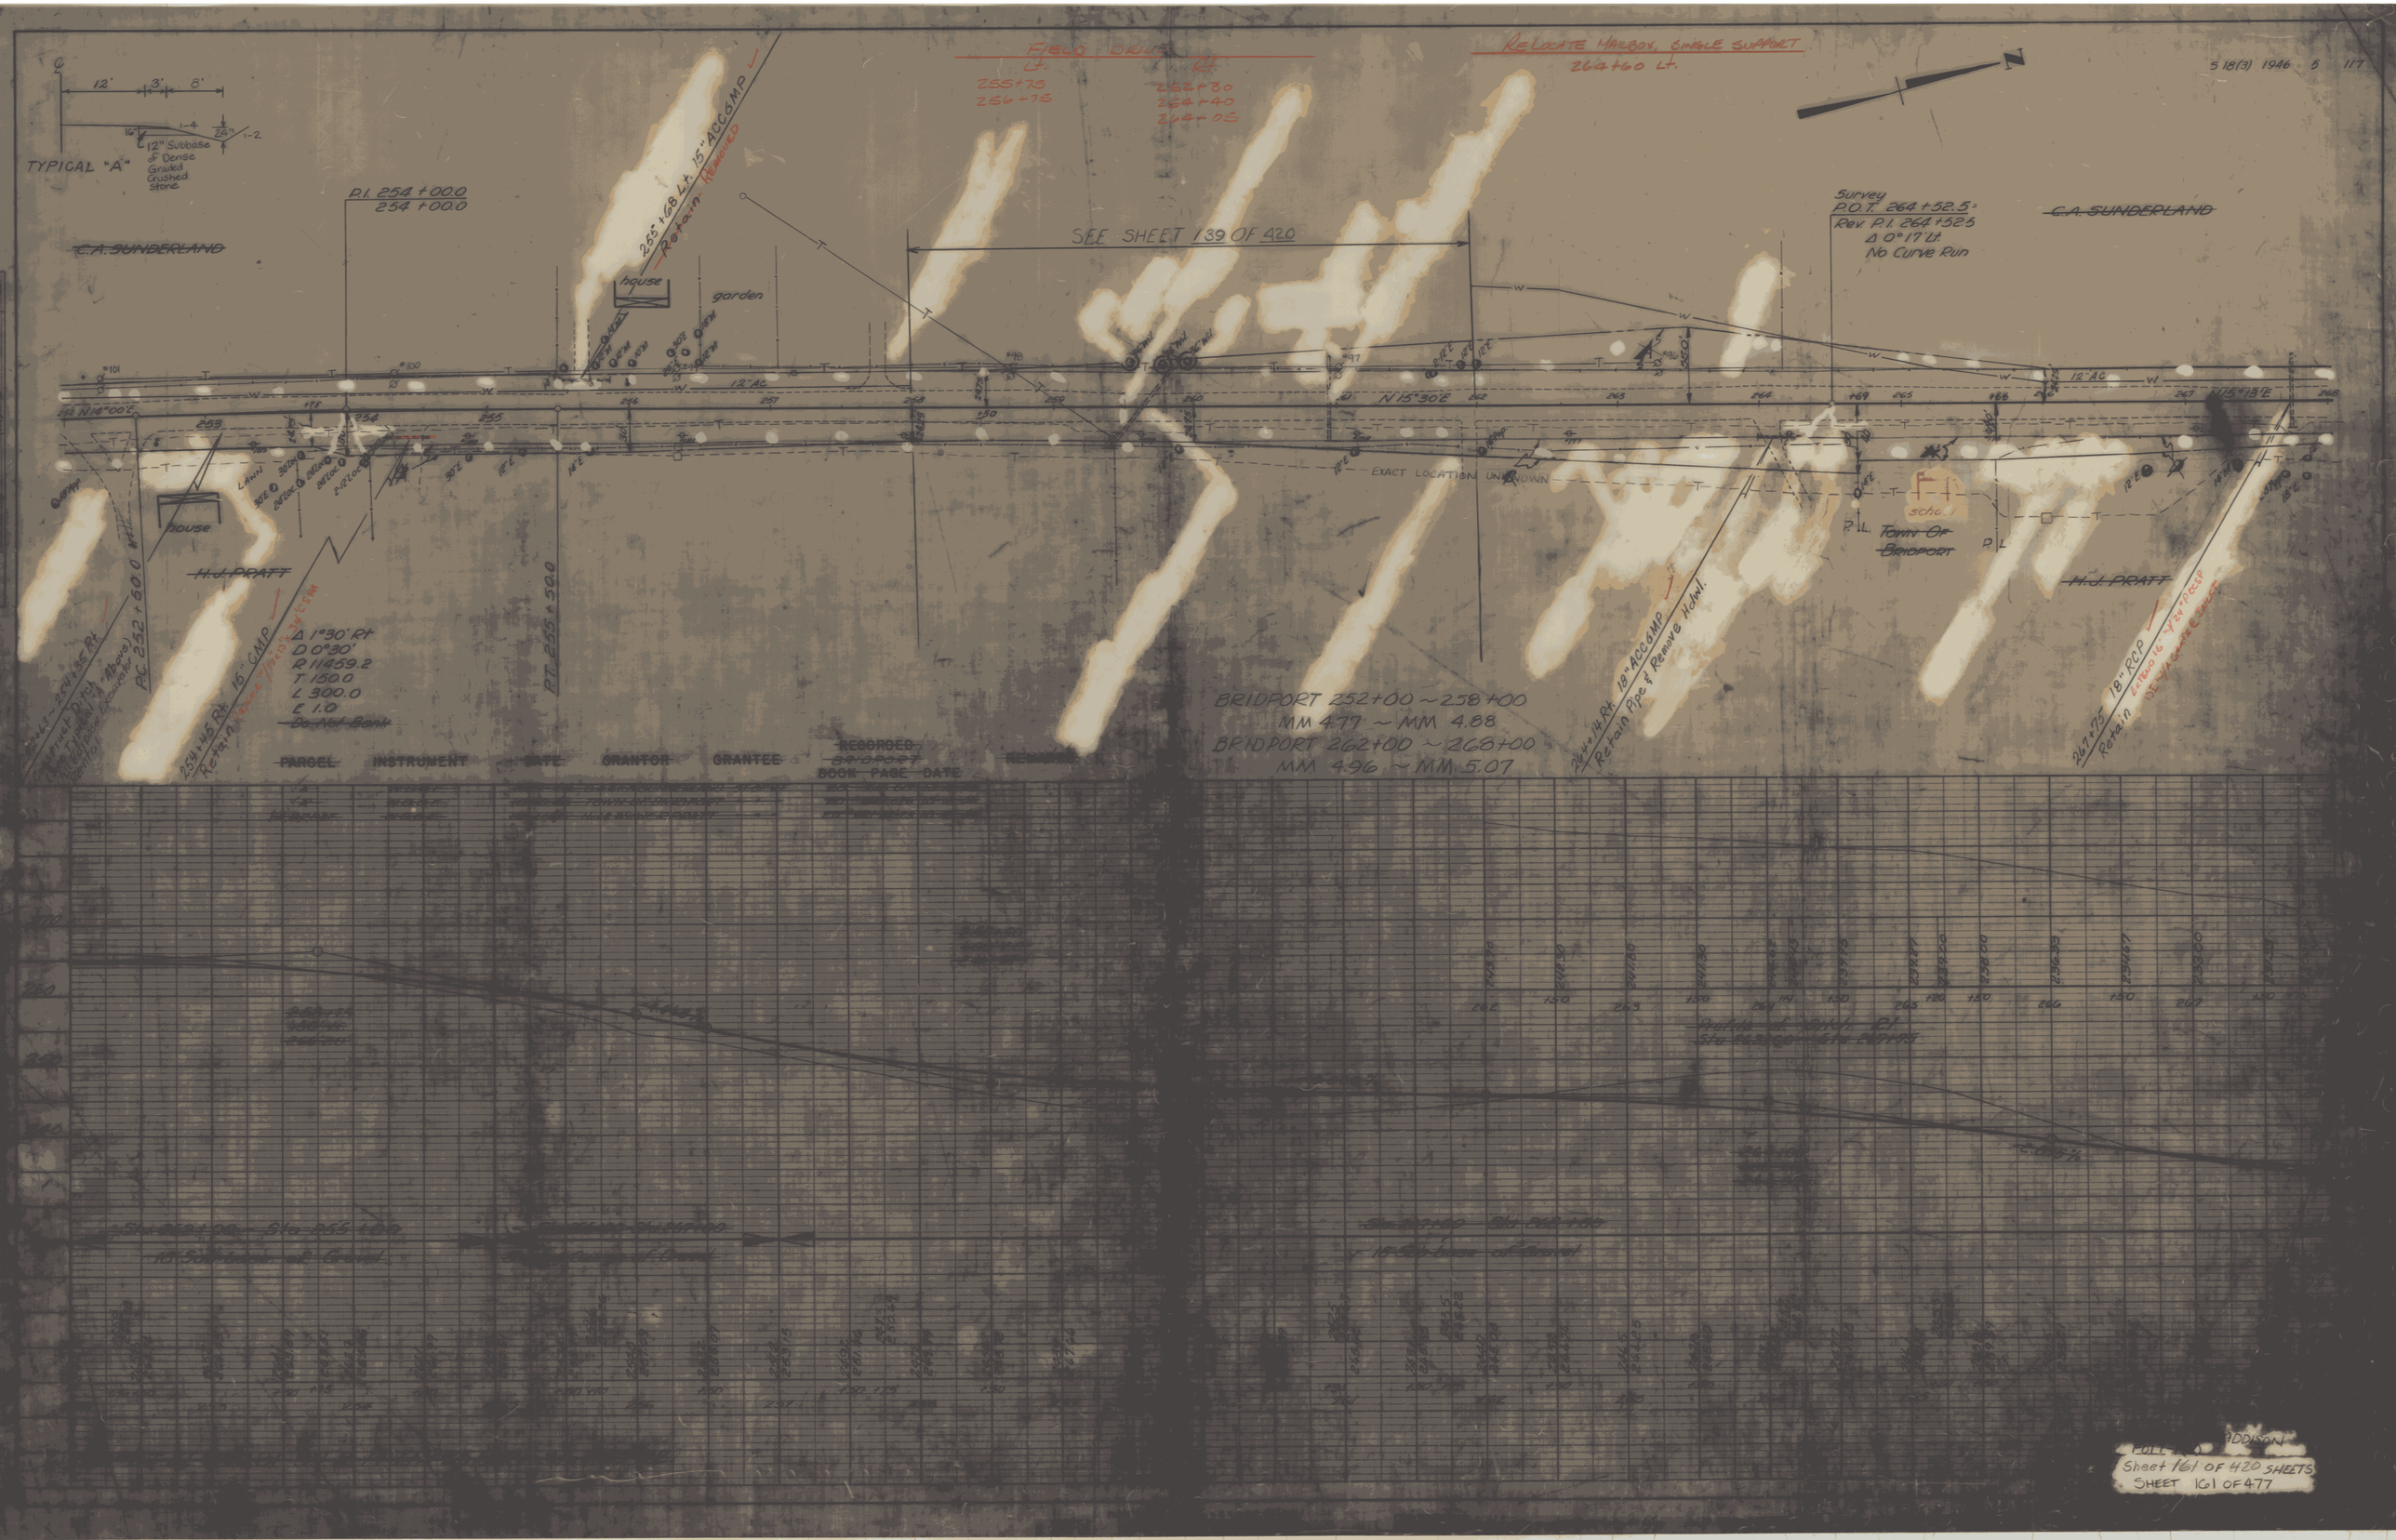
TYPICAL "A"
12' 3' 8'
12" Subbase of Dense Graded Crushed Stone
FIELD DRIVE
Lt. 255+75 256+75
Rt. 252+30 254+40 264+05
RELOCATE MAILBOX, SINGLE SUPPORT
264+60 Lt.
P.I. 254+00.0
254+00.0
255+68 Lt. 15" ACC&MP
Retain Removed
SEE SHEET 139 OF 420
house
garden
C.A. SUNDERLAND
H.J. PRATT
Survey
P.O.T. 264+52.5±
Rev. P.I. 264+52.5
Δ 0°17' Lt.
No Curve Run
N 15°30'E
EXACT LOCATION UNKNOWN
Town Of Bridport
school
P.L.
PC 252+60.0
PT 255+30.0
Δ 1°30' Rt
D 0°30'
R 11459.2
T 150.0
L 300.0
E 1.0
Do Not Bank
254+45 Rt. 15" CMP
Retain
BRIDPORT 252+00 ~ 258+00
MM 4.77 ~ MM 4.88
BRIDPORT 262+00 ~ 268+00
MM 4.96 ~ MM 5.07
264+14 Rt. 18" ACC&MP
Retain Pipe & Remove Hdwl.
264+75 18" RCP
Retain
PARCEL INSTRUMENT DATE GRANTOR GRANTEE RECORDED BOOK PAGE DATE REMARKS