STATE	PROJ. NO.	FISCAL YEAR	SHEET NO.	TOTAL SHEETS
	S18(3)	1946	13	117

BARBED WIRE FENCE - 4 STRAND
Lt. 358+50 - 361+50, 367+50 - 369+00
Rt. 372+50 - 374+00, 371+60 - 374+00

WOVEN WIRE FENCE w/ WOOD POSTS (HOG)
367+75 - 374+25 Rt.

FIELD DRIVE
Lt. 368+50
Rt. 365+80

RELOCATE MAILBOX, SINGLE SUPPORT
Lt. 363+68
Rt.

REMOVAL & DISPOSAL OF GUARD RAIL
373+76 - 374+00

N

SEE SHEET 172 OF 420

SEE SHEET 173 OF 420 SHEETS

Δ = 3°-50' Lt
D = 0°-30'
R = 11459.2
T = 383.4
L = 766.6
E = 6.4

P.C. 363+83.8

house

~~KENNETH SOUTHARD~~

~~MERTON TORREY~~

12" AC

N44°58'E

N41°08'E

P.T. 371+50.4

P.T. 359+17.5

~~KENNETH SOUTHARD~~

~~MERTON TORREY~~

pasture

P.I. 367+67.2 = 367+67.0

REMOVAL OF EXISTING FENCE (NON-PART)
Lt. 372+50 - 374+50, 367+50 - 369+00
Rt. 372+00, 374+50

ADDISON 363+00 ~ 371+00
MM 0.56 ~ MM 0.71

~~PARCEL~~	~~INSTRUMENT~~	~~DATE~~	~~GRANTOR~~	~~GRANTEE~~	~~RECORDED BOOK~~	~~PAGE~~	~~DATE~~	~~REMARKS~~
~~A&B~~	~~W.D.O.E.~~	~~10-1-46~~	~~KENNETH SOUTHARD~~	~~ST. OF VT.~~	~~29~~	~~243-244~~	~~10-19-46~~	
~~A&B~~	~~W.D.O.E.~~	~~11-21-46~~	~~MERTON & SHIRLEY B. TORREY~~	~~" " "~~	~~29~~	~~274-276~~	~~12-6-46~~	

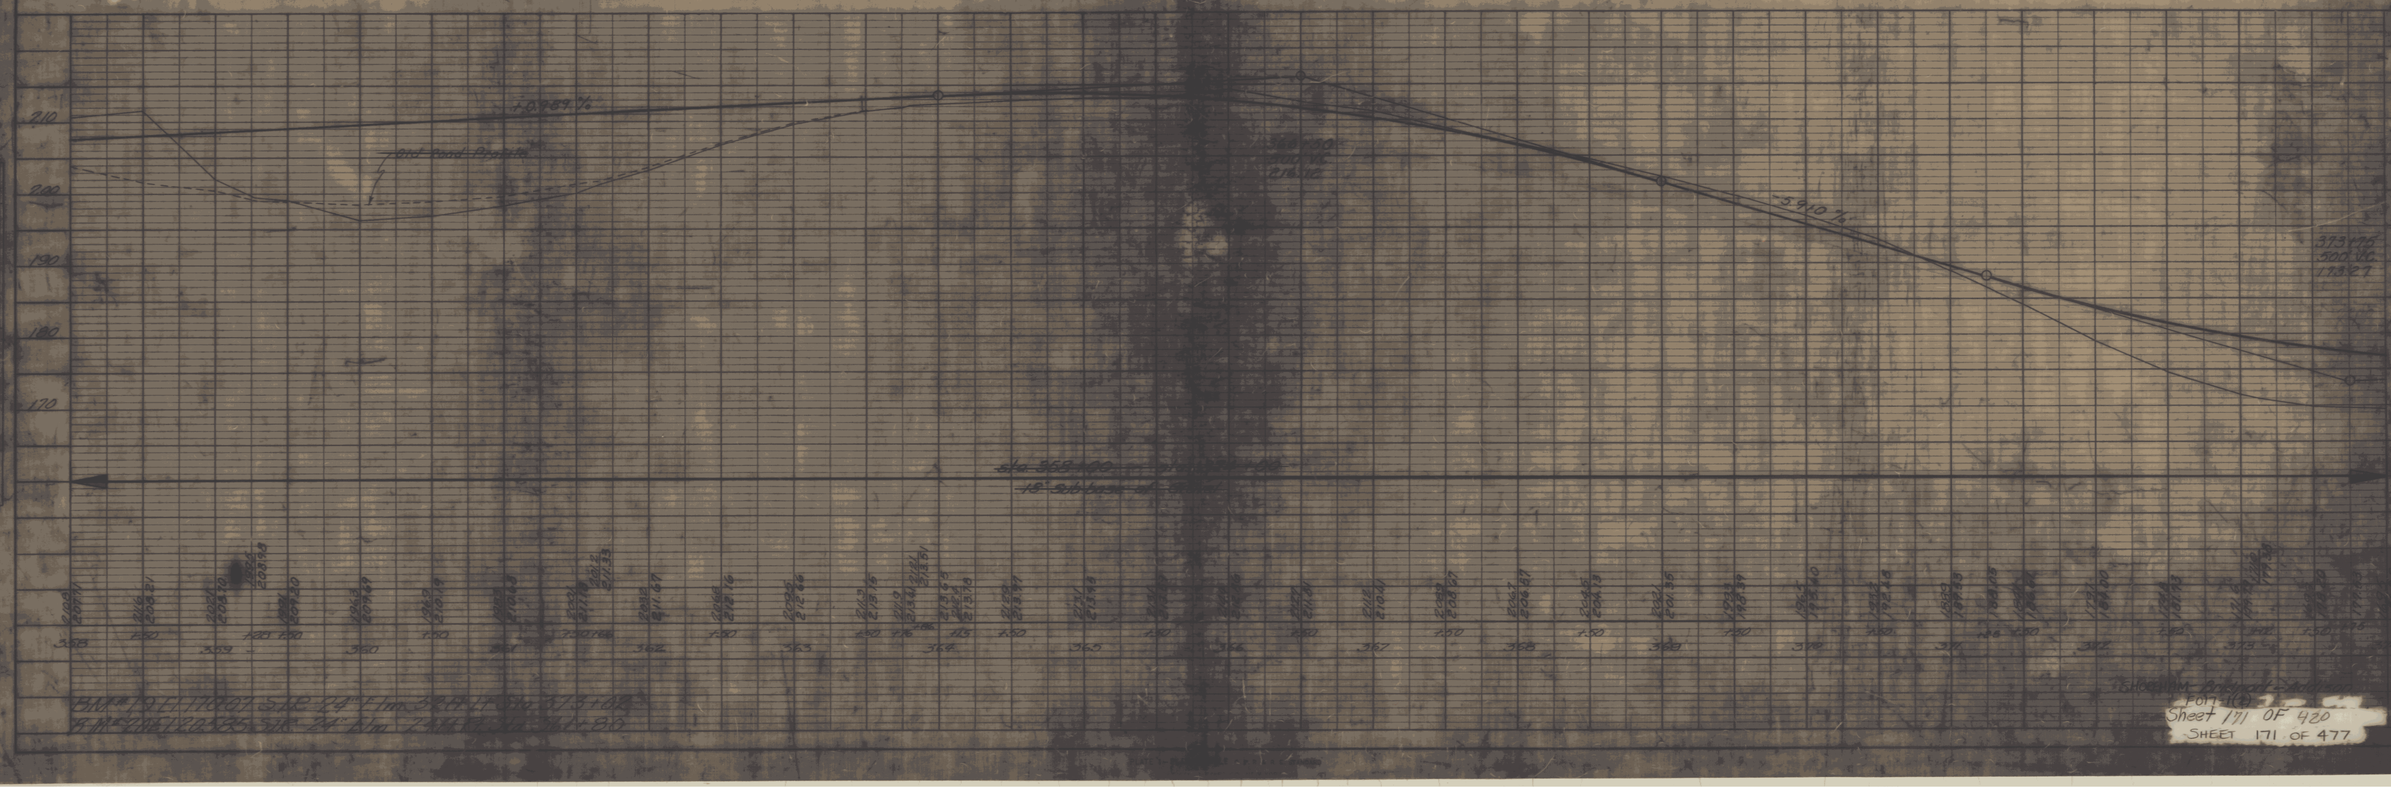

Sheet 171 OF 420
SHEET 171 OF 477