STATE	FED. AID PROJ. NO.	PROJ. NO.	FISCAL YEAR	SHEET NO.	TOTAL SHEETS
VT.		518(3)	1946	14	117

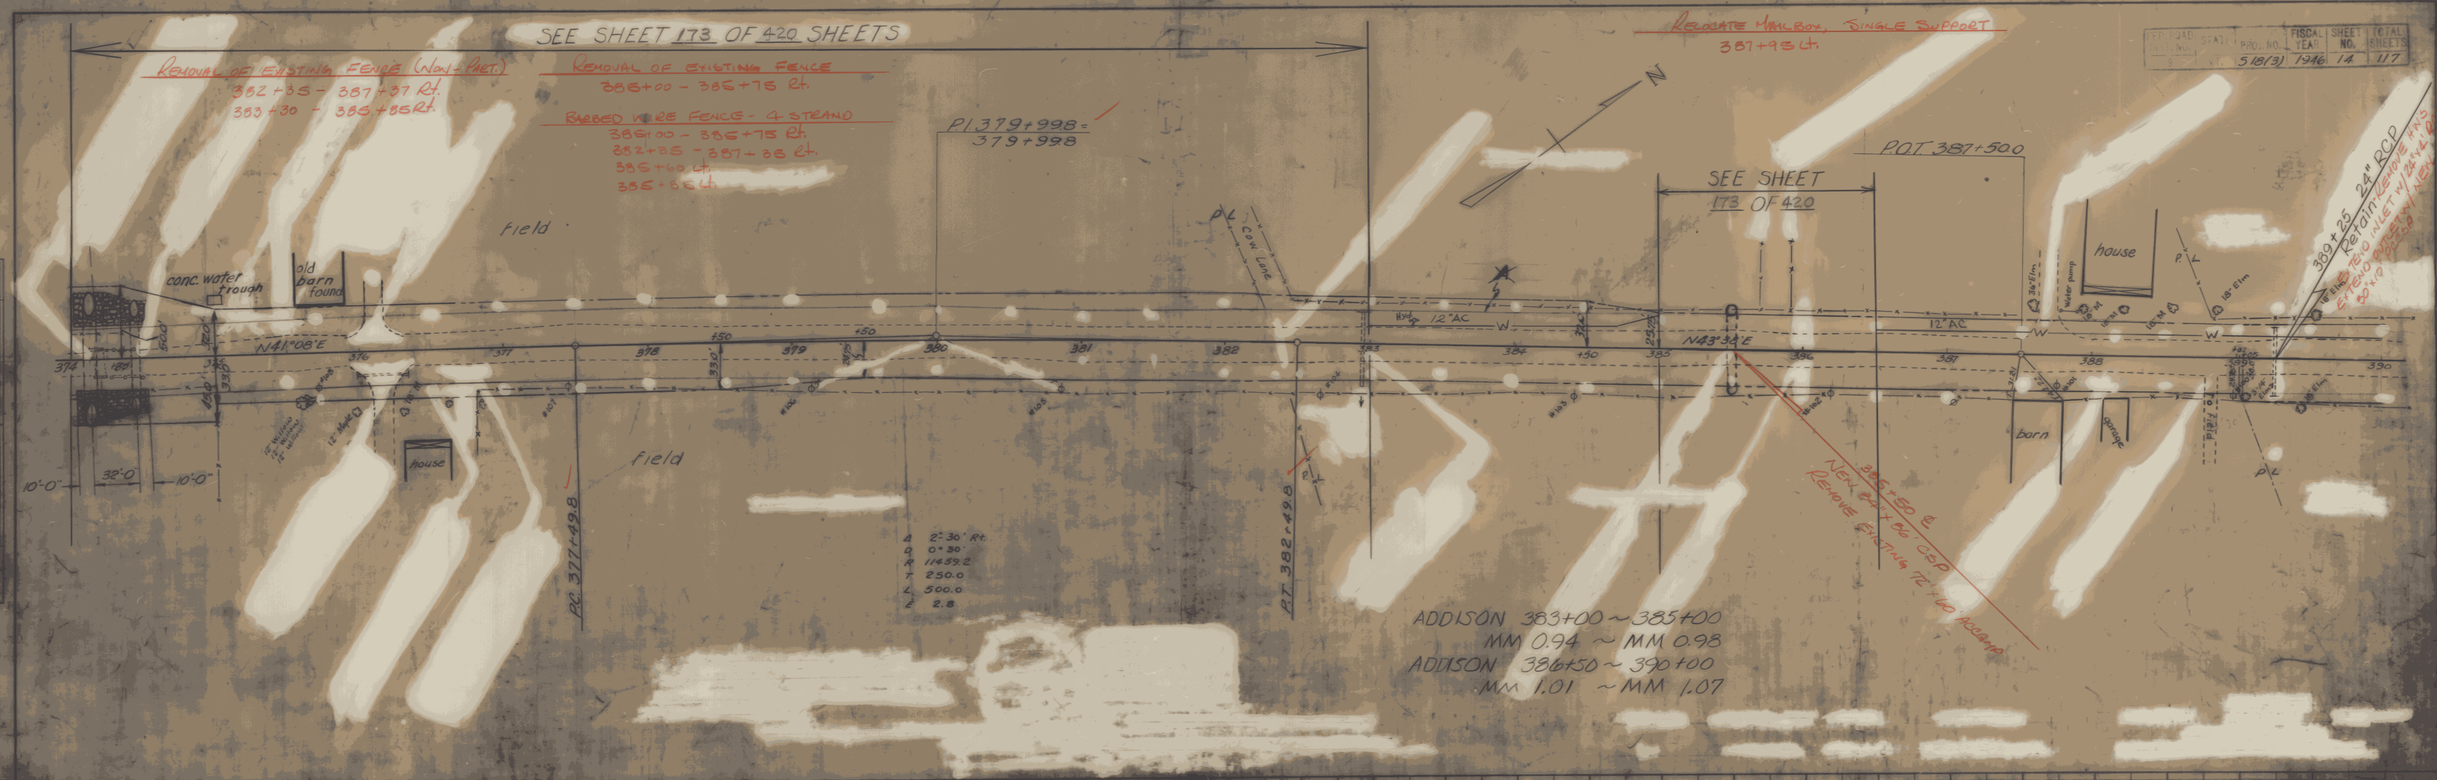

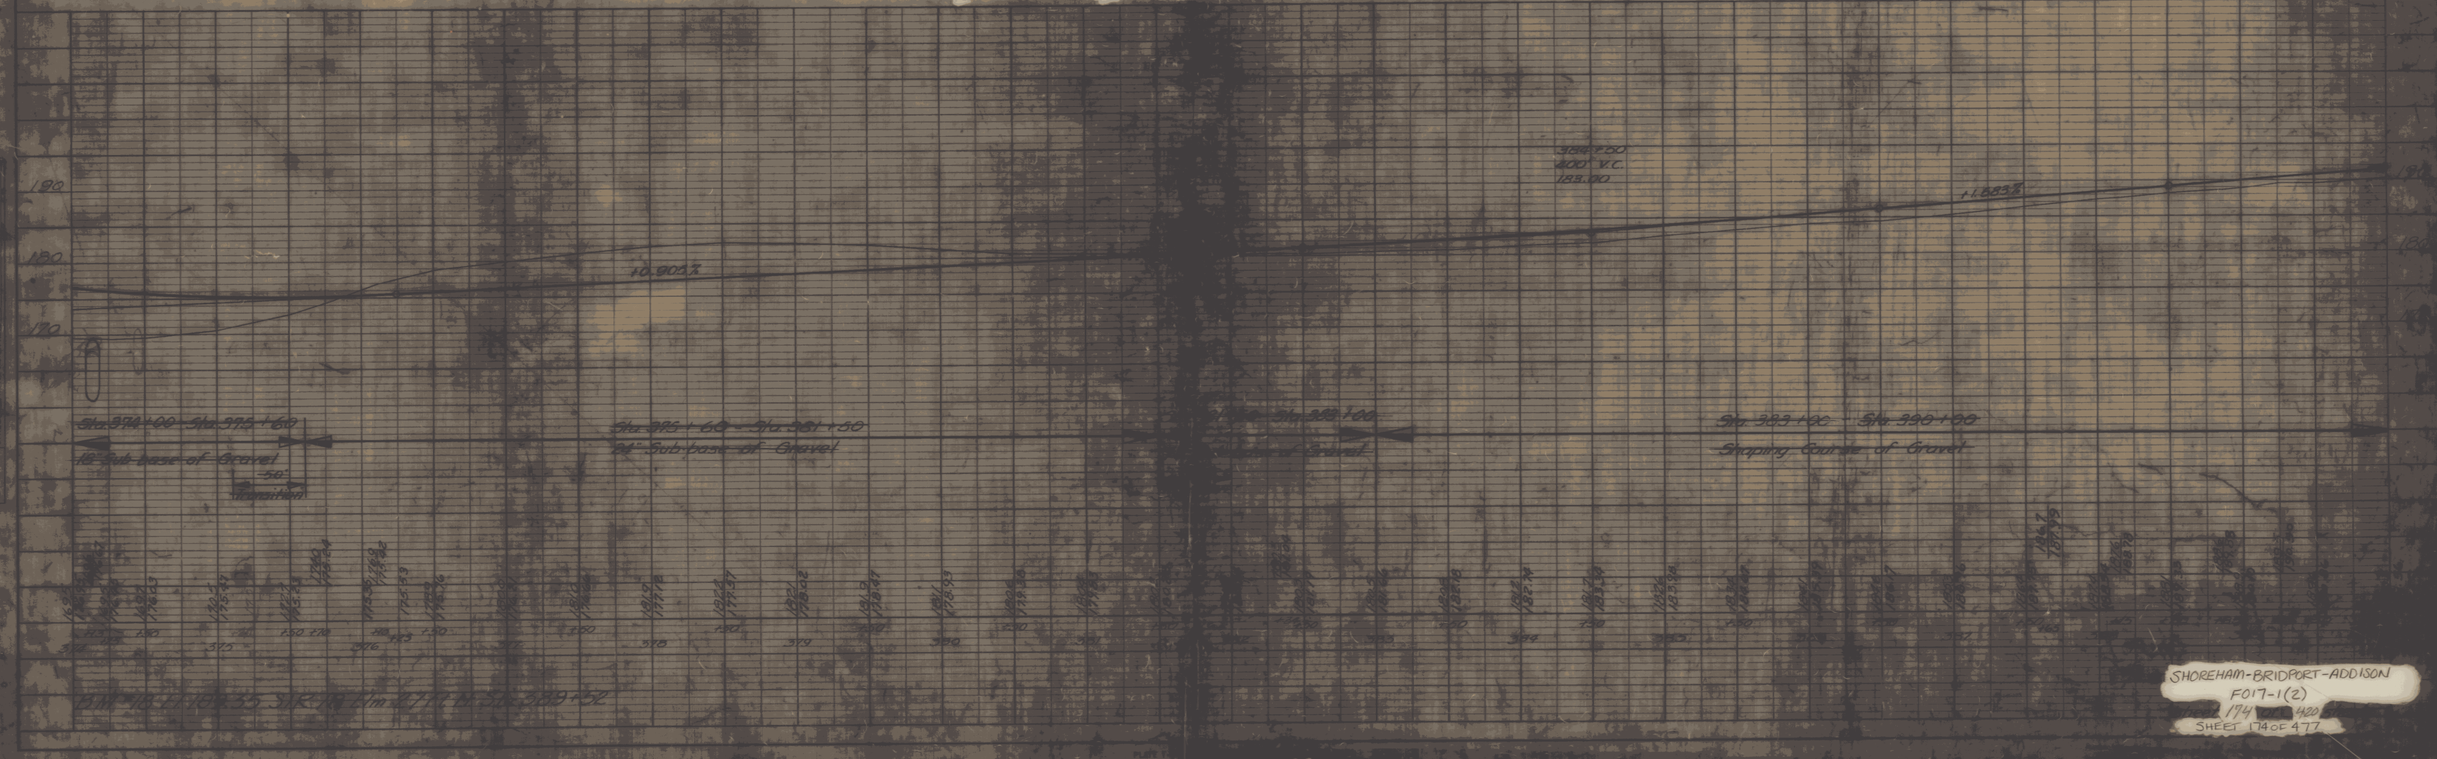

SHOREHAM-BRIDPORT-ADDISON
F017-1(2)
174 420
SHEET 174 OF 477