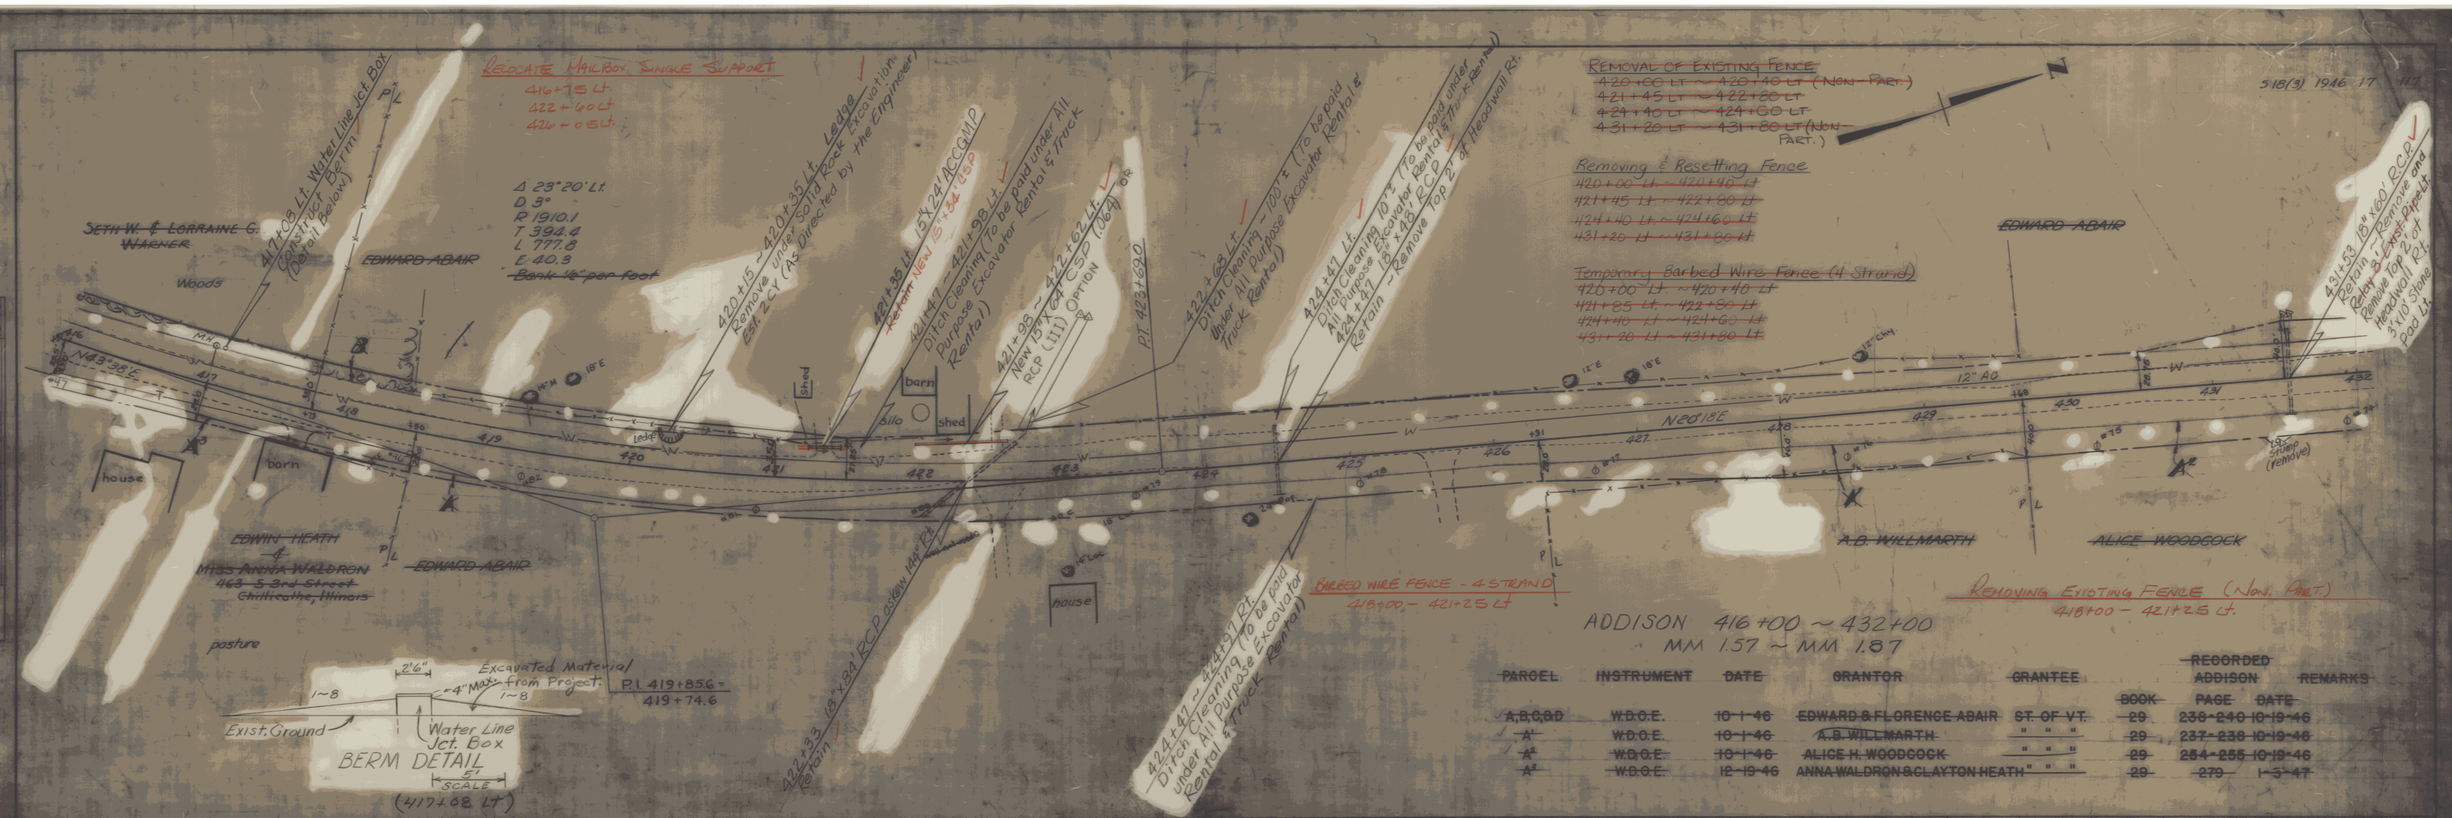

~~PARCEL~~	~~INSTRUMENT~~	~~DATE~~	~~GRANTOR~~	~~GRANTEE~~	~~BOOK~~	~~RECORDED ADDISON PAGE~~	~~DATE~~	~~REMARKS~~
~~A, B, C, & D~~	~~W.D.O.E.~~	~~10-1-46~~	~~EDWARD & FLORENCE ABAIR~~	~~ST. OF V.T.~~	~~29~~	~~238-240~~	~~10-19-46~~	
~~A¹~~	~~W.D.O.E.~~	~~10-1-46~~	~~A.B. WILLMARTH~~	~~" " "~~	~~29~~	~~237-238~~	~~10-19-46~~	
~~A²~~	~~W.D.O.E.~~	~~10-1-46~~	~~ALICE H. WOODCOCK~~	~~" " "~~	~~29~~	~~254-255~~	~~10-19-46~~	
~~A³~~	~~W.D.O.E.~~	~~12-19-46~~	~~ANNA WALDRON & CLAYTON HEATH~~	~~" " "~~	~~29~~	~~279~~	~~1-3-47~~	

SHOREHAM-BRIDPORT-ADDISON
F017-1(2)
SHEET 177 OF 477