5

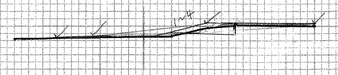

33+50

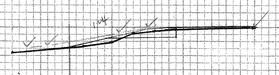

36+00

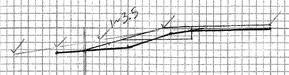

38+50

33+00

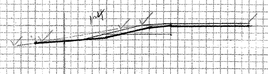

35+50

38+00

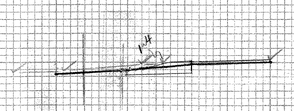

32+50

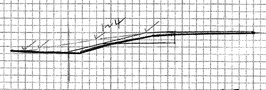

35+00

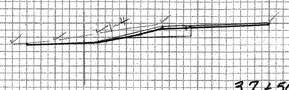

37+50

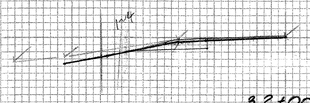

32+00

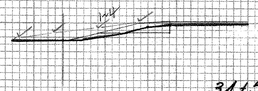

34+50

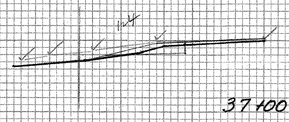

37+00

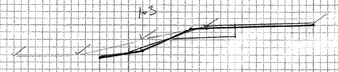

31+50

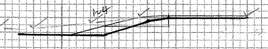

34+00

36+50

SHOREHAM - BRIDPORT - ADDISON

F017-1 (2)

Original Sections

31+50 ~ 38+50 LT

FINAL SURVEY	SURVEYED	BY	DATE
	PLOTTED		
	TRACED		
NOTE BOOK	CHECKED		
No.	AREAS CHECKED		

ORIGINAL SURVEY	SURVEYED	BY	DATE
	PLOTTED		
	TRACED	KAUFMAN	1/11/88
NOTE BOOK	CHECKED		
No.	AREAS CHECKED		

PLATE 3 CROSS SECTION O. P. R. & R. E. STANDARD
DIETZGEN CORPORATION

SHEET 25B-A-L OF 477