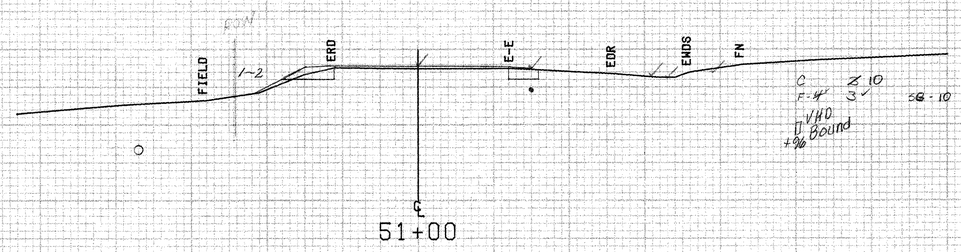

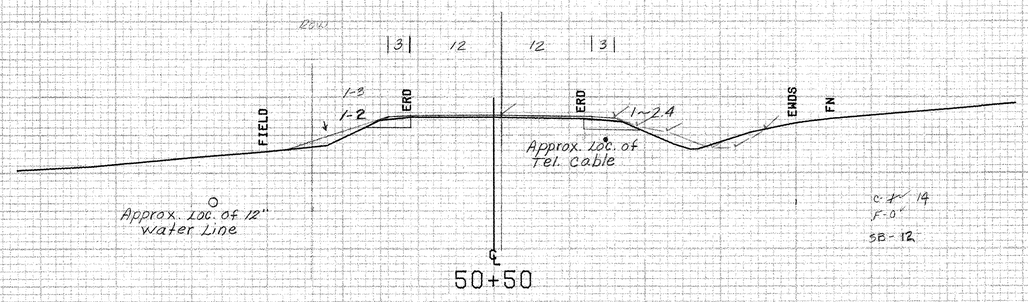

SHOREHAM MM 439 ~ MM 452

FROM STA. 50+50		TO STA. 51+00	
PROJECT NAME	SHOREHAM-ADDISON	MAIN3	
NO.	F017-1(2)	PLOTTED 01/09/85	
SURVEYED BY	FANTONI	DEC 1984	
SHEET 267 OF 420 SHEETS		SHEET 267 OF 477	

SCALE 10 FEET