Kenyon & Esser Company — LATE 3 CROSS SECTIONS 1988 U.S.A.

(21)

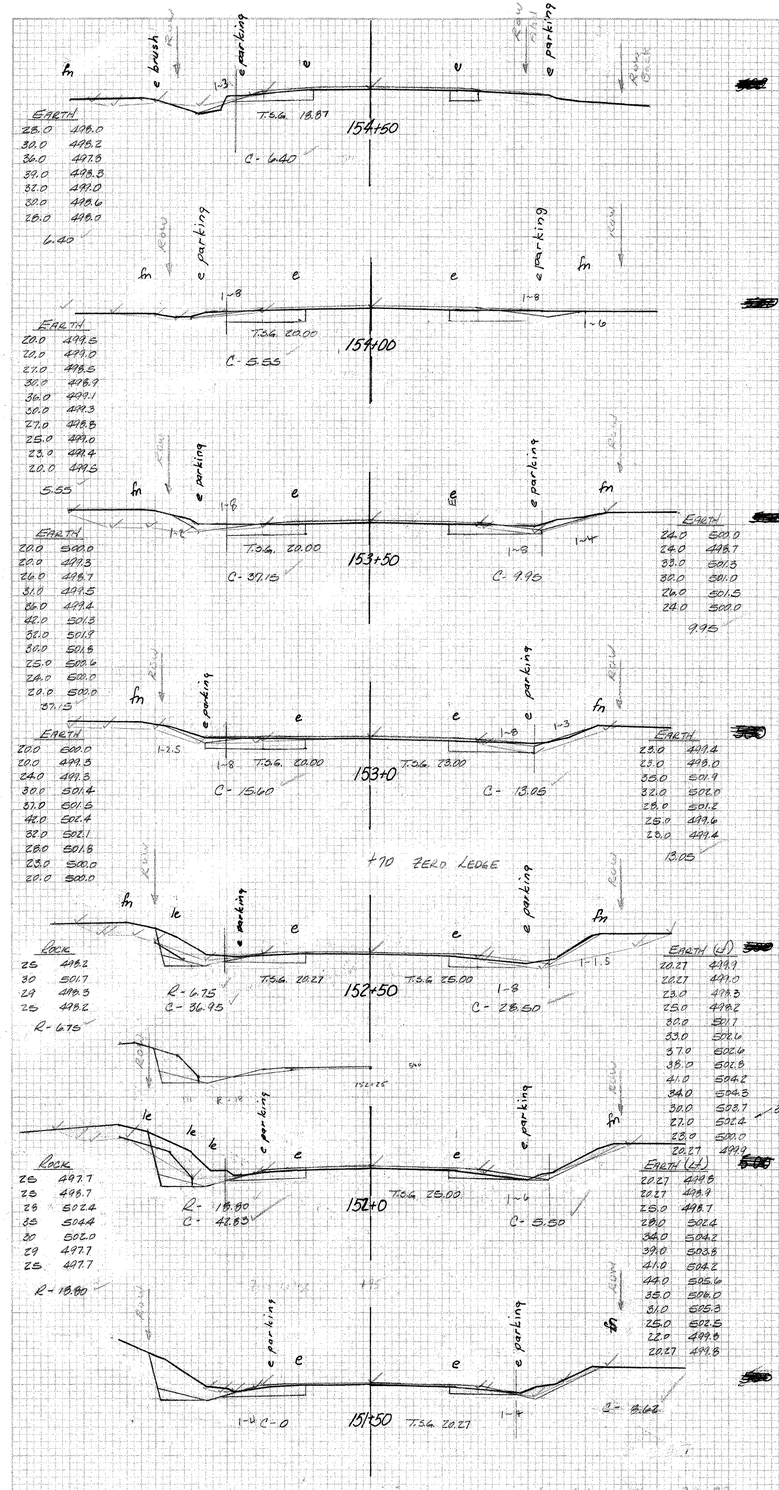

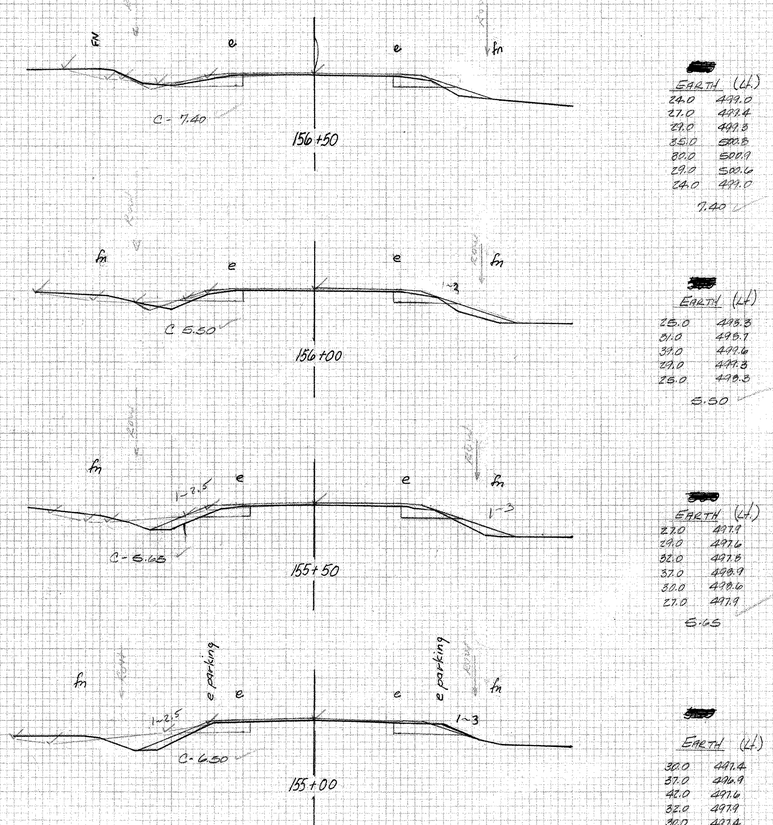

Cats ✓ by WJG 4-20-92

Cats ✓ by WJG 4-20-92

11-90 DAY

SHOREHAM - BRIDPORT-ADDISON F-017-1(2)

ORIGINAL SECTIONS 11-90

151+50 - 156+50 SH 205-A OF 477