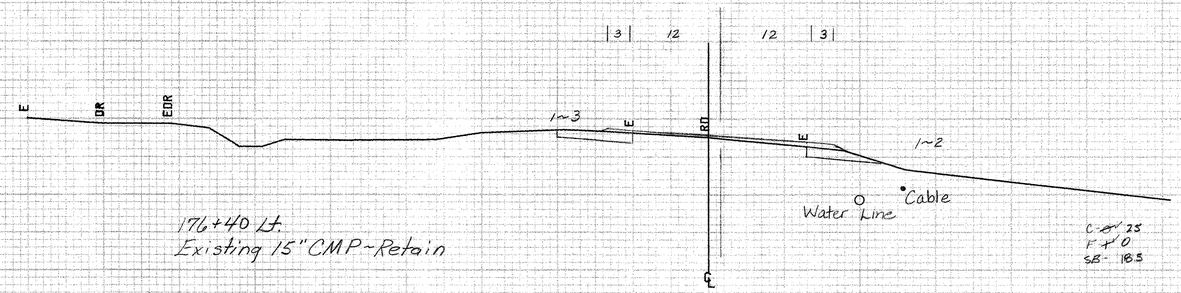

176+40 Lt.
Existing 15" CMP~Retain

℄
176+50
SEE SHEET 292-A

500

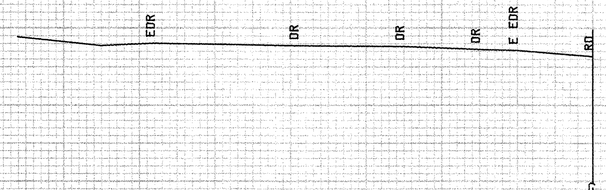

℄
176+32

500

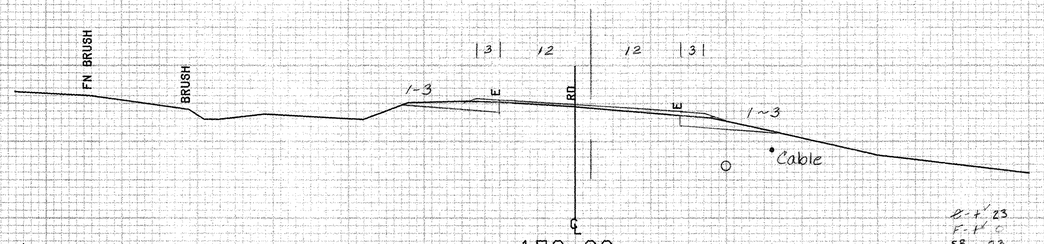

175+57 Lt.
End Removal and Disposal
of Guide Posts

℄
176+00
SEE SHEET 292-A

500

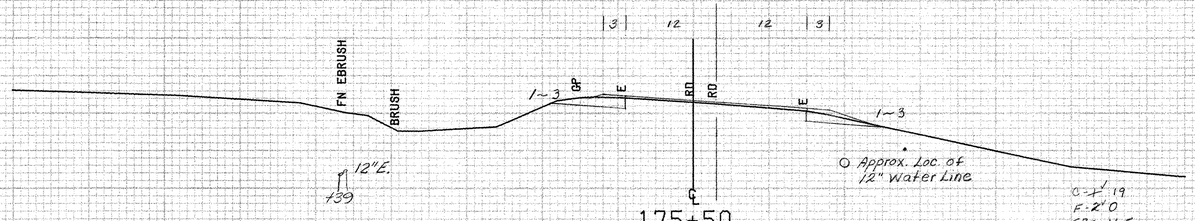

℄
175+50
SEE SHEET 292-A

500

BRIDPORT MM. 0.79 ~ MM. 0.56

ROM STA.	175+50	TO STA.	176+50
PROJECT NAME	SHOREHAM-ADDISO		MAINS
NO.	F017-1(2)		PLOTTED 01/09/85
SURVEYED BY	ANTOI		DEC 1984
SHEET 291 OF 420 SHEETS			SHEET 291 OF 477

SCALE 10 FEET