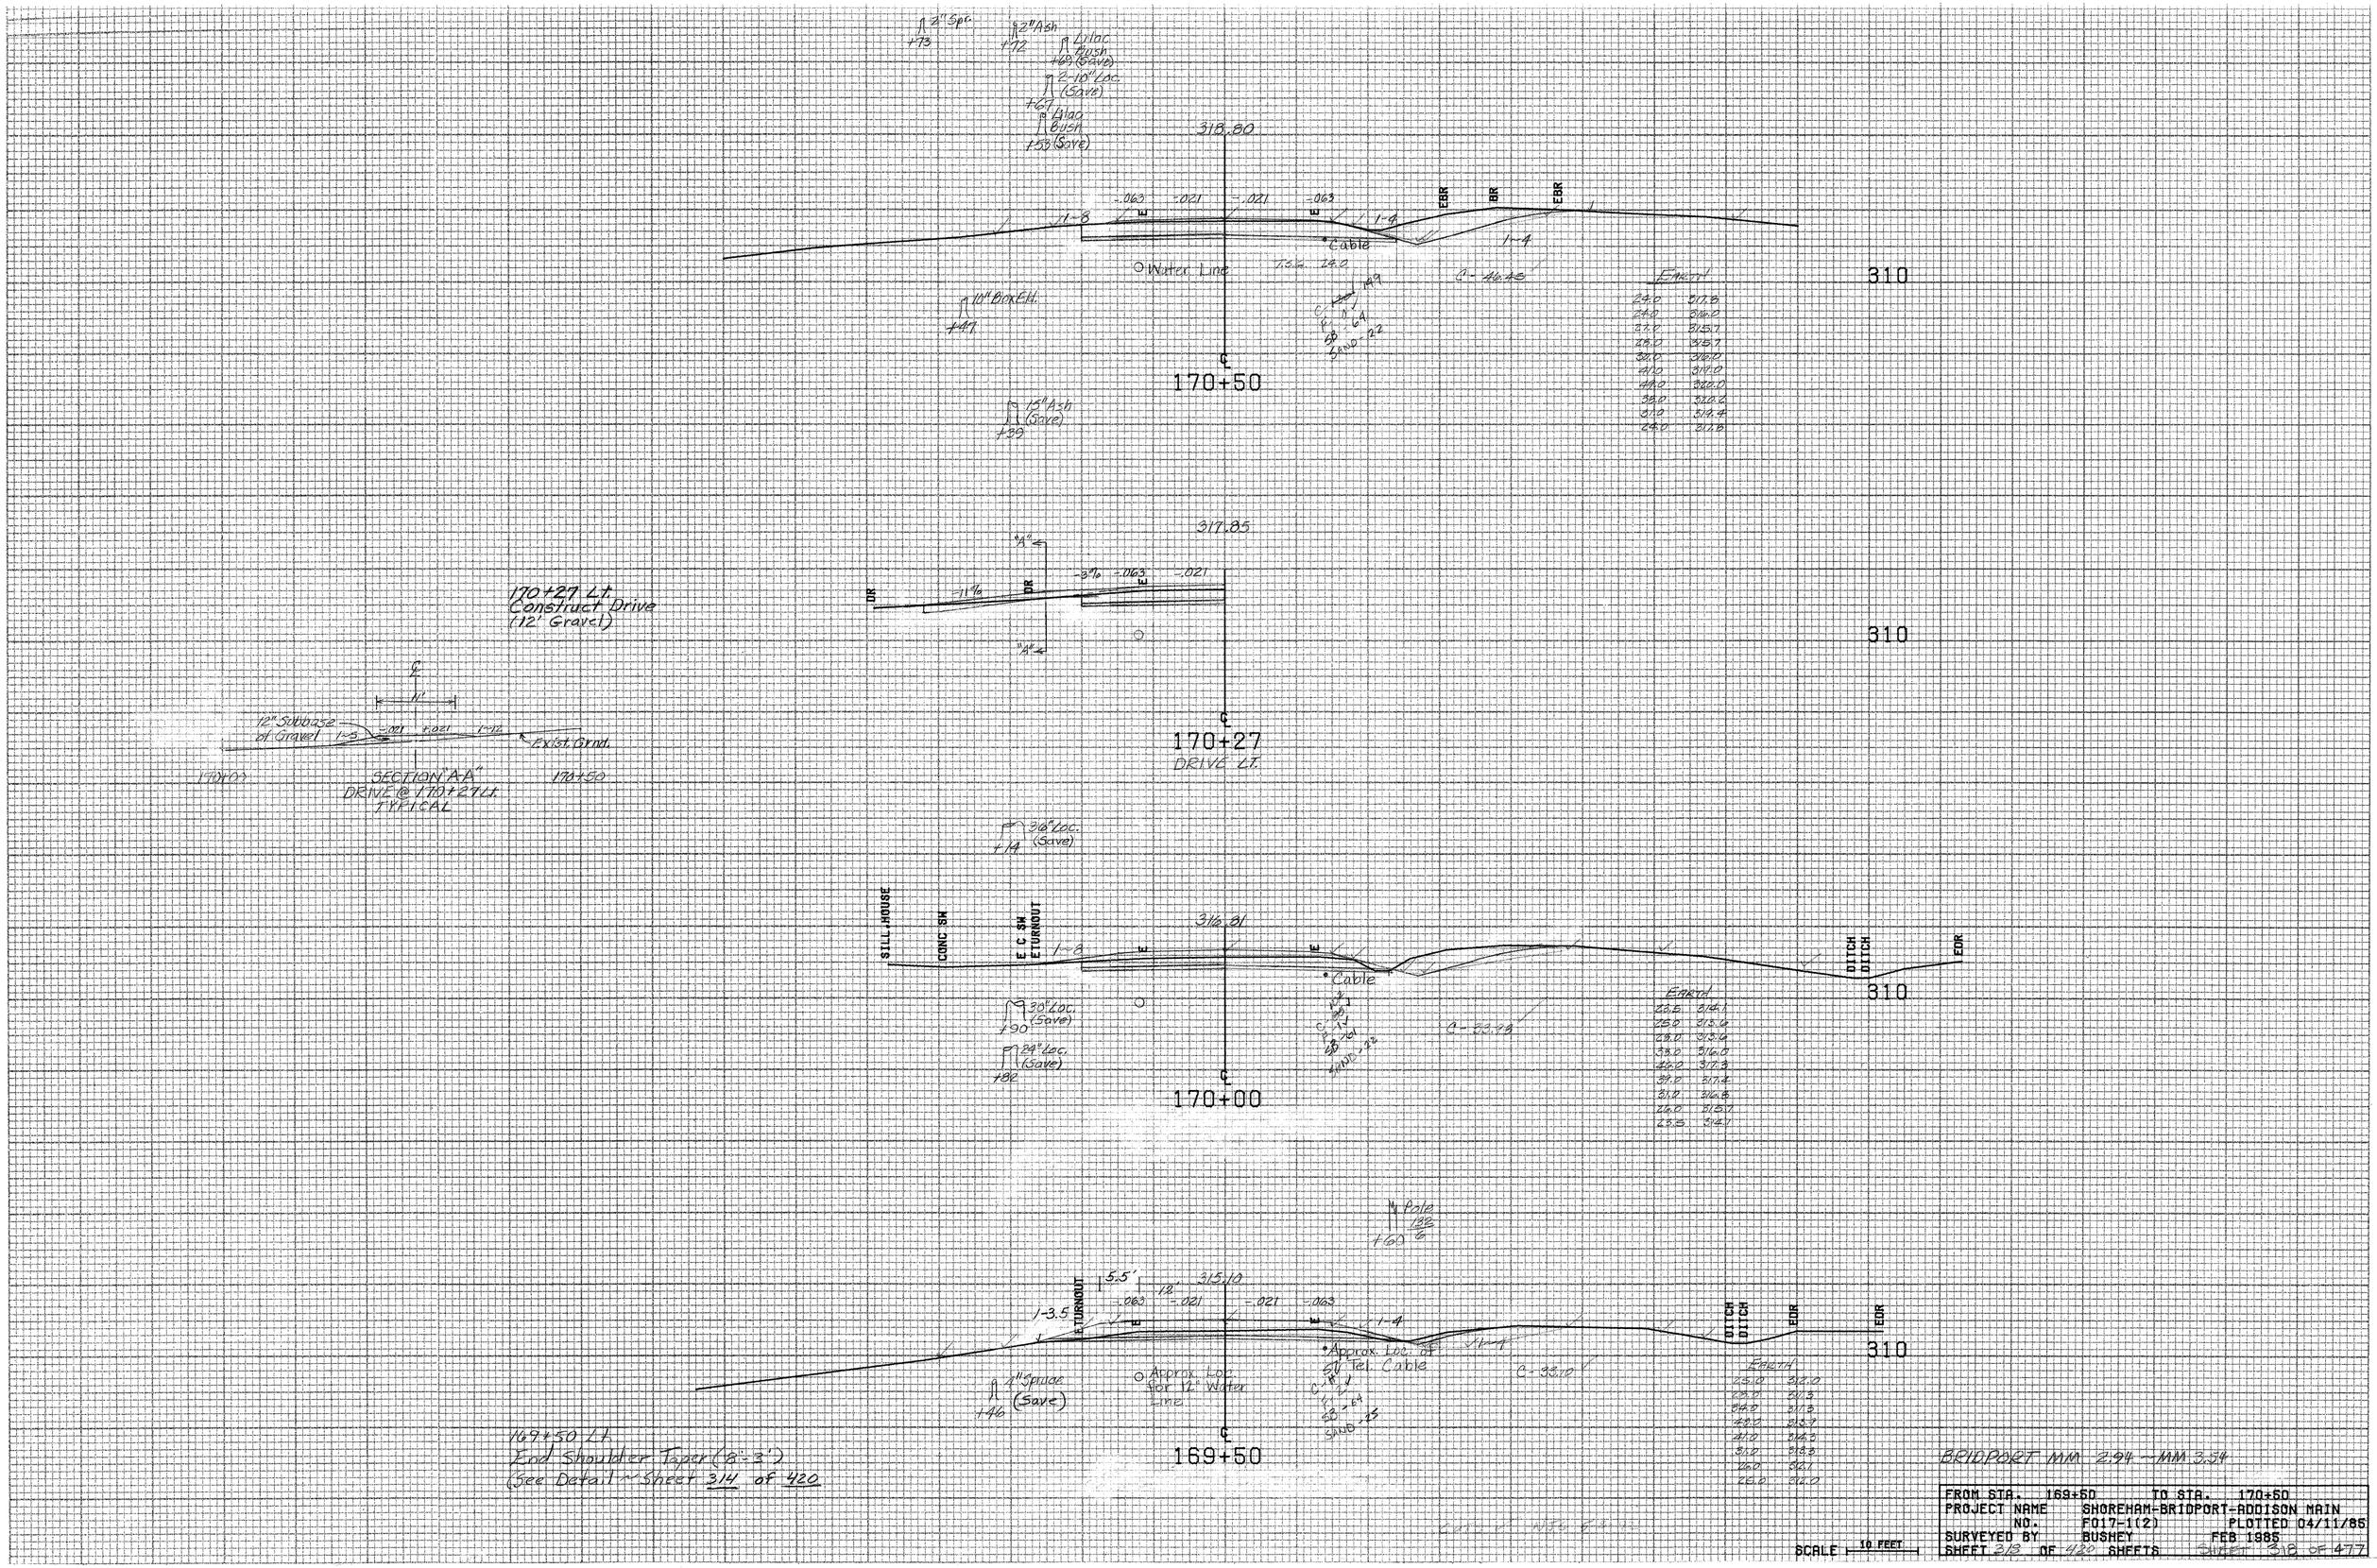
2" Spc. +73
12" Ash +72
Lilac Bush +69 (Save)
2-10" Loc. (Save) +67
Lilac Bush +53 (Save)
318.80
-.063 -.021 -.021 -.063
EBR
BR
EBR
1-8
1-4
1-4
Cable
Water Line
0-46.45
Earth
24.0 317.8
24.0 316.0
27.0 315.7
28.0 315.7
30.0 316.0
40.0 317.0
48.0 320.0
38.0 312.2
31.0 312.4
24.0 311.8
310
10" Box Ell. +47
15" Ash (Save) +39
170+50
317.85
"A"
-3.16 -.063 -.021
DR
-1.16
BR
"A"
170+27 Lt.
Construct Drive
(12" Gravel)
310
12" Subbase of Gravel
1-3
-.021 +.021 1-12
Exist Grnd.
170+00
SECTION "A-A"
DRIVE @ 170+27 Lt.
TYPICAL
170+50
170+27
DRIVE LT.
36" Loc. (Save) +14
STILL HOUSE
CONC. SW
E.C. SW
E TURNOUT
316.81
1-8
Cable
0-52.78
Earth
23.5 316.1
25.0 315.4
28.0 315.4
33.0 316.0
26.0 317.3
29.0 317.2
31.0 316.8
26.0 315.7
25.5 314.1
DITCH
DITCH
EDR
310
30" Loc. (Save) +90
24" Loc. (Save) +82
170+00
Pole 188 +60
5.5'
12'
315.10
-.063 -.021 -.021 -.063
E TURNOUT
1-3.5
1-4
1-4
Approx. Loc. of 5" Tel. Cable
0-33.10
Earth
25.0 312.0
25.0 311.3
24.0 311.3
23.0 312.7
21.0 314.3
31.0 318.3
26.0 321.1
26.0 322.0
DITCH
DITCH
EDR
EDR
310
4" Spruce (Save) +46
Approx. Loc. for 12" Water Line
169+50
169+50 Lt.
End Shoulder Taper (8'-3")
(See Detail ~ Sheet 314 of 420
BRIDPORT MM 2.94 → MM 3.54
SCALE 10 FEET
FROM STA. 169+50 TO STA. 170+50
PROJECT NAME SHOREHAM-BRIDPORT-ADDISON MAIN
NO. F017-1(2) PLOTTED 04/11/85
SURVEYED BY BUSHEY FEB 1985
SHEET 313 OF 420 SHEETS
Sheet 318 of 477