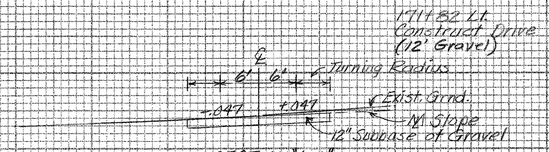

SECTION "A-A"
DRIVE @ 171+82 Lt.
TYPICAL
NTS

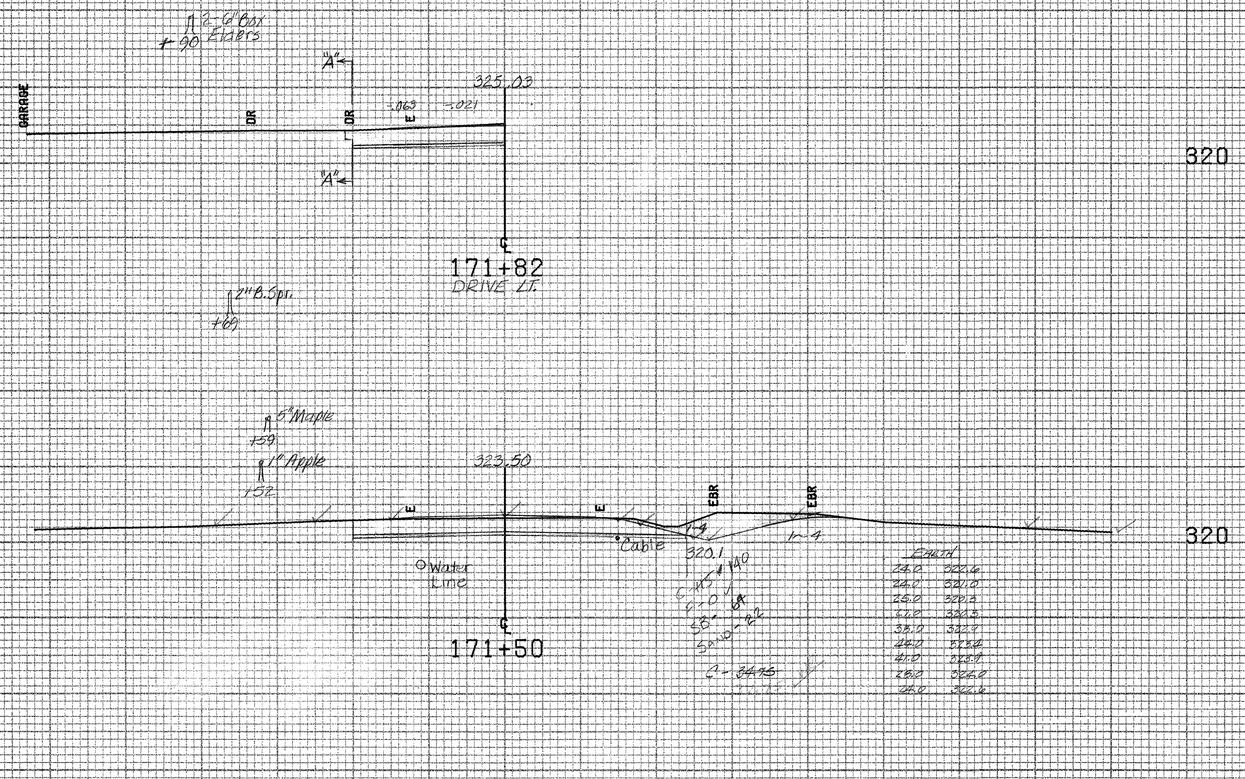

BRIDPORT MM 2.94 ~ MM 3.54

FROM STA.	171+00	TO STA.	171+82
PROJECT NAME	SHOREHAM-BRIDPORT-ADDISON MAIN		
NO.	F017-1(2)	PLOTTED	04/11/85
SURVEYED BY	BUSHEY		FEB 1985
SHEET 317 OF 420 SHEETS		SHEET 319 OF 477	

SCALE 10 FEET