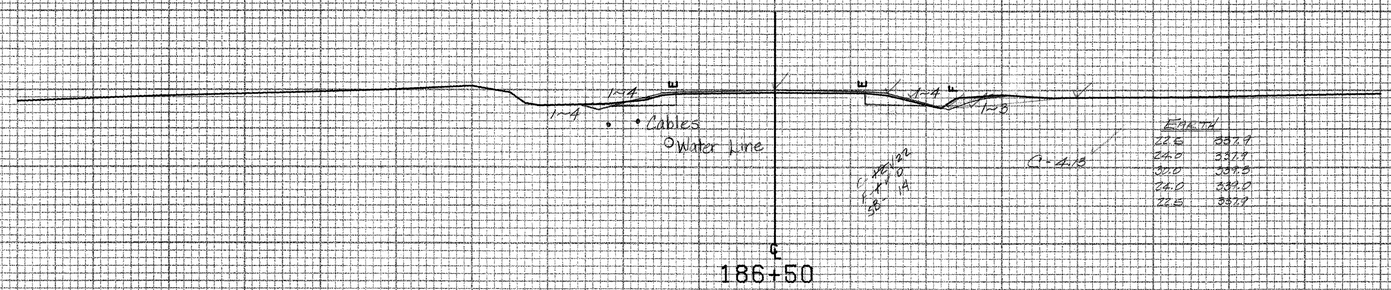

330

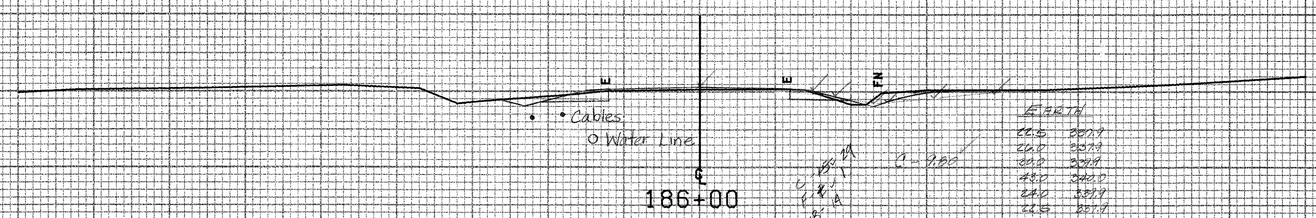

340

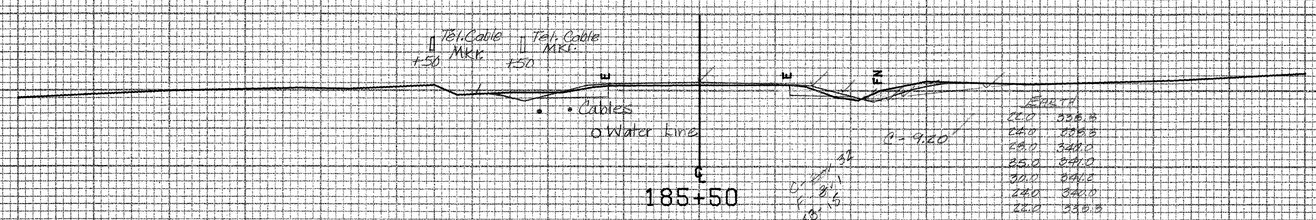

340

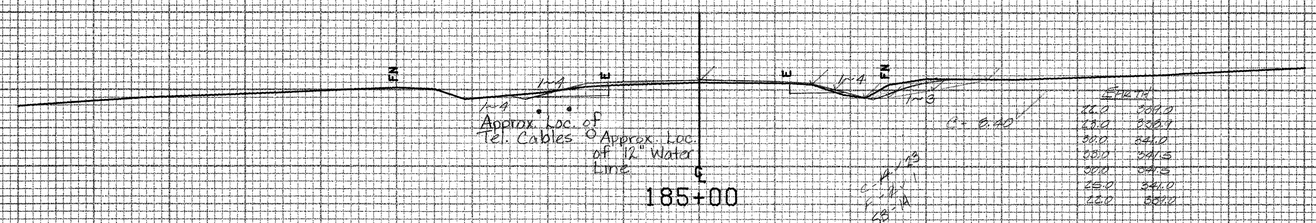

340

BRIDPORT MM 2.94 ~ MM 3.54

FROM STA. 185+00		TO STA. 186+50	
PROJECT NAME	SHOREHAM-BRIDPORT-ADDISON MAIN		
NO.	F017-1(2)		PLOTTED 04/11/85
SURVEYED BY	BUSHEY		FEB 1985
SHEET 330 OF 420 SHEETS			SHEET 330 OF 477

SCALE 10 FEET