FINAL SURVEY	SURVEYED	BY	DATE
	PLOTTED		
NOTE BOOK	TRAVERSE		
	AREAS		
No.	AREAS CHECKED		

ORIGINAL SURVEY	SURVEYED	Bond, J.T. Jr.	2/65
	PLOTTED	W. C. Sickles	8-71
NOTE BOOK	TRAVERSE	W. C. Sickles	8-71
	AREAS		
No.	AREAS CHECKED		

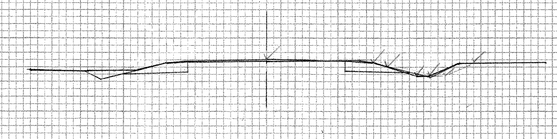

340

188+0

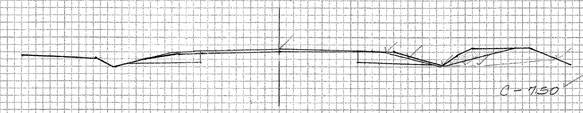

EARTH	
25.0	356.0
26.0	356.5
27.0	356.5
28.0	356.0

340

187+50

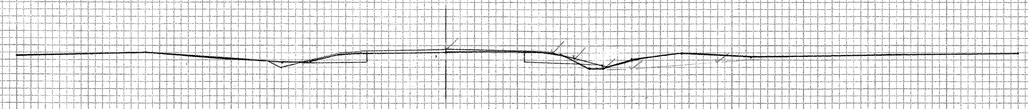

340

187+0

BRIDGPORT HES F 017-1(2)

ORIGINAL CROSS SECTIONS

STA. 187+00 THRU 188+00

SHEET A OF 477

PLATE 3 CROSS SECTION C. P. R. & R. E. STANDARD
DIETZGEN CORPORATION