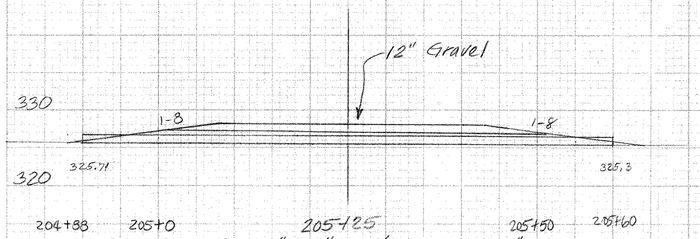


New 17"x 13"x 70' CSPA .064"

Section A-A

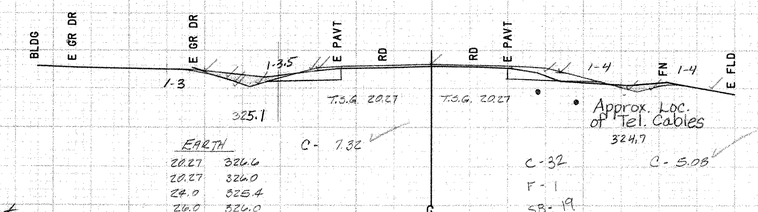


| EARTH | |
|---|---|
| 20.27 | 326.6 |
| 20.27 | 326.0 |
| 24.0 | 325.4 |
| 26.0 | 326.0 |
| 27.0 | 326.8 |
| 30.0 | 327.8 |
| 22.0 | 326.5 |
| 20.27 | 326.6 |

| EARTH | |
|---|---|
| 23.5 | 325.5 |
| 26.0 | 324.8 |
| 29.0 | 324.8 |
| 31.0 | 326.7 |
| 37.0 | 325.5 |
| 23.5 | 325.5 |

205+60 Lt
Begin Special Ditch
w/Erosion Matting

320

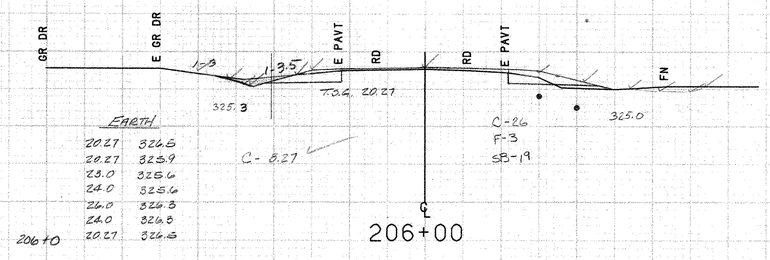


| EARTH | |
|---|---|
| 20.27 | 326.5 |
| 20.27 | 325.9 |
| 23.0 | 325.6 |
| 24.0 | 325.6 |
| 26.0 | 326.3 |
| 24.0 | 326.8 |
| 20.27 | 326.5 |

206+00 Rt
Begin Special Ditch
w/Erosion Matting

320

206+25 Rt
Begin Removing and Resetting Fence
Begin Temporary Barbed Wire Fence (4-strand)
BEGIN REMOVAL OF EXISTING FENCE

205+60 Rt
Construct Drive (14' wide gravel)

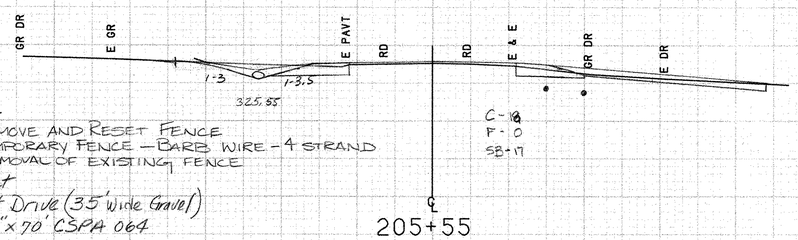


205+50 LT
BEGIN REMOVE AND RESET FENCE
BEGIN TEMPORARY FENCE — BARB WIRE - 4 STRAND
BEGIN REMOVAL OF EXISTING FENCE
205+25 Lt
Construct Drive (35' wide Gravel)
New 17"x13"x70' CSPA 064

320

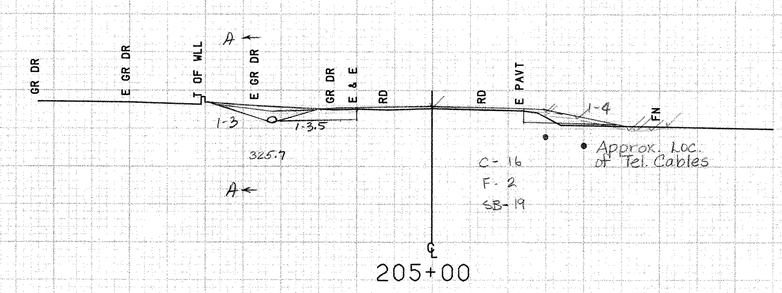


320

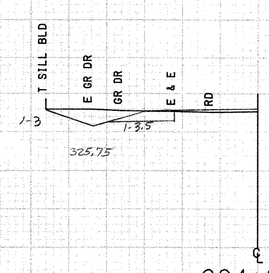


320

Bridport MM 3.86 ~ MM 4.06

| | | | |
|---|---|---|---|
| FROM STA. | 204+88 | TO STA. | 206+50 |
| PROJECT NAME | SHOREHAM-BRIDPORT-ADDISON | | |
| NO. | F017-1 (2) | PLOTTED | 05/27/88 |
| SURVEYED BY | MOREAU | 05/88 | 0130 |
| SHEET 337 OF 420 SHEETS | | SHEET 337 OF 477 | |

SCALE 10 FEET