27+00 =
229+06

27+00
C - 19
F - 12
SB - 17

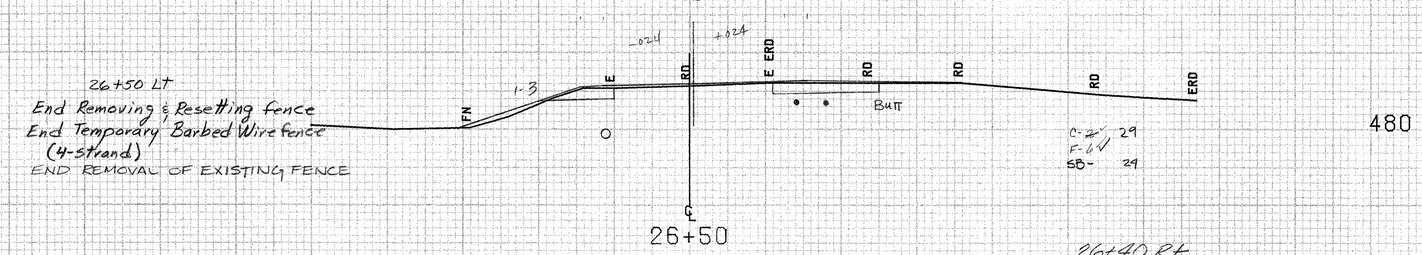

26+50 Lt
End Removing & Resetting fence
End Temporary Barbed Wire fence
(4-strand)
END REMOVAL OF EXISTING FENCE

C-~~2~~ 29
F-~~6~~ 4
SB- 29

480

26+40 Rt
Construct Approach TH #10

26+25 Lt.
End Special Ditch w/
Erosion Matting

48" E. Stump
(Remove)
+09

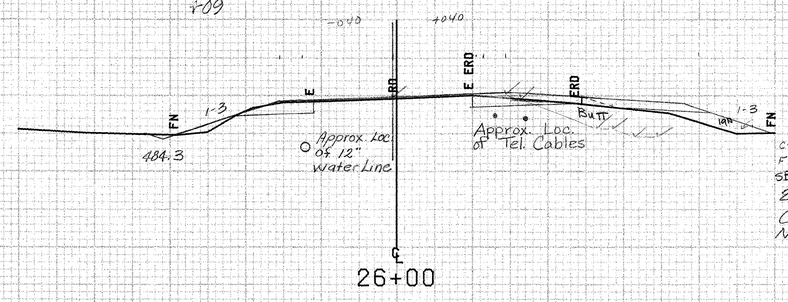

C-~~4~~ 29
F-~~5~~ 7
SB - 26

480

25+90 Rt
Construct Drive (12' Wide - Gravel)
New 19" x 13" x 30' CSP (.064)

BRIDPORT MM 4.24 ~ MM 4.34

SCALE 10 FEET

FROM STA. 26+00	TO STA. 26+50		
PROJECT NAME	SHOREHAM-BRIDPORT-ADDISON		
NO.	F017-1(2)	PLOTTED 02/14/84	
SURVEYED BY	FANTONI	JAN 1984	
SHEET 352 OF 420 SHEETS		SHEET 352 OF 477	