50

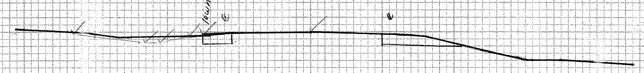

365+50

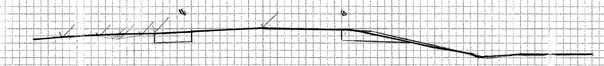

365+00

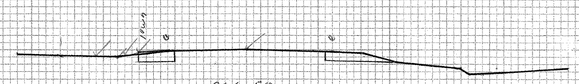

364+50

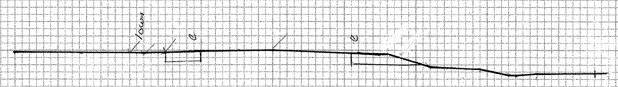

364+00

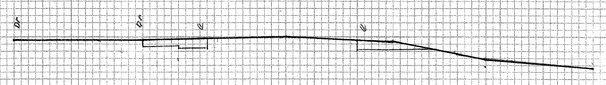

363+50

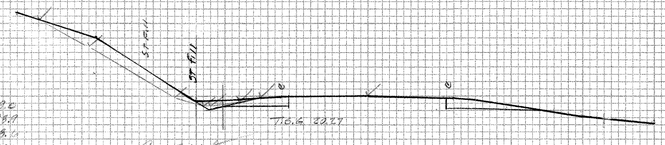

EARTH	
20.27	499.6
20.27	498.9
22.0	498.6
23.0	499.0
26.0	499.2
20.27	499.2
2.27	

368+00

EARTH	
20.27	500.3
20.27	498.8
22.0	498.4
23.0	499.4
26.0	500.1
20.27	500.3
7.42	

367+50

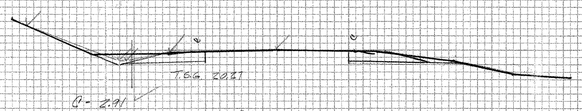

EARTH	
20.27	498.5
20.27	498.7
21.0	498.5
22.0	498.5
26.0	498.5
20.27	498.5
2.91	

367+00

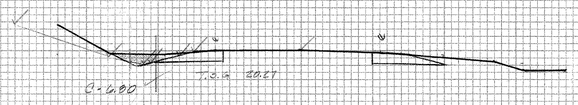

EARTH	
20.27	498.8
23.27	498.2
21.0	498.2
22.0	498.2
26.0	498.5
27.0	498.7
20.27	498.8
6.80	

366+50

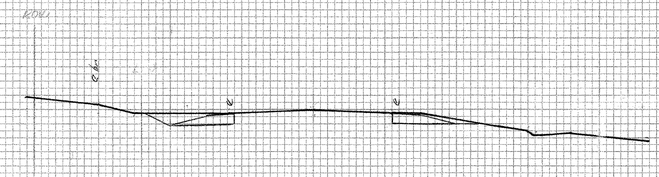

366+00

SHOREHAM-BRIDPORT-ADDISON
F 017-1(2)

363+50-368+00

PLATE 3 CROSS SECTION O. P. R. & R. E. STANDARD
DIETGEN CORPORATION

FINAL SURVEY	SURVEYED	BY	DATE
NOTE BOOK	PLOTTED		
No.	TEMPLATE		
	VERIFIED		
	AREAS		
	AREAS CHECKED		

ORIGINAL SURVEY	SURVEYED	BY	DATE
NOTE BOOK	PLOTTED		
No.	TEMPLATE		
	VERIFIED		
	AREAS		
	AREAS CHECKED		