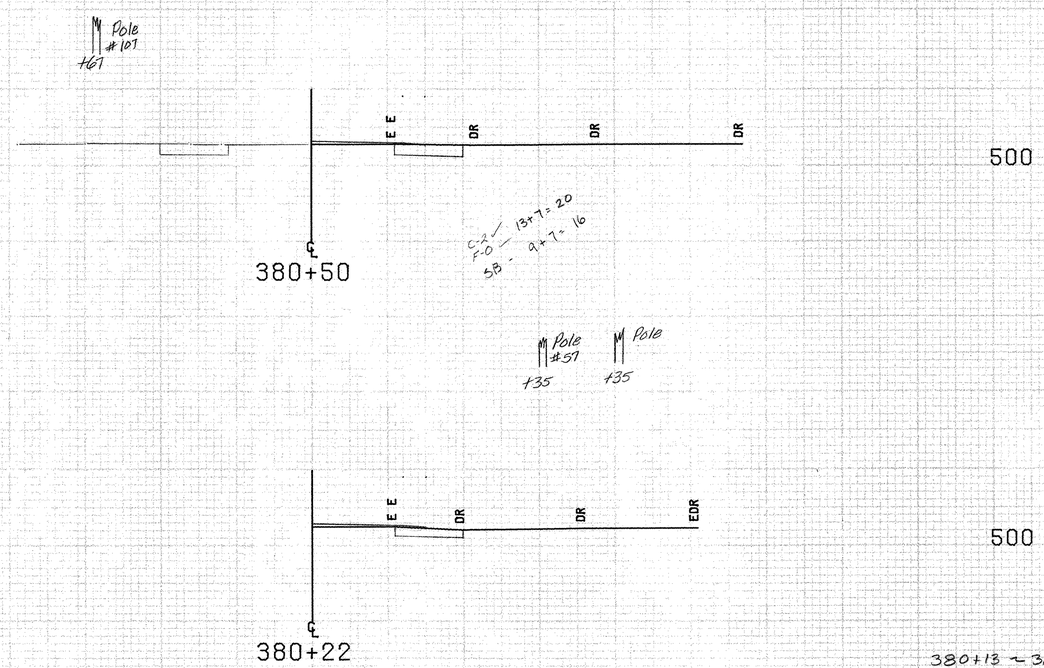

380+13 ~ 380+66 Rt
Removal & Disposal of Guide Posts

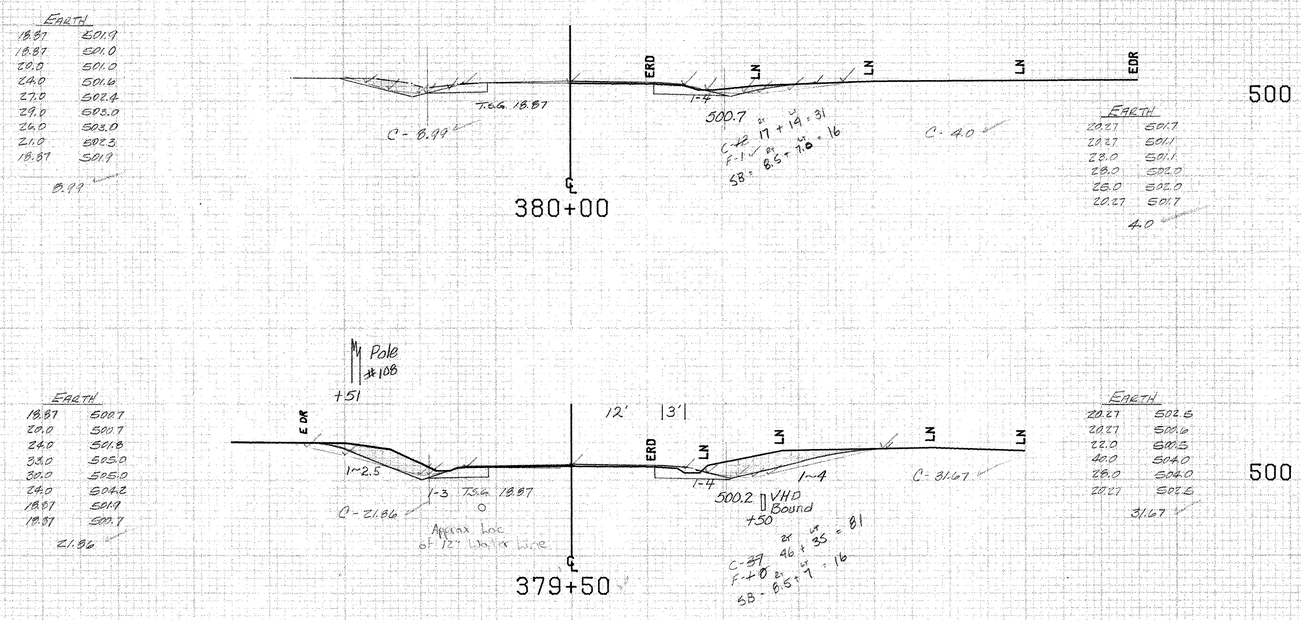

ADDISON MM 0.71 ~ MM 0.94

FROM STA. 379+50	TO STA. 380+50
PROJECT NAME	SHOREHAM-BRIDPORT-ADDI ON
NO.	F017-1(2) PLOTTED 03/13/84
SURVEYED BY	FANTONI FEB 84
SHEET 401 OF 420 SHEETS	SHEET 401 OF 477

SCALE 10 FEET