(4)

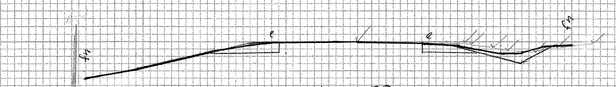

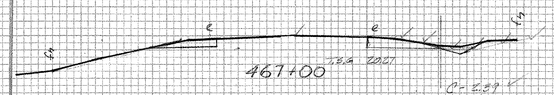

EARTH	
20.27	499.6
20.27	499.6
22.0	499.1
24.0	499.0
26.0	499.0
28.0	499.5
20.27	499.6

2.29

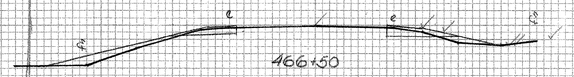

EARTH	
20.27	499.1
20.27	499.7
22.0	499.2
23.0	499.1
24.0	499.5
25.0	499.1
20.27	499.1

3.55

EARTH	
20.27	499.4
20.27	499.8
22.0	499.6
23.0	499.3
24.0	499.3
25.0	499.1
20.27	499.4

3.46

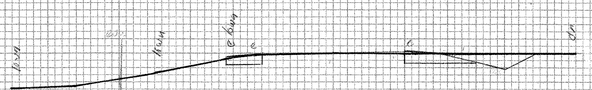

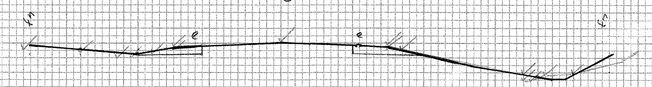

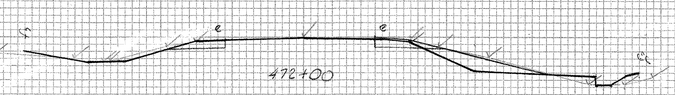

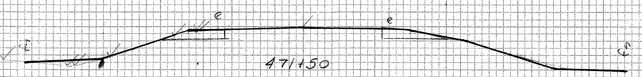

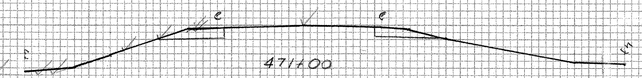

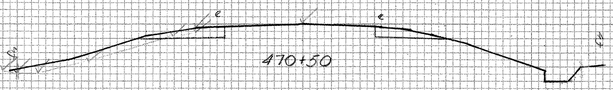

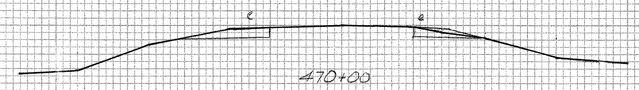

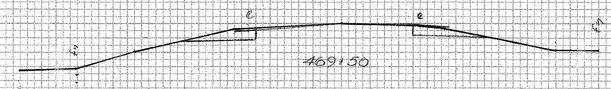

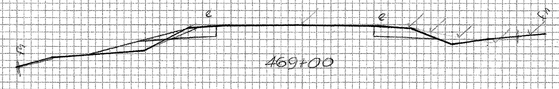

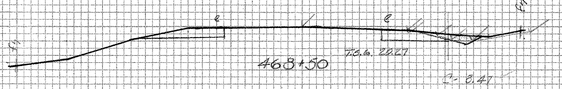

EARTH	
20.27	499.0
20.27	499.0
21.0	499.1
22.0	499.1
23.0	499.6
20.27	499.0

3.41

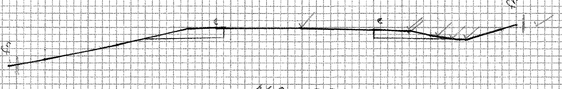

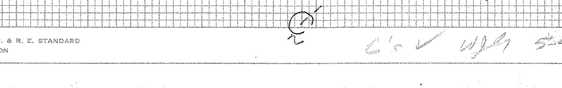

SHOREHAM-BRIDPORT-ADDISON
F017-1(2)

463+00 - 472+50

Sheet 404-Q of 477

PLATE 3 CROSS SECTION O. P. R. & R. E. STANDARD
DIETZGEN CORPORATION

FINAL SURVEY	SURVEYED	DATE
	PLOTTED	BY
	TRANSFERRED	
NOTE BOOK	AREAS	
No.	AREAS CHECKED	

ORIGINAL SURVEY	SURVEYED	DATE
	PLOTTED	BY
	TRANSFERRED	
NOTE BOOK	AREAS	
No.	AREAS CHECKED	