FINAL SURVEY	SURVEYED ___ PLOTTED ___ TRACED ___ AREAS ___ AREAS CHECKED ___	BY	DATE
NOTE BOOK No. ___			

ORIGINAL SURVEY	SURVEYED ___ PLOTTED ___ TRACED ___ AREAS ___ AREAS CHECKED ___	BY	DATE
NOTE BOOK No. ___			

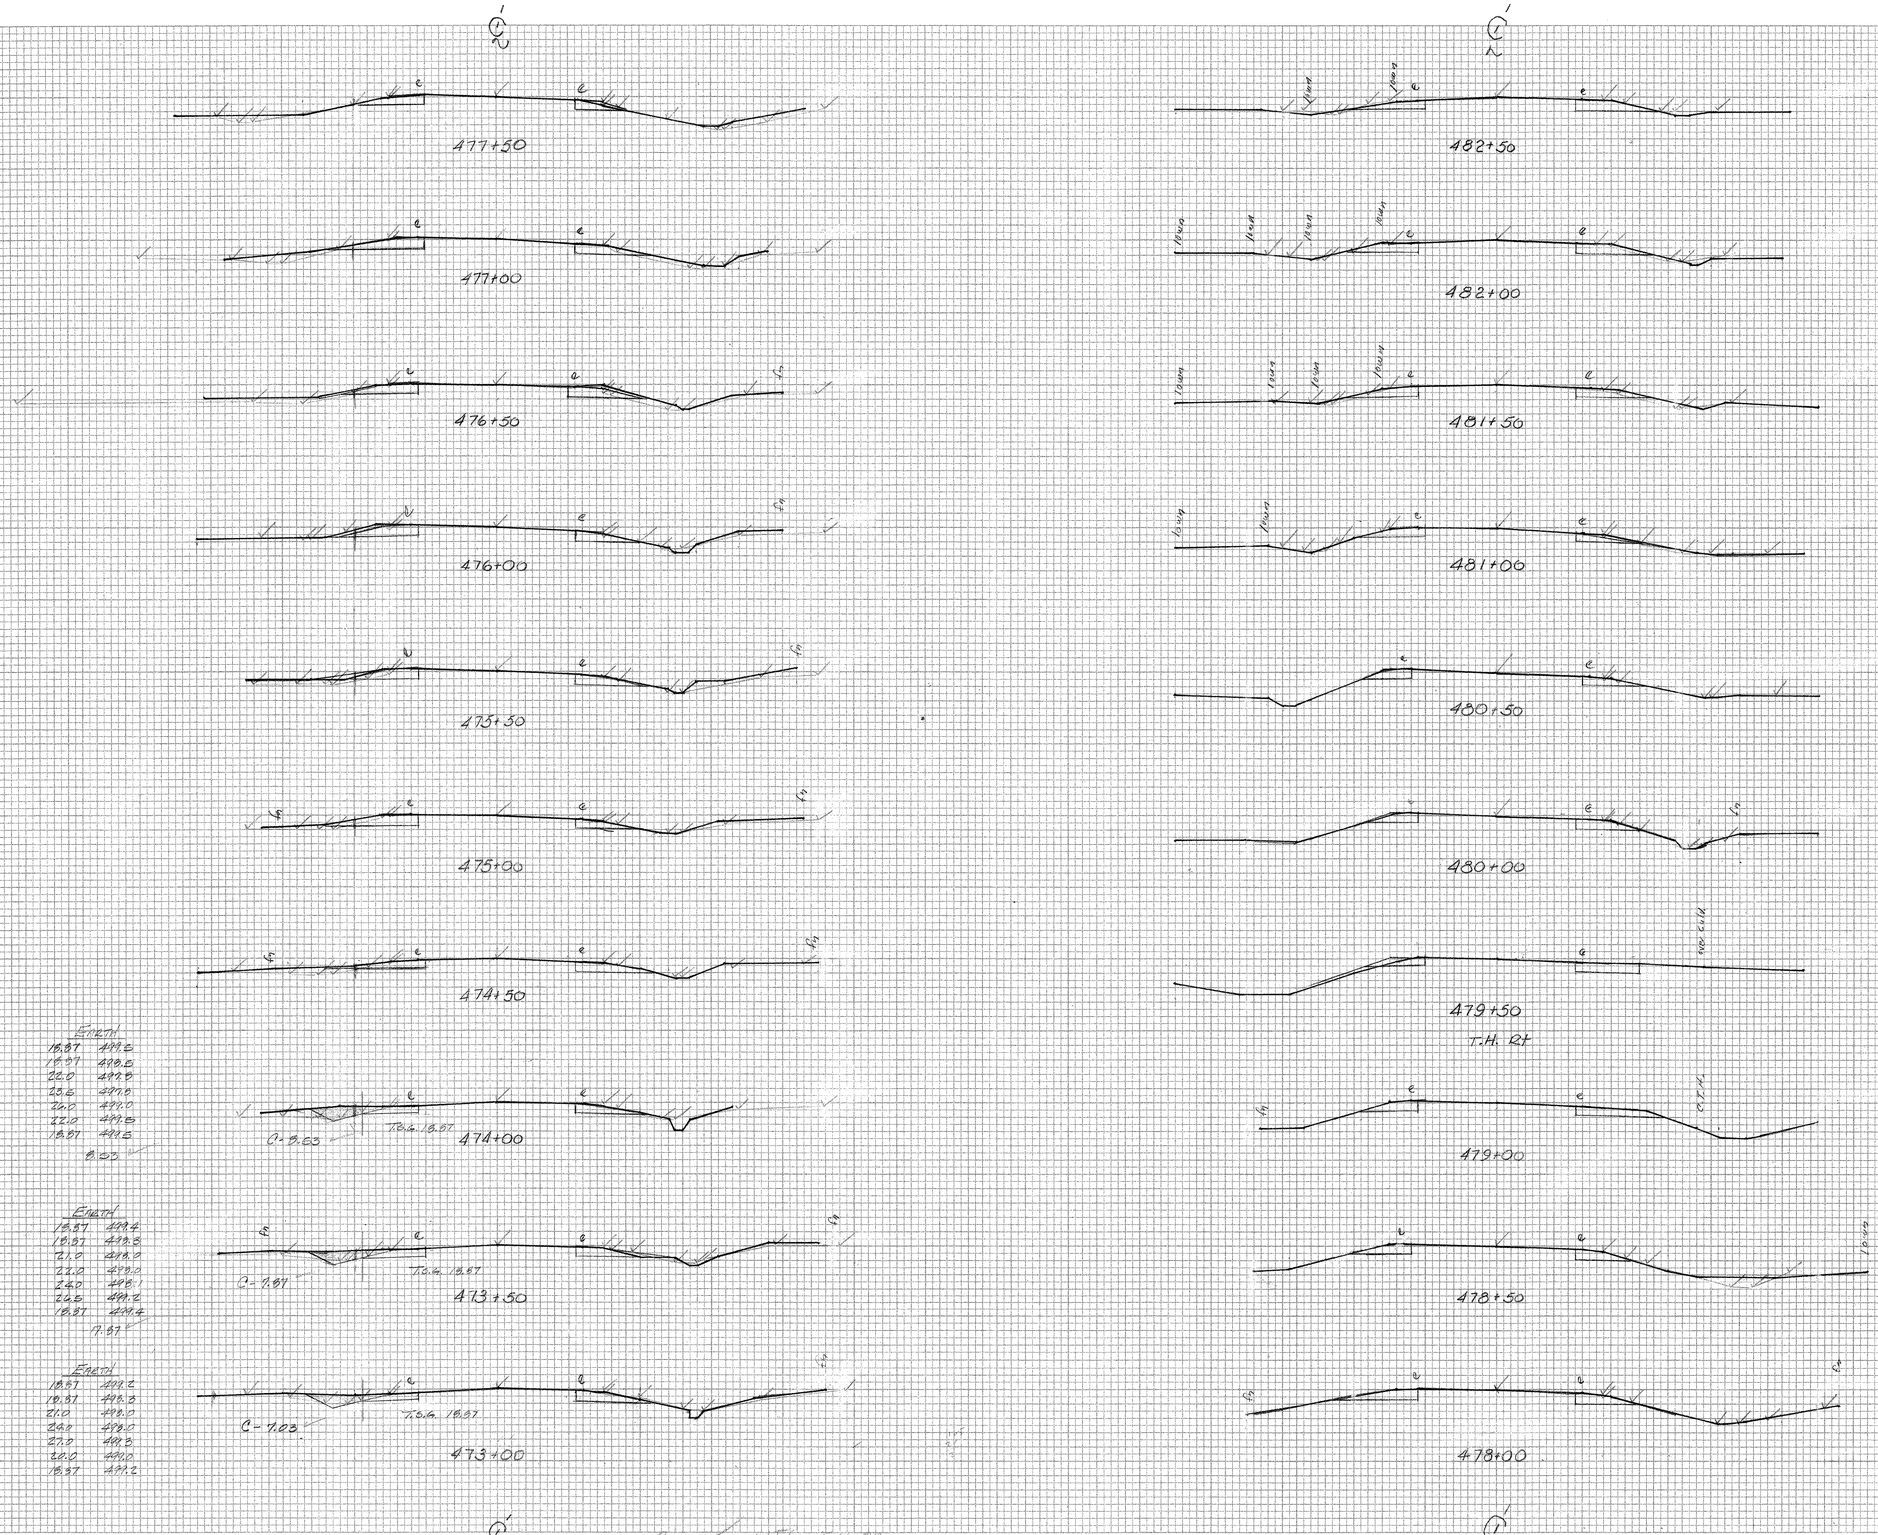

PLATE 3 CROSS SECTION O. P. R. & R. E. STANDARD
DIETZGEN CORPORATION

SHOSHIAW-BRIDPORT-ADDISON
F 017-1 (2)

473+00-482+50

Sheet 401-R of 477