


PLAN	DATE
SURVEYED	BY
ALIGNED	
PLOTTED	
NOTE BOOK	
NO.	

DATUM
 VERTICAL NGVD 1929
 HORIZONTAL N/A

PROFILE	DATE
SURVEYED	BY
B.M. NOTED	
GRADES CHECKED	
STRUCTURE NOTING OK'D	
NOTE BOOK	
NO.	

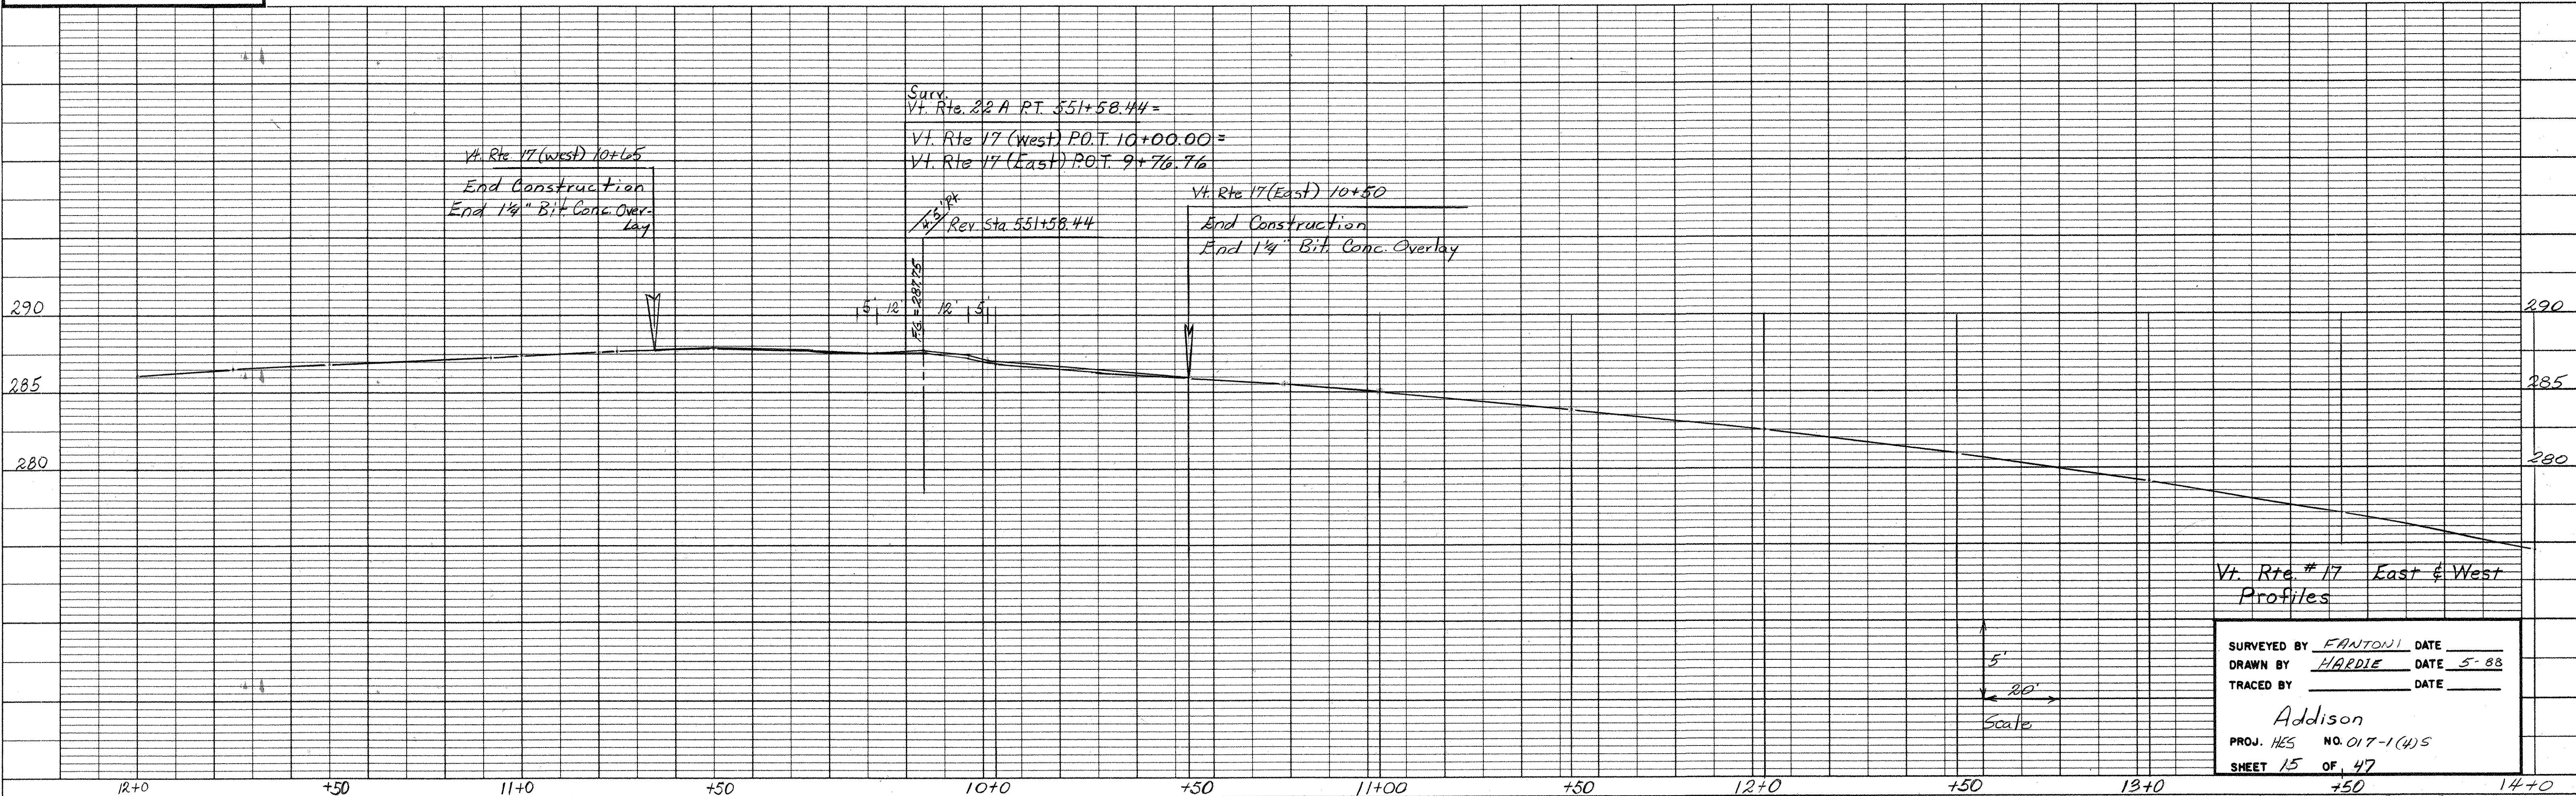

SURVEYED BY FANTONI DATE _____
 DRAWN BY HARDIE DATE 5-88
 TRACED BY _____ DATE _____
 Addison
 PROJ. HES NO. 017-1(4)5
 SHEET 15 OF 47
 SHEET 445 OF 477