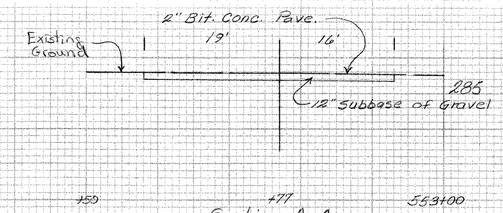

Section A-A

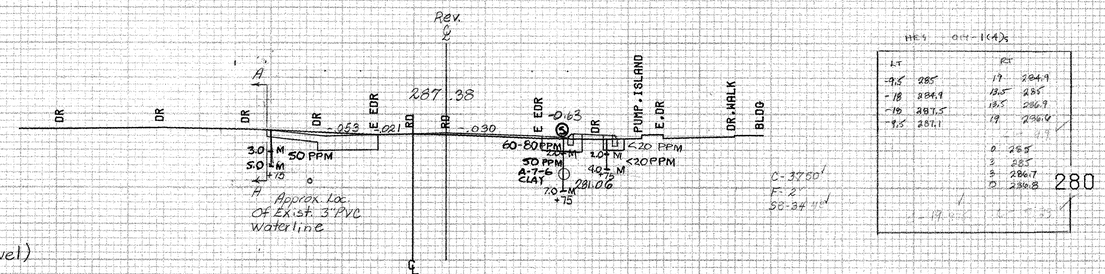

HES 017-1(4)S			
LT		RT	
-9.5	285	19	284.9
-18	284.9	13.5	285
-18	287.5	13.5	286.9
-9.5	287.1	19	286.8
		0	285
		3	285
		5	286.7
		0	286.8

Rev. 552+75 Lt.
Construct Drive 40' Wide (Gravel)

Rev 552+53 Lt.
End Durable 12" Yellow Lines (Painted Island)

HES 017-1(4)S			
LT		RT	
-10.5	285.2	19	284.9
-18	285	12	285
-18	287.7	12	287.6
-10.5	287.3	19	287.1

F017-1(2)	
EXPRWAY	℄ REC
12	283.2
0	283.5
-12	283.2
-12	287.4
0	287.5
12	287.6

F017-1(2)	
SB	RT –
	LT –
SAND	RT +
	LT –

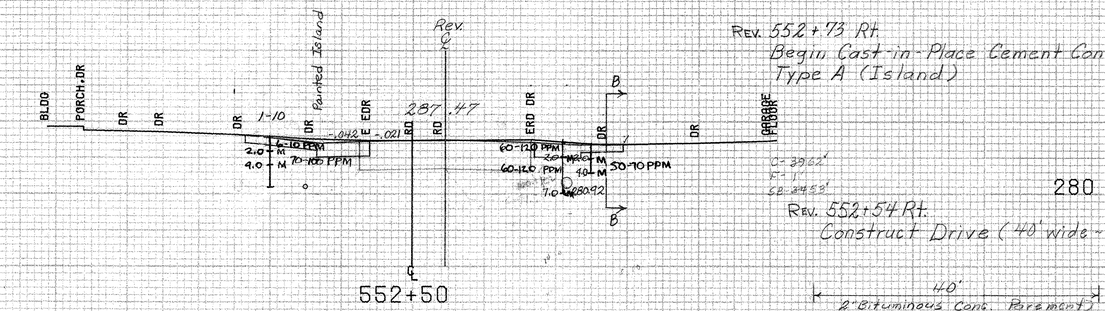

Rev. 552+73 Rt.
Begin Cast-in-Place Cement Concrete Curb, Type A (Island)

Rev. 552+54 Rt.
Construct Drive (40' wide - Paved)

LT		RT	
-10.5	285.2	19	284.9
-18	285.1	11.5	285
-18	287.5	11.5	286.9
-10.5	287.3	19	286.5

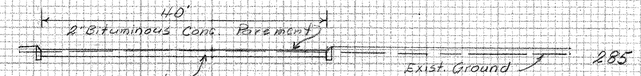

Section B-B

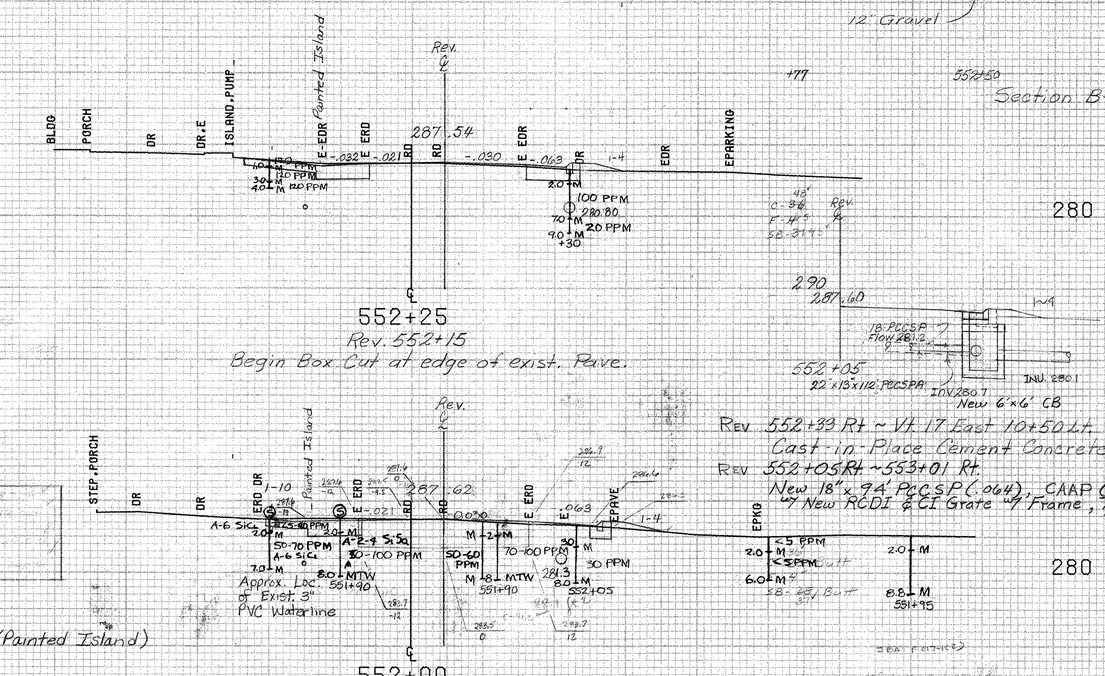

LT		RT	
-11.5	285.2	28.5	284.8
-19	285	28.5	284.8
-19	287.6	28.5	286.6
-11.5	287.6	28.5	286.3

F017-1(2)	
SB	LT –
	LT –
SAND	RT +
	LT –

Rev 552+33 Rt ~ Vt. 17 East 10+50 Lt.
Cast-in-Place Cement Concrete Curb, Type A

Rev 552+05 Rt ~ 553+01 Rt.
New 18" x 94' PCCSP (.064), CMAP (0.060) or RCP (III) OPTION
w/ New RCDI & CI Grate w/ Frame, Type D

Rev 551+91 Lt
Begin Durable 12" Yellow Lines (Painted Island)

HES 017-1(4)S

SHEET 470 OF 477

FROM STA.	552+00	TO STA.	552+77
PROJECT NAME	ADDISON VT22A		
NO.	HES017-1(4)S		PLOTTED 11/29/84
SURVEYED BY	FANTONI		SEPT 1984
SHEET 80 OF 47 SHEETS			

SCALE 10 FEET