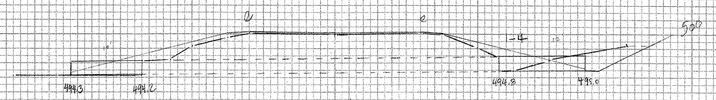

204+48 - 24" CGMP

EXTEND INLET W/ 24" x 12' CSP

EXTEND OUTLET W/ 24" x 10' CSP

SEE BK 2B Pg. 127 D038

TRENCH EARTH:

UNDER CUT ½ x 22 x 4.3 / 27 =

STONE PAD 5 x 5 x 1.5 / 27 =

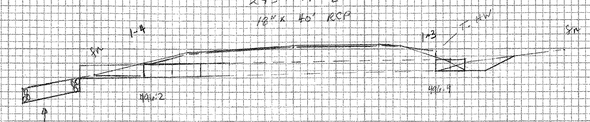

245+41 ℄

18" x 40' RCP

8x6' TYPE I STONE FILL PAD

REMOVE 4' @ INLET (NO GOOD) REMOVE TOP 2' OF HW @ INLET

REMOVE & RELAY 4' FROM OUTLET TO INLET (4' from yard)

EXTEND OUTLET 18' 12' 4/8/91 KBR

SEE BK 2C Pg 63 D0455

199+48 @ 60° RT 15" RCP

RELAY 4' (1 SECT) AT OUTLET

EXTEND OUTLET 18" x 7' CSP W/ STONE FILL TYPE II PAD OUTLET (6'x10')

SEE BK # 2B Pg 115 D0370

TRENCH EARTH:

UNDER CUT ½ [(4')(3.4') + (6' x 3.6')] / 27 =

STONE PAD 6' x 10' x 1.5' / 27 =

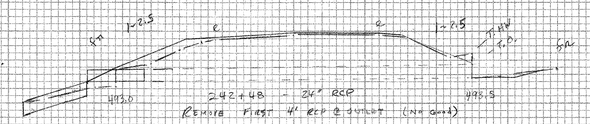

242+48 - 24" RCP

REMOVE FIRST 4' RCP @ OUTLET (NO GOOD)

REMOVE TOP 1' OF INLET HEADWALL

EXTEND OUTLET 24" x 8' RCP W/ 8x6' STONE FILL TYPE I PAD

SEE BK 2C Pg 57 D0450

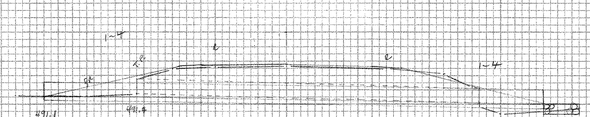

169+70 85° RT 24" x 48' CMP

REPLACE W/ NEW 24" x ~~60'~~ 70' PCCSP

5x5' TYPE I STONE FILL PAD OUTLET

SEE BK # 2B Pg 67 D0330

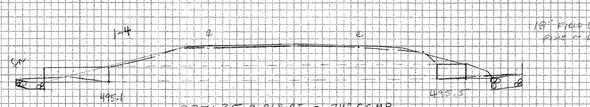

18" FIELD DRIVE PIPE ~ RETAIN

227+35 @ 86° RT - 24" CGMP

EXTEND INLET W/ 24" x 5' CSP W/ CSPES & 4x10' STONE FILL (TYPE II) PAD

EXTEND OUTLET W/ 24" x 10' CSP W/ STONE FILL TYPE I PAD 4 x 10

SEE BK # 2C Pg. 25 D0420

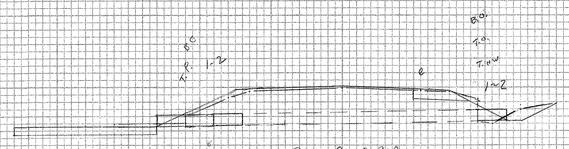

CONSTRUCT 26' x 12' SPECIAL DITCH (STONE FILL, TYPE I) SEE TYPICAL ON LAYOUT SHEETS

262+91 @ 90°

18" RCP

REMOVE 4' RCP @ OUTLET (NO GOOD)

REMOVE & RELAY 4' RCP FROM OUTLET TO INLET

REMOVE TOP 2' HW INLET

EXTEND OUTLET 12'

SEE BK 2C Pg. 91 D0490

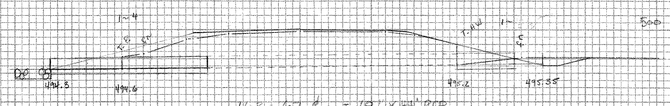

163+67 ℄ - 18" x 44' RCP

REMOVE & RELAY ~~12'~~ 8' (3 SECTIONS) FROM OUTLET TO INLET

EXTEND OUTLET W/ 24" x ~~23'~~ 19' WITH 5'x5' STONE FILL, TYPE I PAD

SEE BK 2B Pg. 61 D0325

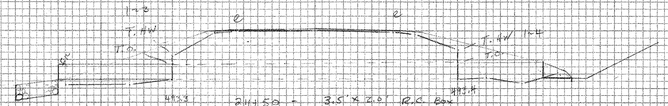

244+50 - 3.5' x 2.0' R.C. BOX

EXTEND INLET W/ 43" x 24" x 13' SPA W/ FS

EXTEND OUTLET W/ 43" x 24" x 17' CSPA W/ STONE FILL TYPE I PAD

SEE BK 2B Pg. 133 D0385

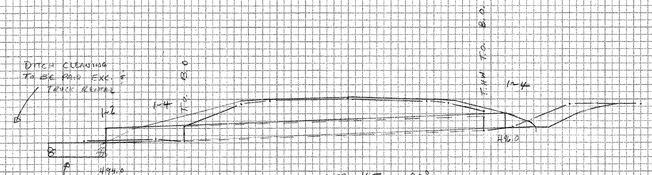

8x6 STONE FILL TYPE I PAD

259+45 @ 90°

24" ARCGMP - REPLACE

NEW 24" x 56' PCCSP W/ CSPES @ INLET

SEE BK 2C Pg. 83 D0480

PAD TYPICAL

SHOREHAM - BRIDPORT - ADDISON

F 017 - 1(2)

DRAINAGE SHEET NO. 3 OF 11

FINAL SURVEY NOTE BOOK No. SURVEYED PLOTTED TEMPLATE AREAS AREAS CHECKED BY DATE

ORIGINAL SURVEY NOTE BOOK No. SURVEYED PLOTTED TEMPLATE AREAS AREAS CHECKED BY DATE

PLATE 3 CROSS SECTION O. P. R. & R. E. STANDARD DIETZGEN CORPORATION

42+25

492