FINAL SURVEY	SURVEYED	BY	DATE
NOTE BOOK	PLOTTED		
	TEMPLATE		
	AREAS		
No.	AREAS CHECKED		

ORIGINAL SURVEY	SURVEYED	BY	DATE
NOTE BOOK	PLOTTED		
	TEMPLATE		
	AREAS		
No.	AREAS CHECKED		

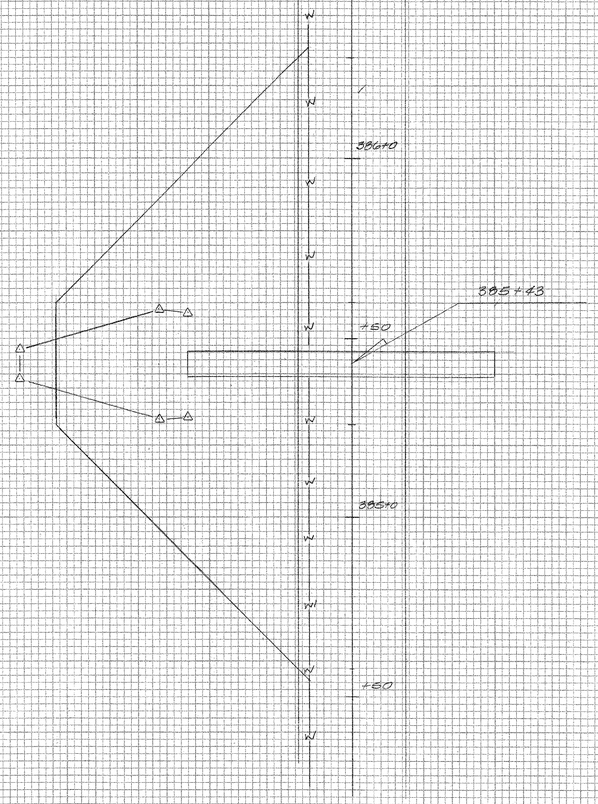

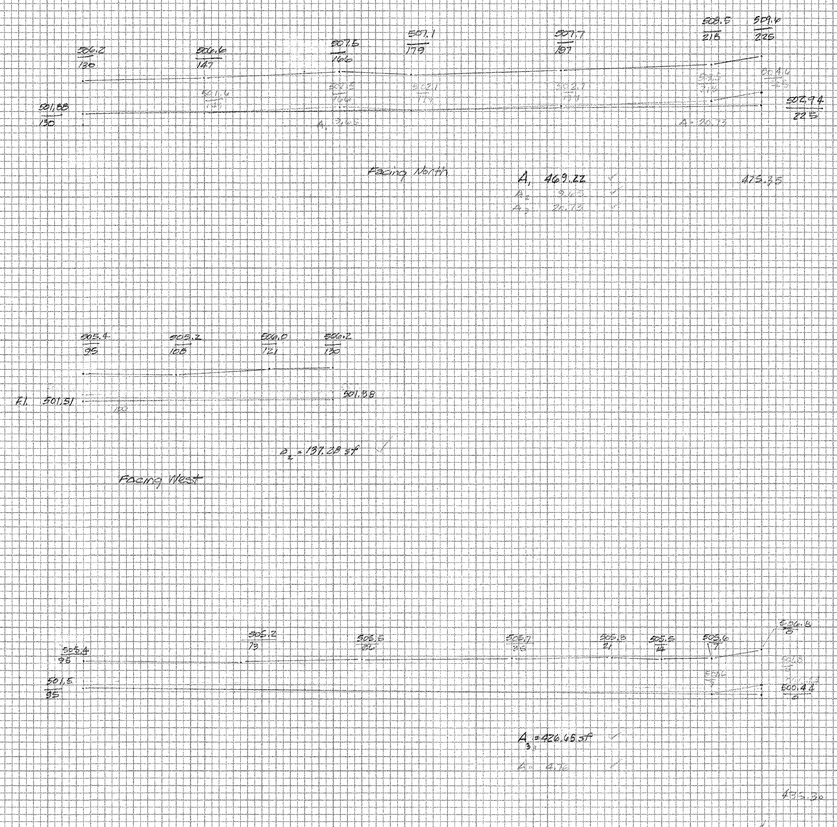

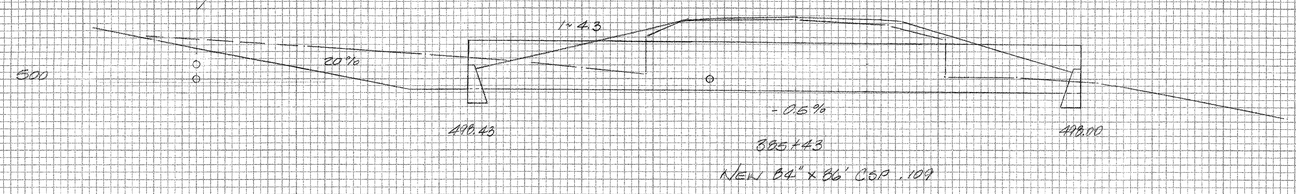

Trench Excav Earth

469.22
137.28
426.65
1033.15 sf x 3.1 = 3200.77 cf

3200.77 / 27 = 124.7 cy

SHOREHAM - BRIDPORT - ADDISON
F 017-1(2)

Drainage Sheet No 11 OF 11

PLATE 3 CROSS SECTION D. P. R. & R. E. STANDARD
DIETZGEN CORPORATION