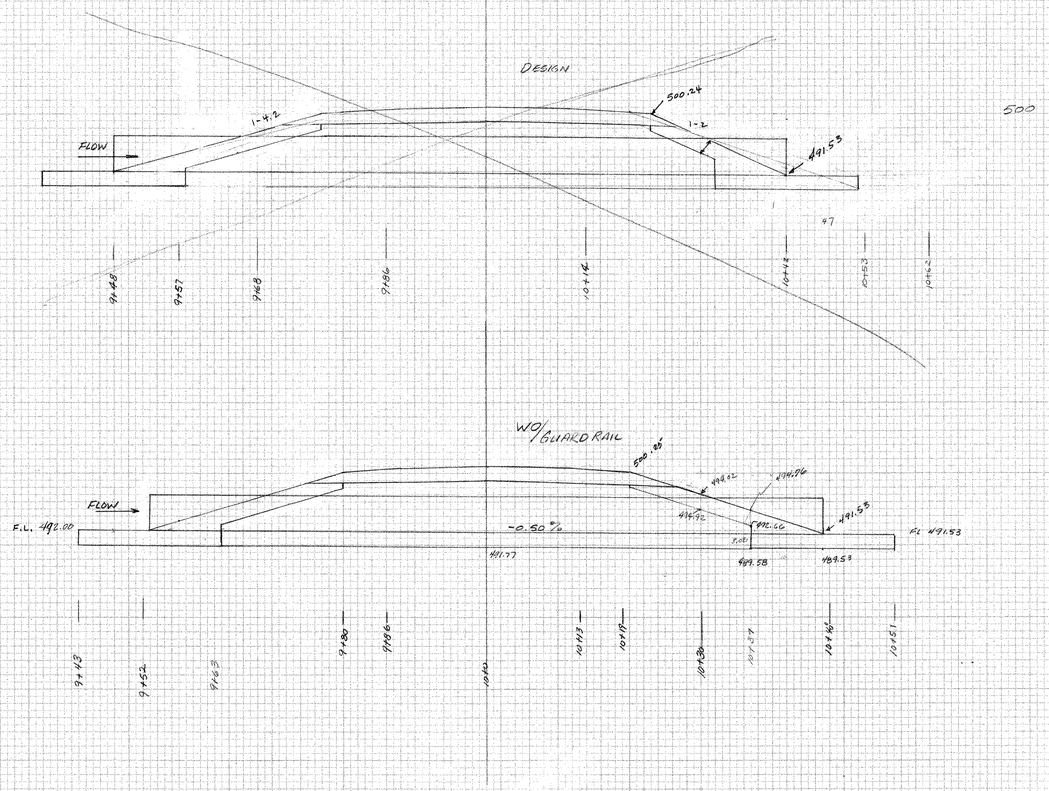

EXCAVATION

by Ave. End Area

6-22-91

STA.	DIST.	UNCLASS. CHANNEL PLACE SF	VOL, cu ft	STRUCTURE EXCAVATION SF	VOL, cu ft	GEOTX BREAK SF	FOL WEIGHT VOL, cu ft
9+43		34.8		—		—	
	9		337.15				
9+52		37.9		86.3		46	
	28				2248.4		1288
9+80		—		94.3		46	
	6				659.5		276
9+86		—		92.2		46	
	14				1288.7		644
10+00		—		91.9		46	
	13				1198.6		598
10+13		—		92.5		46	
	6				531.3		276
10+19		—		86.6		46	
	11				826.7		506
10+30		—		85.7		46	
	18				1289.7		828
10+48		11.0		77.6		46	
	9		285.75				
10+57		52.5		—		—	
Total, cu ft			612.9 / 27		7942.9 / 27		4410 / 27
Total, cy			22.7		294.18		163.6

SHORE RIVAL - BRIDPORT - ADDISON
F 017-1(12)

BRIDGE 1
BRIDGE SHEET 1 OF 3

506

Keuffel & Esser Company PLATE 3, CROSS SECTIONS 47058 Made in U.S.A.