
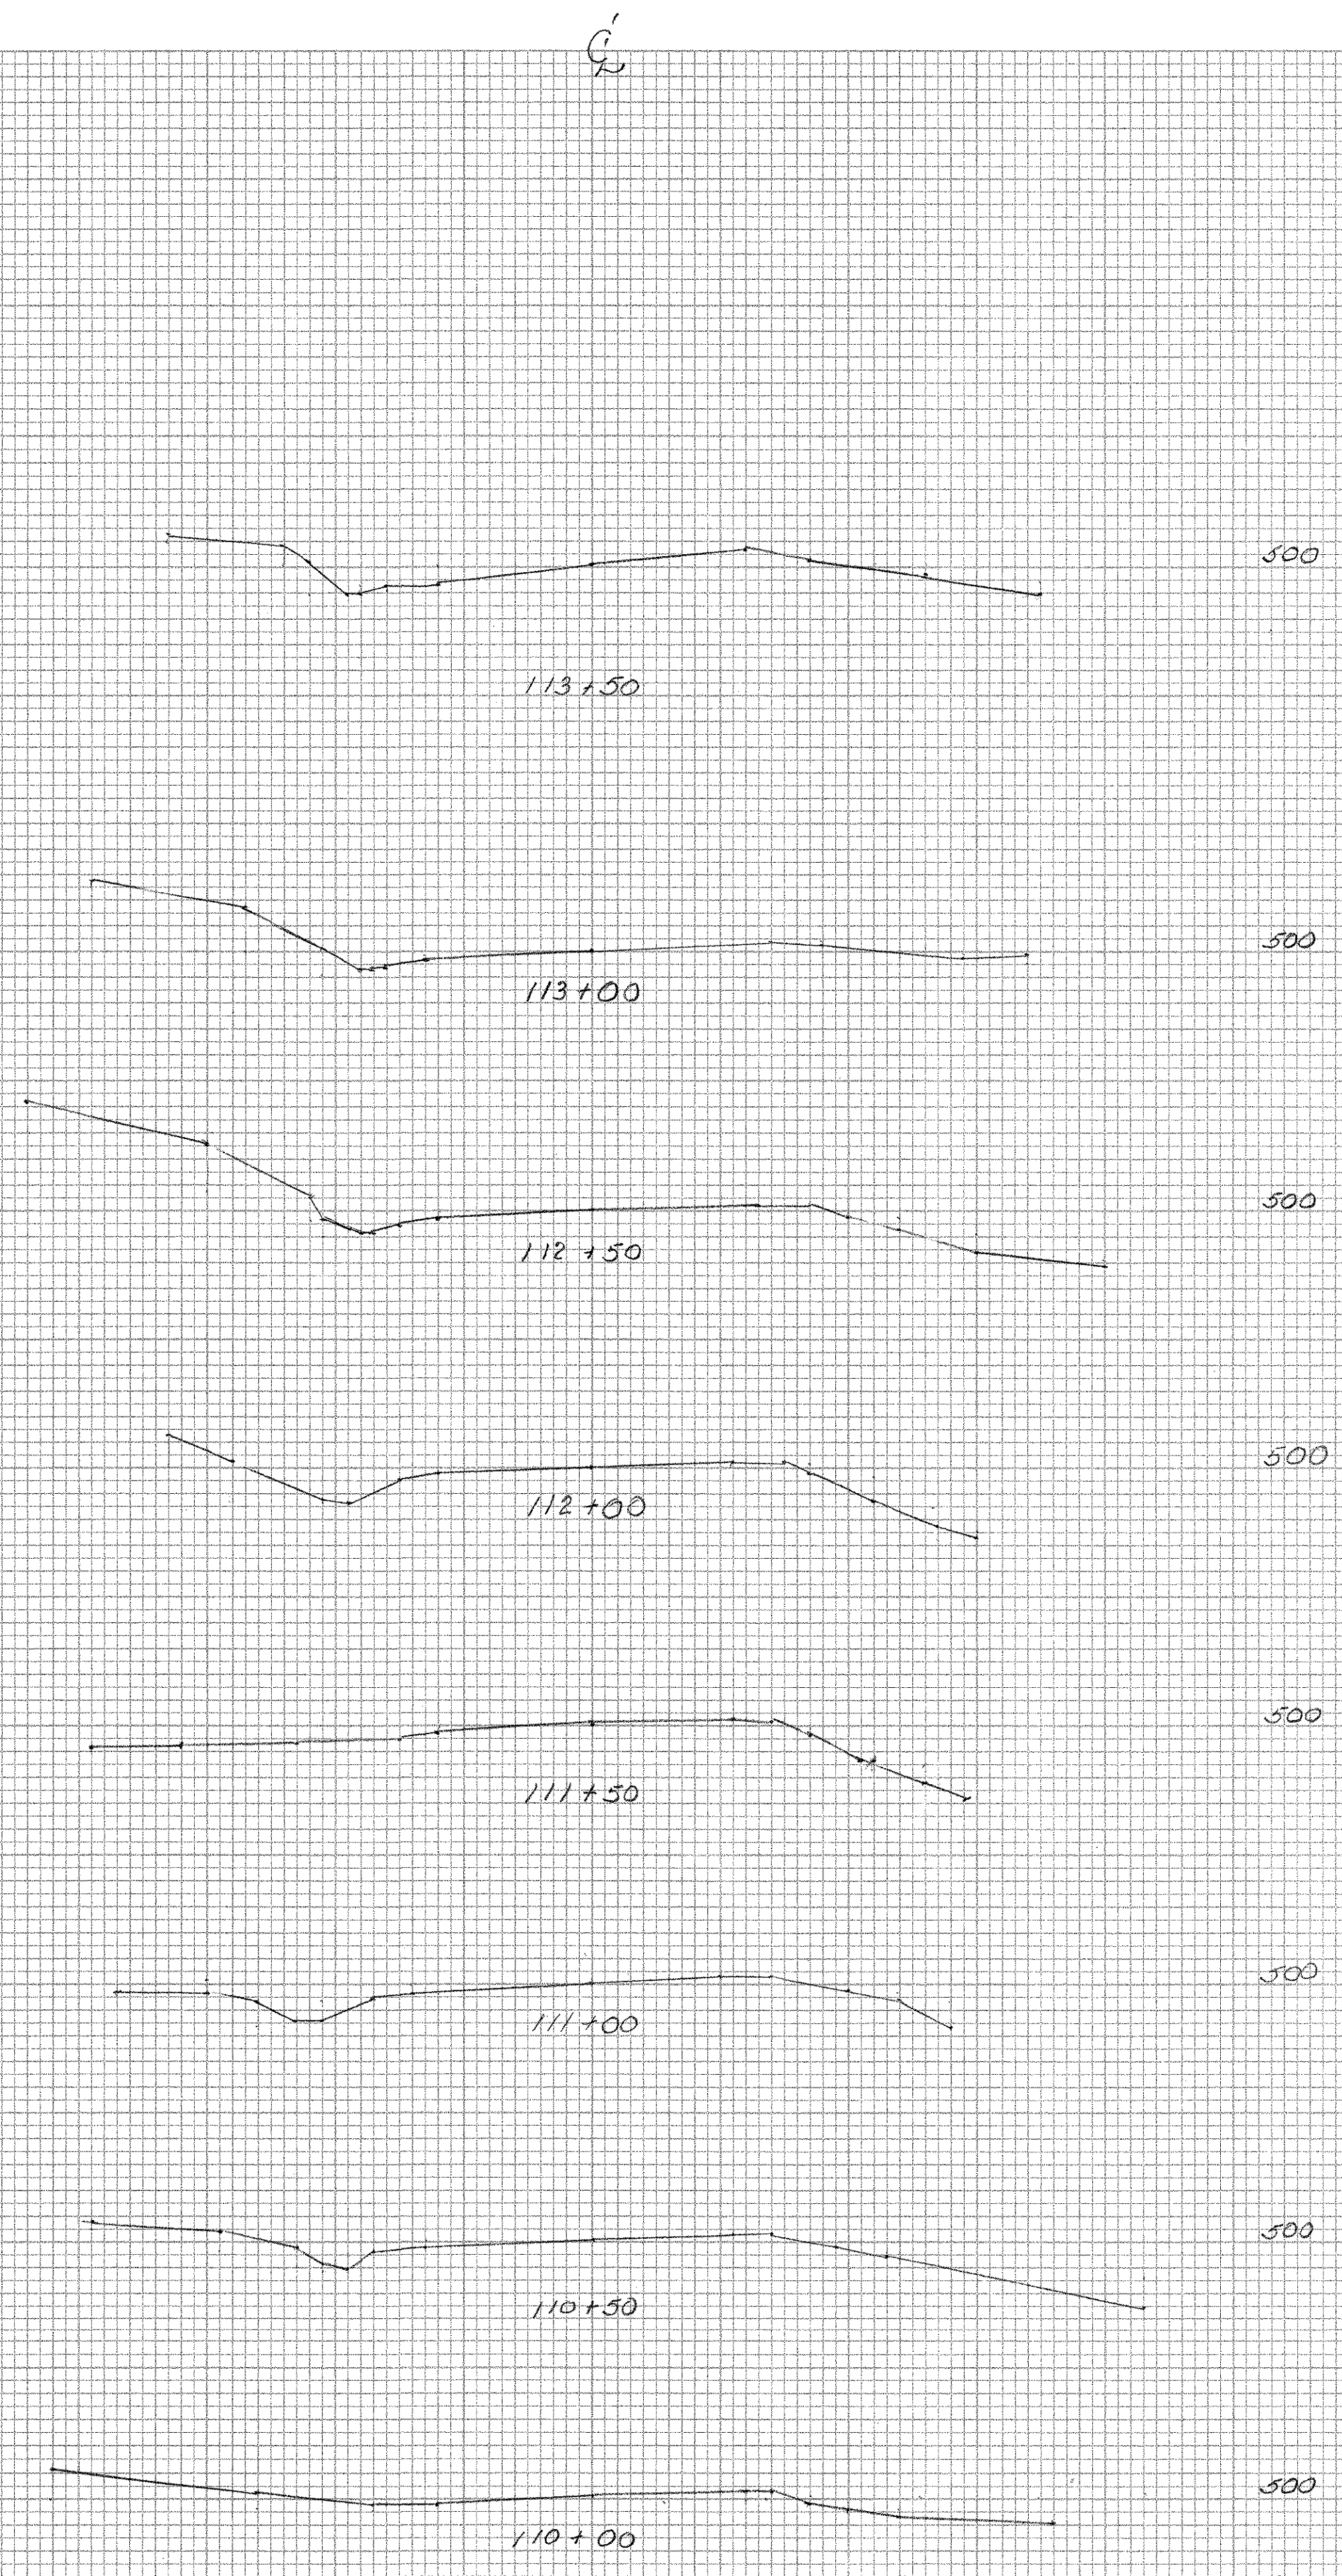


DATE	
BY	
SURVEYED	
TEMPLATE	
AREA	
AREA CHECKED	
FINAL SURVEY NOTE BOOK NO.	

DATE	
BY	
SURVEYED	
TEMPLATE	
AREA	
AREA CHECKED	
ORIGINAL SURVEY NOTE BOOK NO.	

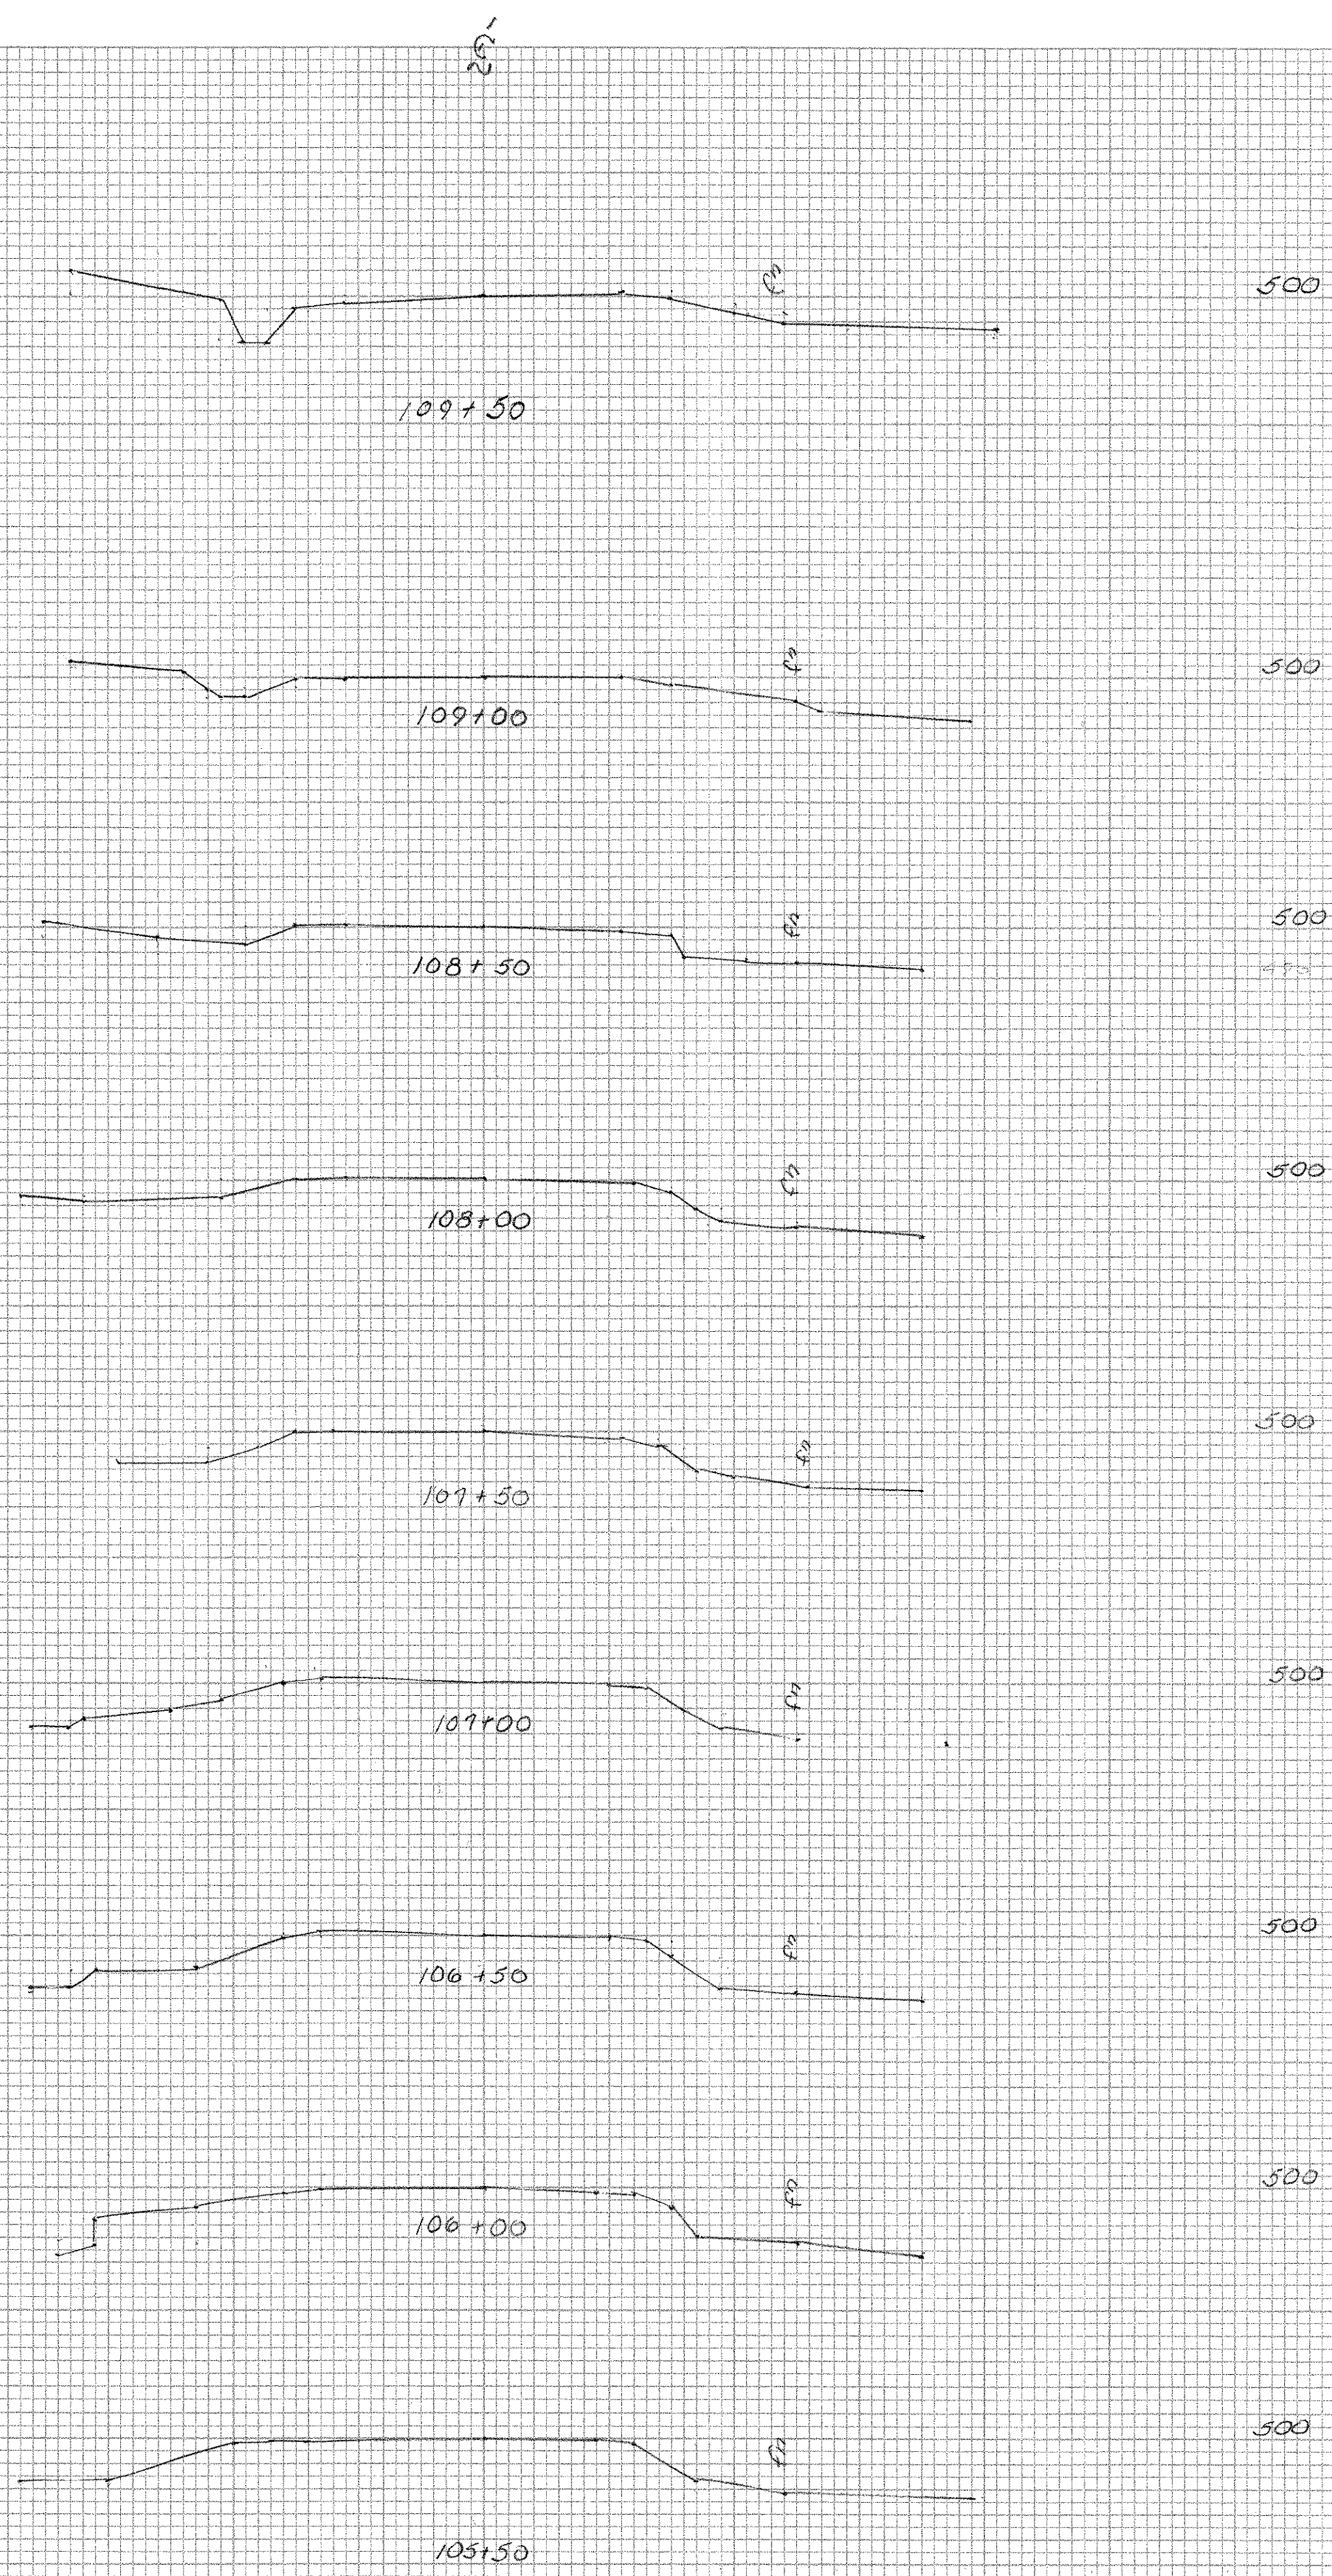

SHOREHAM BRIDGEPORT ADDITION
 F 017-1 (R)
 Original Sections